

# PROPOSED MODIFICATIONS

## NORTH YORKSHIRE COUNTY COUNCIL

### WILDLIFE AND COUNTRYSIDE ACT 1981

#### THE FORMER WEST RIDING OF YORKSHIRE AREA 2 DEFINITIVE MAP AND STATEMENT

#### FOOTPATH No. 35.64/28 EASTERN END OF TADCASTER VIADUCT TO WIGHILL LANE, TADCASTER MODIFICATION ORDER 2013

This order is made by North Yorkshire County Council under Section 53(2)(b) of the Wildlife and Countryside Act 1981 ("the Act") because it appears to the authority that the Former West Riding of Yorkshire Area 2 Definitive Map and Statement require modification in consequence of the occurrence of an event specified in Section 53(3)(b) namely the expiration, in relation to any way in the area to which the map relates, of any period such that the enjoyment by the public of the way during that period raises a presumption that the way has been dedicated as a public path or restricted byway.

The authority have consulted with every local authority whose area includes the land to which the order relates. The North Yorkshire County Council hereby order that:

1. For the purpose of this Order the relevant date is 1 September 2013.
2. The Former West Riding of Yorkshire Area 2 Definitive Map and Statement shall be modified as described in Part I and Part II of the Schedule and shown on the map attached to the Order.
3. This Order shall take effect on the date it is confirmed and may be cited as the Footpath No. 35.64/28 Eastern End of Tadcaster Viaduct to Wighill Lane, Tadcaster Modification Order 2013.

THE COMMON SEAL of NORTH  
YORKSHIRE COUNTY COUNCIL  
was hereunto affixed this 25 day of  
September 2013 in the presence of:

*M S GSC*



SCHEDULE

PART I

Modification of Definitive Map

Description of path or way to be added


Section of footpath as shown on the map	Description
Indicated on the Order map and marked as A - <del>B</del> C - D	Starting at the eastern end of the viaduct at Grid Reference <del>44851 44387</del> <sup>445307 443876</sup> (POINT A) the 2 metre wide path runs generally north east along the northern side of, but not in, the wooded area for approximately 190 metres to Grid Reference 44865 44399 (POINT B) from where it heads north west for approximately 5 metres to Grid Reference 44865 44399 (POINT C) from where it heads north east for approximately 4 metres to Grid Reference 44865 44399 (POINT D) where it meets the publicly maintainable road known as Wighill Lane via a gap in the wall.

PART II

Modification of Definitive Statement

Variation of Particulars of path or way

Path No.	Grid Reference End Points	Description	Nature of Surface	Length	Width	Lawful Obstructions And Conditions
Footpath no. 35.64/28	<del>44851 44387</del> <sup>445307 443876</sup> (Start)  To  44865 44399 (End)	Starting at the eastern end of the viaduct at Grid Reference <del>44851 44387</del> <sup>445307 443876</sup> , the 2 metre wide path runs generally north east along the northern side of, but not in, the adjacent wooded area for approximately 190 metres to Grid Reference 44865 44399 from where it heads north west for approximately 5 metres to Grid Reference 44865 44399 from where it heads north east for approximately 4 metres to Grid Reference 44865 44399 where it meets the publicly maintainable road known as Wighill Lane via a gap in wall.	Earth	<del>0.199 km</del> <sup>0.1751 km</sup>          Total <del>0.199 km.</del> <sup>0.1751 km</sup>	2metres	

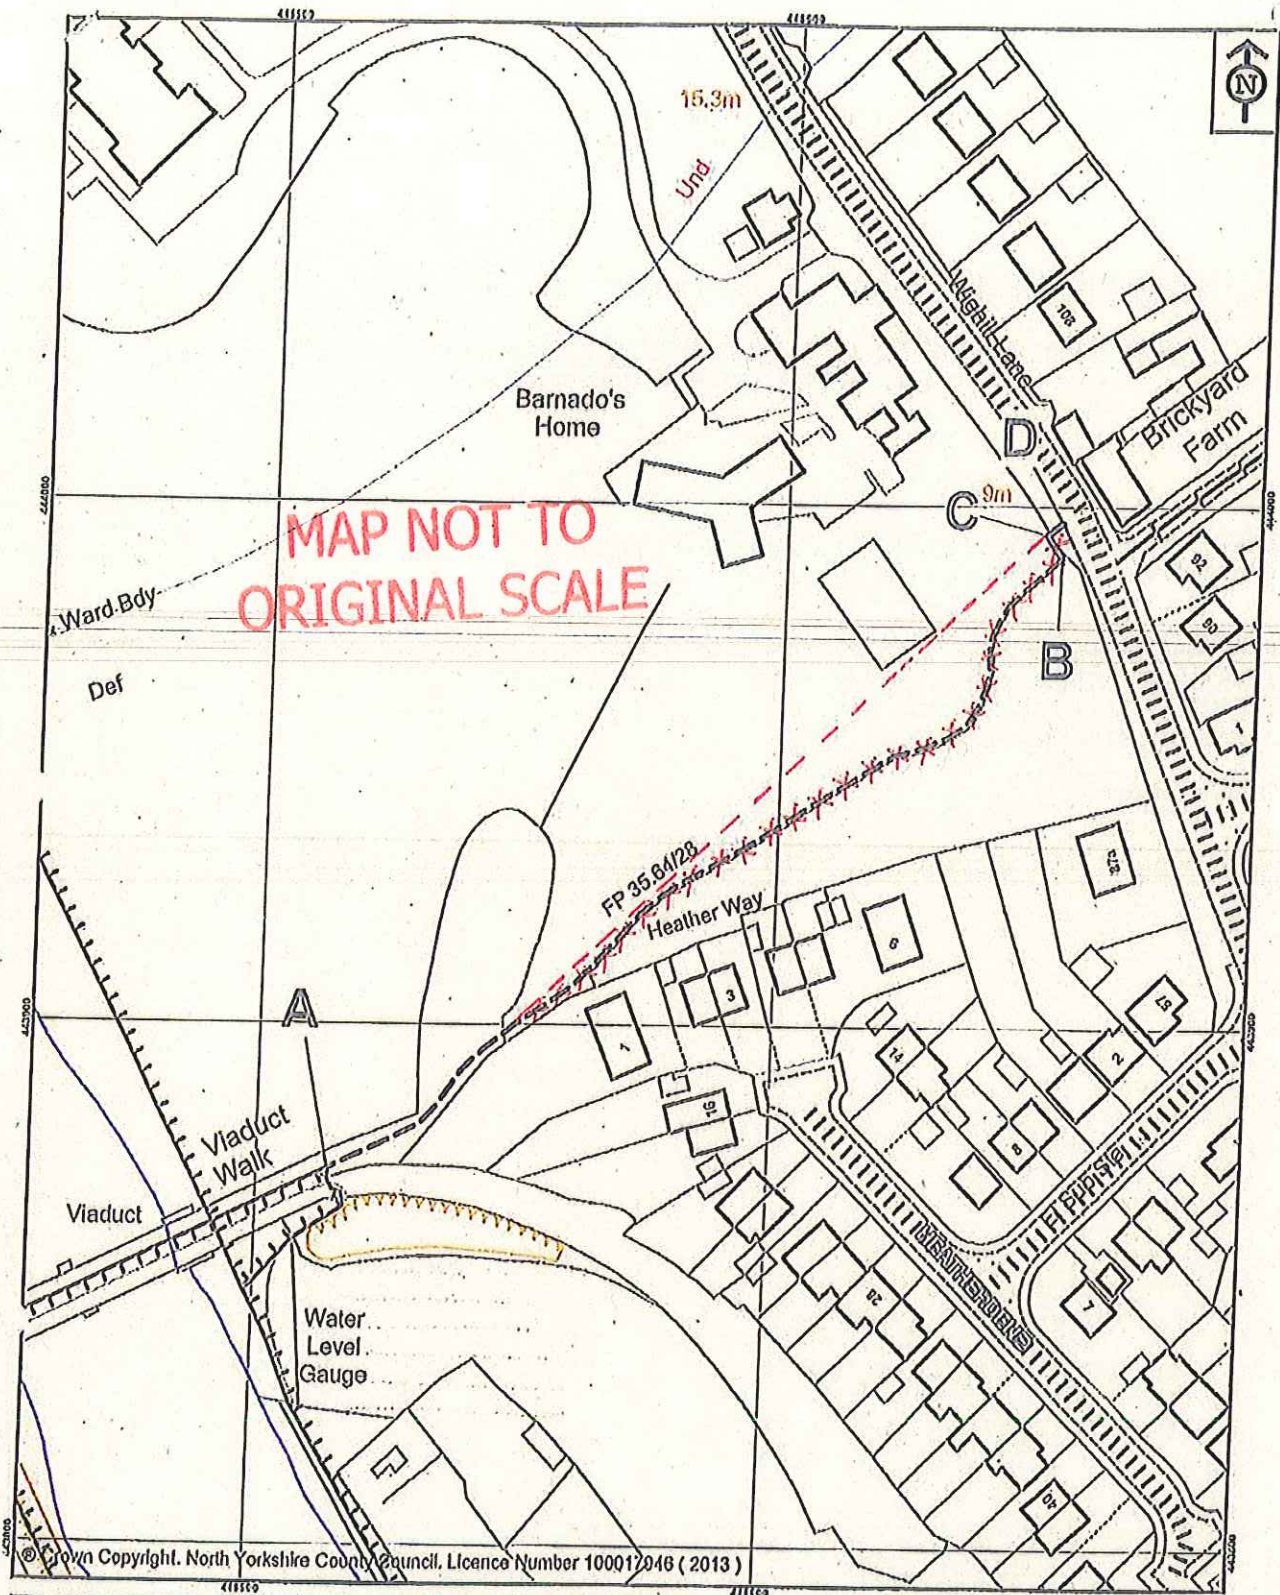

© Crown Copyright. North Yorkshire County Council. Licence Number 100012046 (2013)

**North Yorkshire County Council**  
 Public Rights of Way  
 Waste and Countryside Services  
 County Hall  
 Northallerton  
 DL7 8AH

**Key:**  
 Footpath to be recorded A-B-C-D   
 Unaffected footpath   
 Maintainable Highways   
 Map drawn on 27 June 2013  
 Drawn by RJV | Scale 1:1250

**North Yorkshire County Council**  
 Wildlife and Countryside Act 1981  
 Section 53  
 FOOTPATH No. 35.64/28  
 EASTERN END OF TADCASTER  
 VIADUCT TO WIGHILL LANE,  
 TADCASTER  
 MODIFICATION ORDER 2013  
 File Ref No. SEL/2012/04/DMMO

NORTH YORKSHIRE COUNTY COUNCIL

WILDLIFE AND COUNTRYSIDE ACT 1981

THE FORMER WEST RIDING OF YORKSHIRE AREA 2 DEFINITIVE MAP AND STATEMENT

FOOTPATH No. 35.64/28 EASTERN END OF TADCASTER VIADUCT TO WIGHILL LANE,  
TADCASTER MODIFICATION ORDER 2013

NORTH YORKSHIRE COUNTY COUNCIL in exercise of the powers conferred upon it in that behalf hereby confirm the foregoing Order (without any modification) as an Unopposed Order.

IN WITNESS whereof  
THE COMMON SEAL of NORTH  
YORKSHIRE COUNTY COUNCIL  
was hereunto affixed this.....day of  
..... 2013  
in the presence of:-