

**MODIFICATION ORDER
WILDLIFE AND COUNTRYSIDE ACT 1981
ROYAL BOROUGH OF WINDSOR AND MAIDENHEAD
DEFINITIVE MAP AND STATEMENT**

THE FOOTPATH 16 WINDSOR MODIFICATION ORDER 2014

This Order is made by the Royal Borough of Windsor and Maidenhead ("the Authority") under Section 53(2)(b) of the Wildlife and Countryside Act 1981 ("the Act") because it appears that the Royal Borough of Windsor and Maidenhead Definitive Map and Statement require modification in consequence of an event specified in Section 53(3)(b) and Section 53(3)(c)(i) of the Act, namely the expiration of any period such that the enjoyment by the public of the way during that period raises the presumption that the way has been dedicated as a public path and the discovery of evidence which, when considered with all other relevant available evidence, shows that a right of way which is not shown on the Map and Statement subsists or is reasonably alleged to subsist in the area to which the Map relates.

The Authority has consulted with every local authority whose area includes the land to which the Order relates.

The Royal Borough of Windsor and Maidenhead hereby orders that:

1. For the purposes of this Order the relevant date is 14th November 2014.
2. The Royal Borough of Windsor and Maidenhead Definitive Map and Statement shall be modified as described in Part I and Part II of the Schedule and shown on the map attached to the Order.
3. This Order shall take effect on the date it is confirmed and may be cited as the Footpath 16 Windsor in the Royal Borough of Windsor and Maidenhead Order 2014.

SCHEDULE

PART I

MODIFICATION OF THE DEFINITIVE MAP

(References to lettered points in the following description are references to letters on the attached map. All distances and directions are approximate.)

FOOTPATH 16 WINDSOR

The path commences at point A on the edge of the adopted highway between numbers 36 and 38 Priors Road, Windsor (grid reference 493957-176029) and runs in a generally easterly direction for a distance of 44 metres to point B (grid reference 494000-176021). The path then runs in a generally southerly direction for a distance of 5 metres to point C (grid reference 493999-176016). The path then runs in a generally easterly direction for 32m to point D (grid reference 494031-176013), then in a curving but generally north-easterly direction for 29m to point E, at the edge of the adopted highway between numbers 30 and 32 Keepers Farm Close (grid reference 494044-176037).

Width: ~~A-B-C: varying between 1.5m and 1.7m as shown on the order plan.~~
~~G-D-E: 1.5m throughout.~~

A-B 1.8 metres
B-C 2.4 metres
C-D-E 4 metres

PART II

MODIFICATION OF THE DEFINITIVE STATEMENT

FOOTPATH 16 WINDSOR

The description of the path shall be:

"From": Priors Road between property numbers 36 and 38.

"To": Keepers Farm Close between property numbers 30 and 32

The width of the path shall be recorded as:

A-B 1.8 metres

~~A-B-C: varying between 1.5m and 1.7m as shown on the order plan.~~

B-C 2.4 Metres

~~G-D-E: 1.5 m throughout.~~

C-D-E 4 metres


Limitations and conditions: none


Map sheet 11

THE COMMON SEAL of the
**ROYAL BOROUGH OF WINDSOR AND
MAIDENHEAD** was hereunto affixed
on the *18* day of *NOVEMBER* 2014
in the presence of:

Mani Lucas

Head of Legal Services

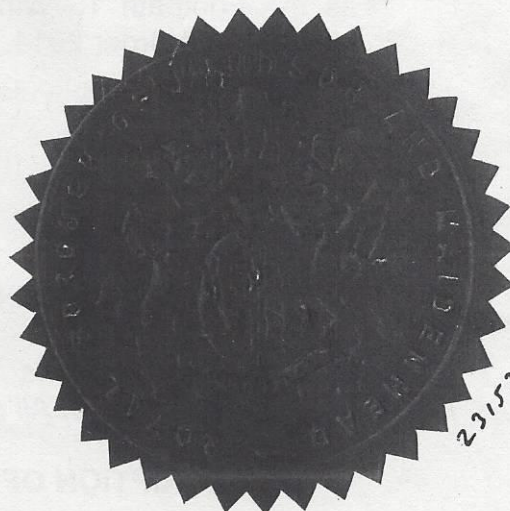

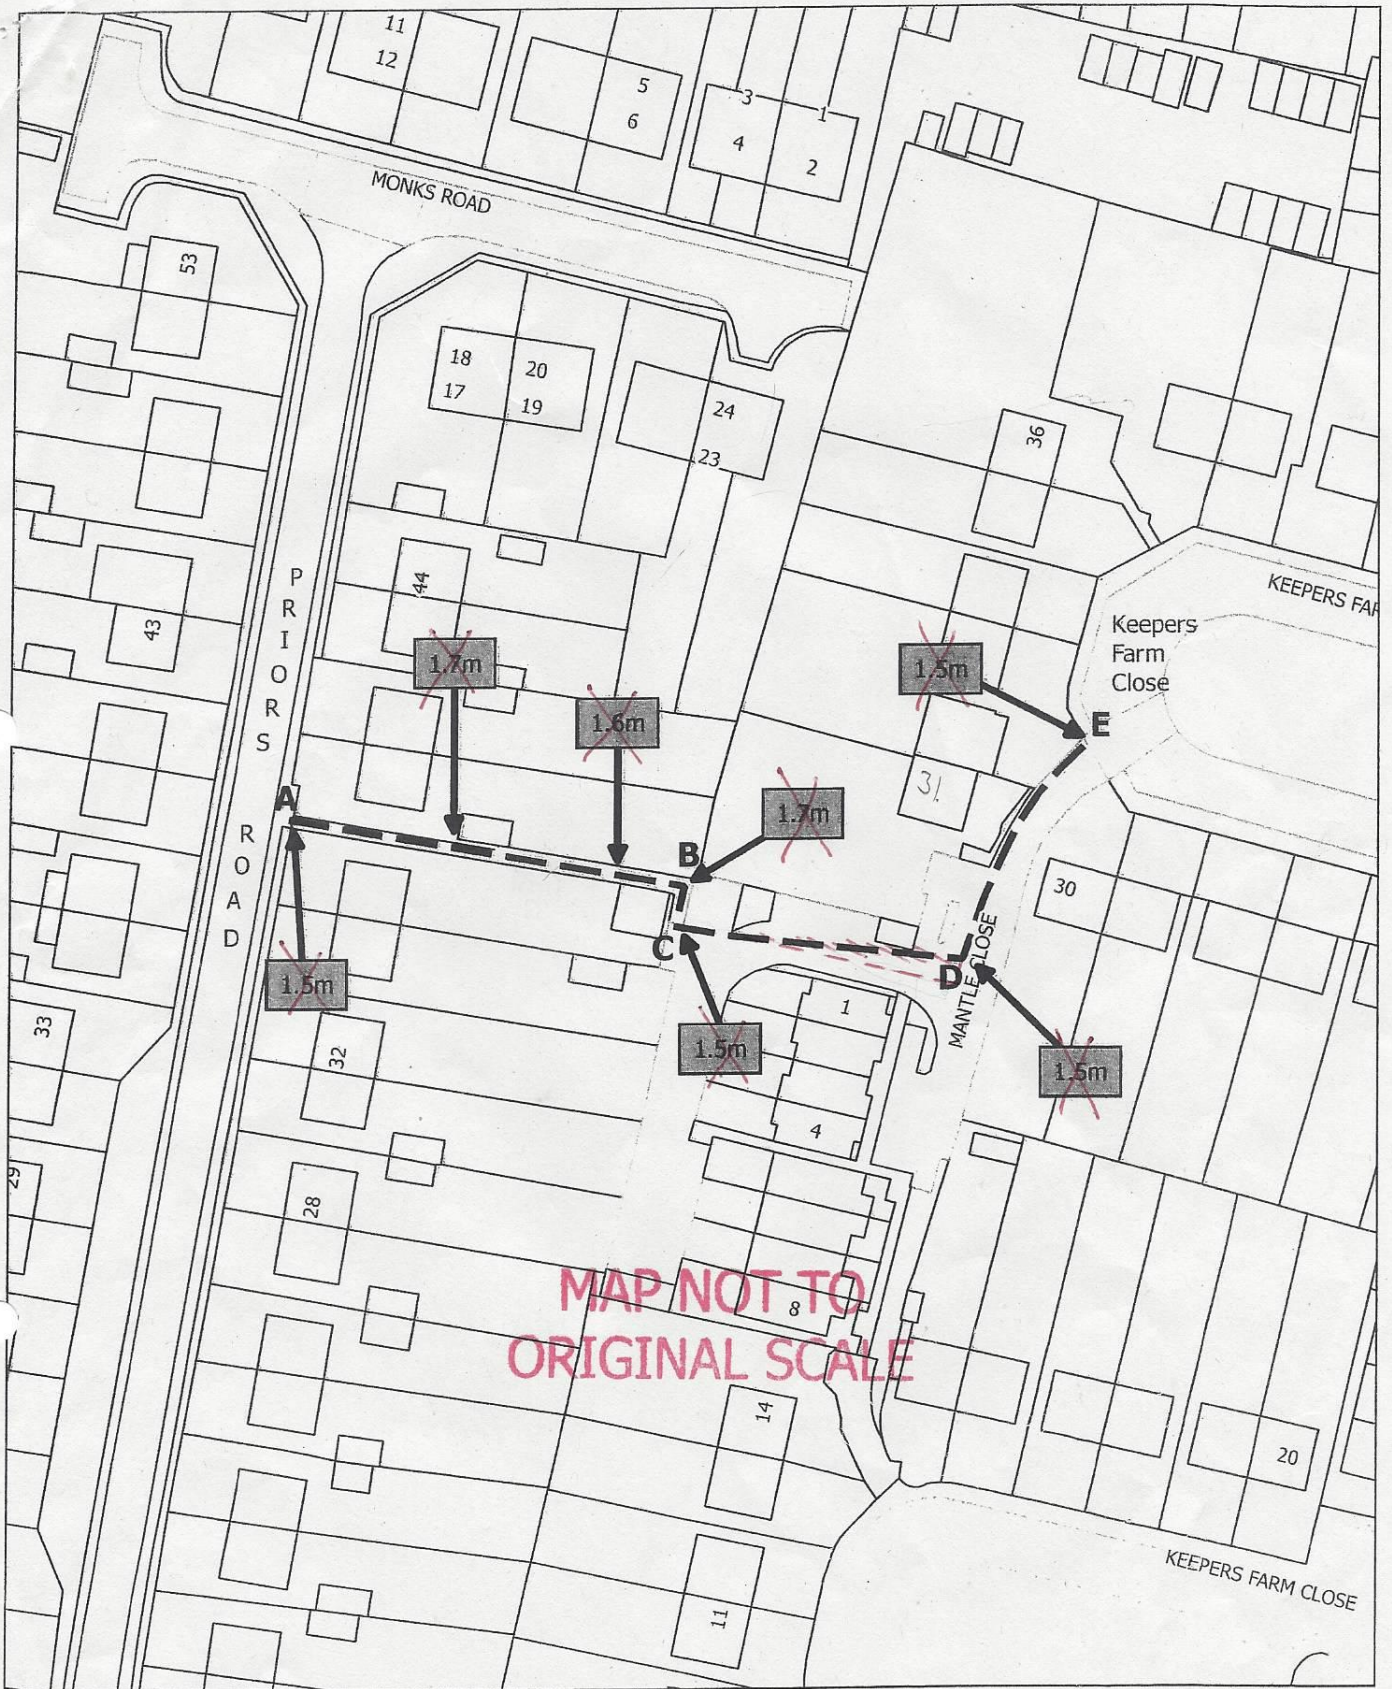

Public Rights of Way
 Drawn by: Andrew Fletcher

Scale: 1:750

Wildlife and Countryside Act 1981
Definitive Map Modification Order RBWM036

Windsor Footpath 16

--- Footpath to be added to the definitive map

Mani adrian N



The Royal Borough



Windsor & Maidenhead