
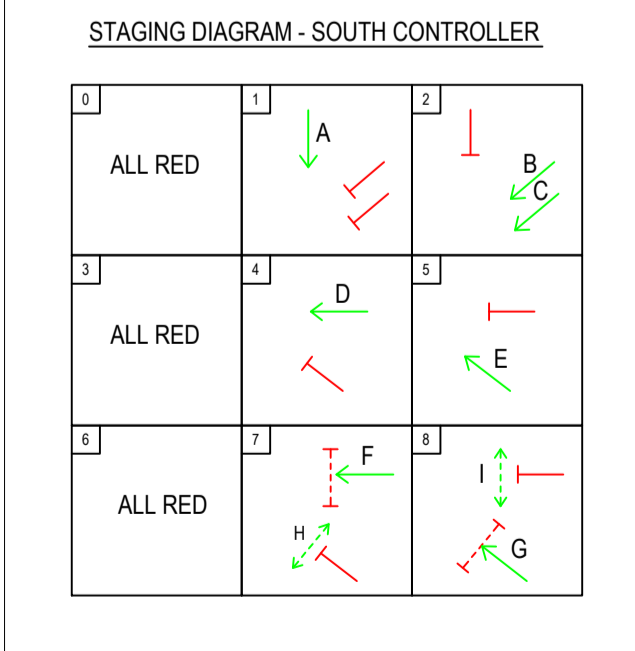
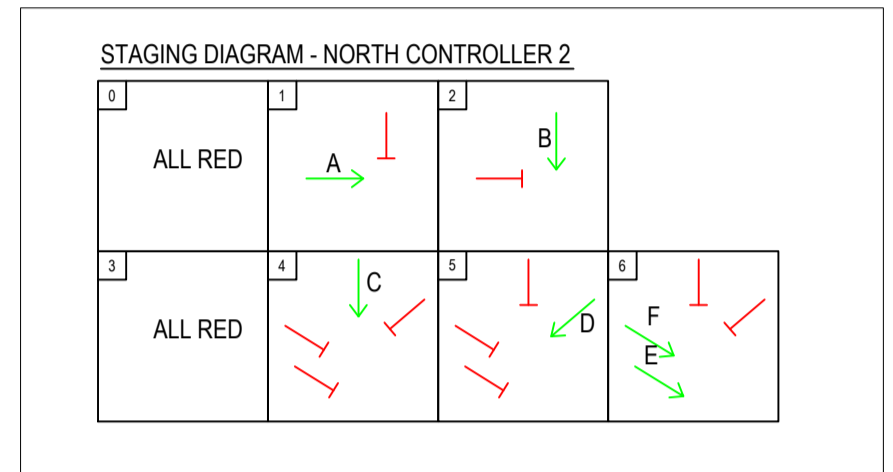
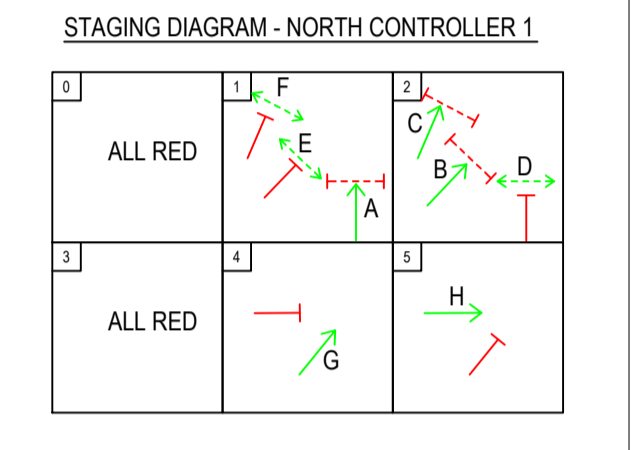


Safe Roads :



Reliable Journeys :

Informed Travellers :

This map is reproduced from Ordnance Survey material with the permission of Ordnance Survey on behalf of the Controller of Her Majesty's Stationery Office. It is Crown Copyright. Unauthorised reproduction infringes Crown Copyright and may lead to prosecution or civil proceedings. Highway Agency 100019625.

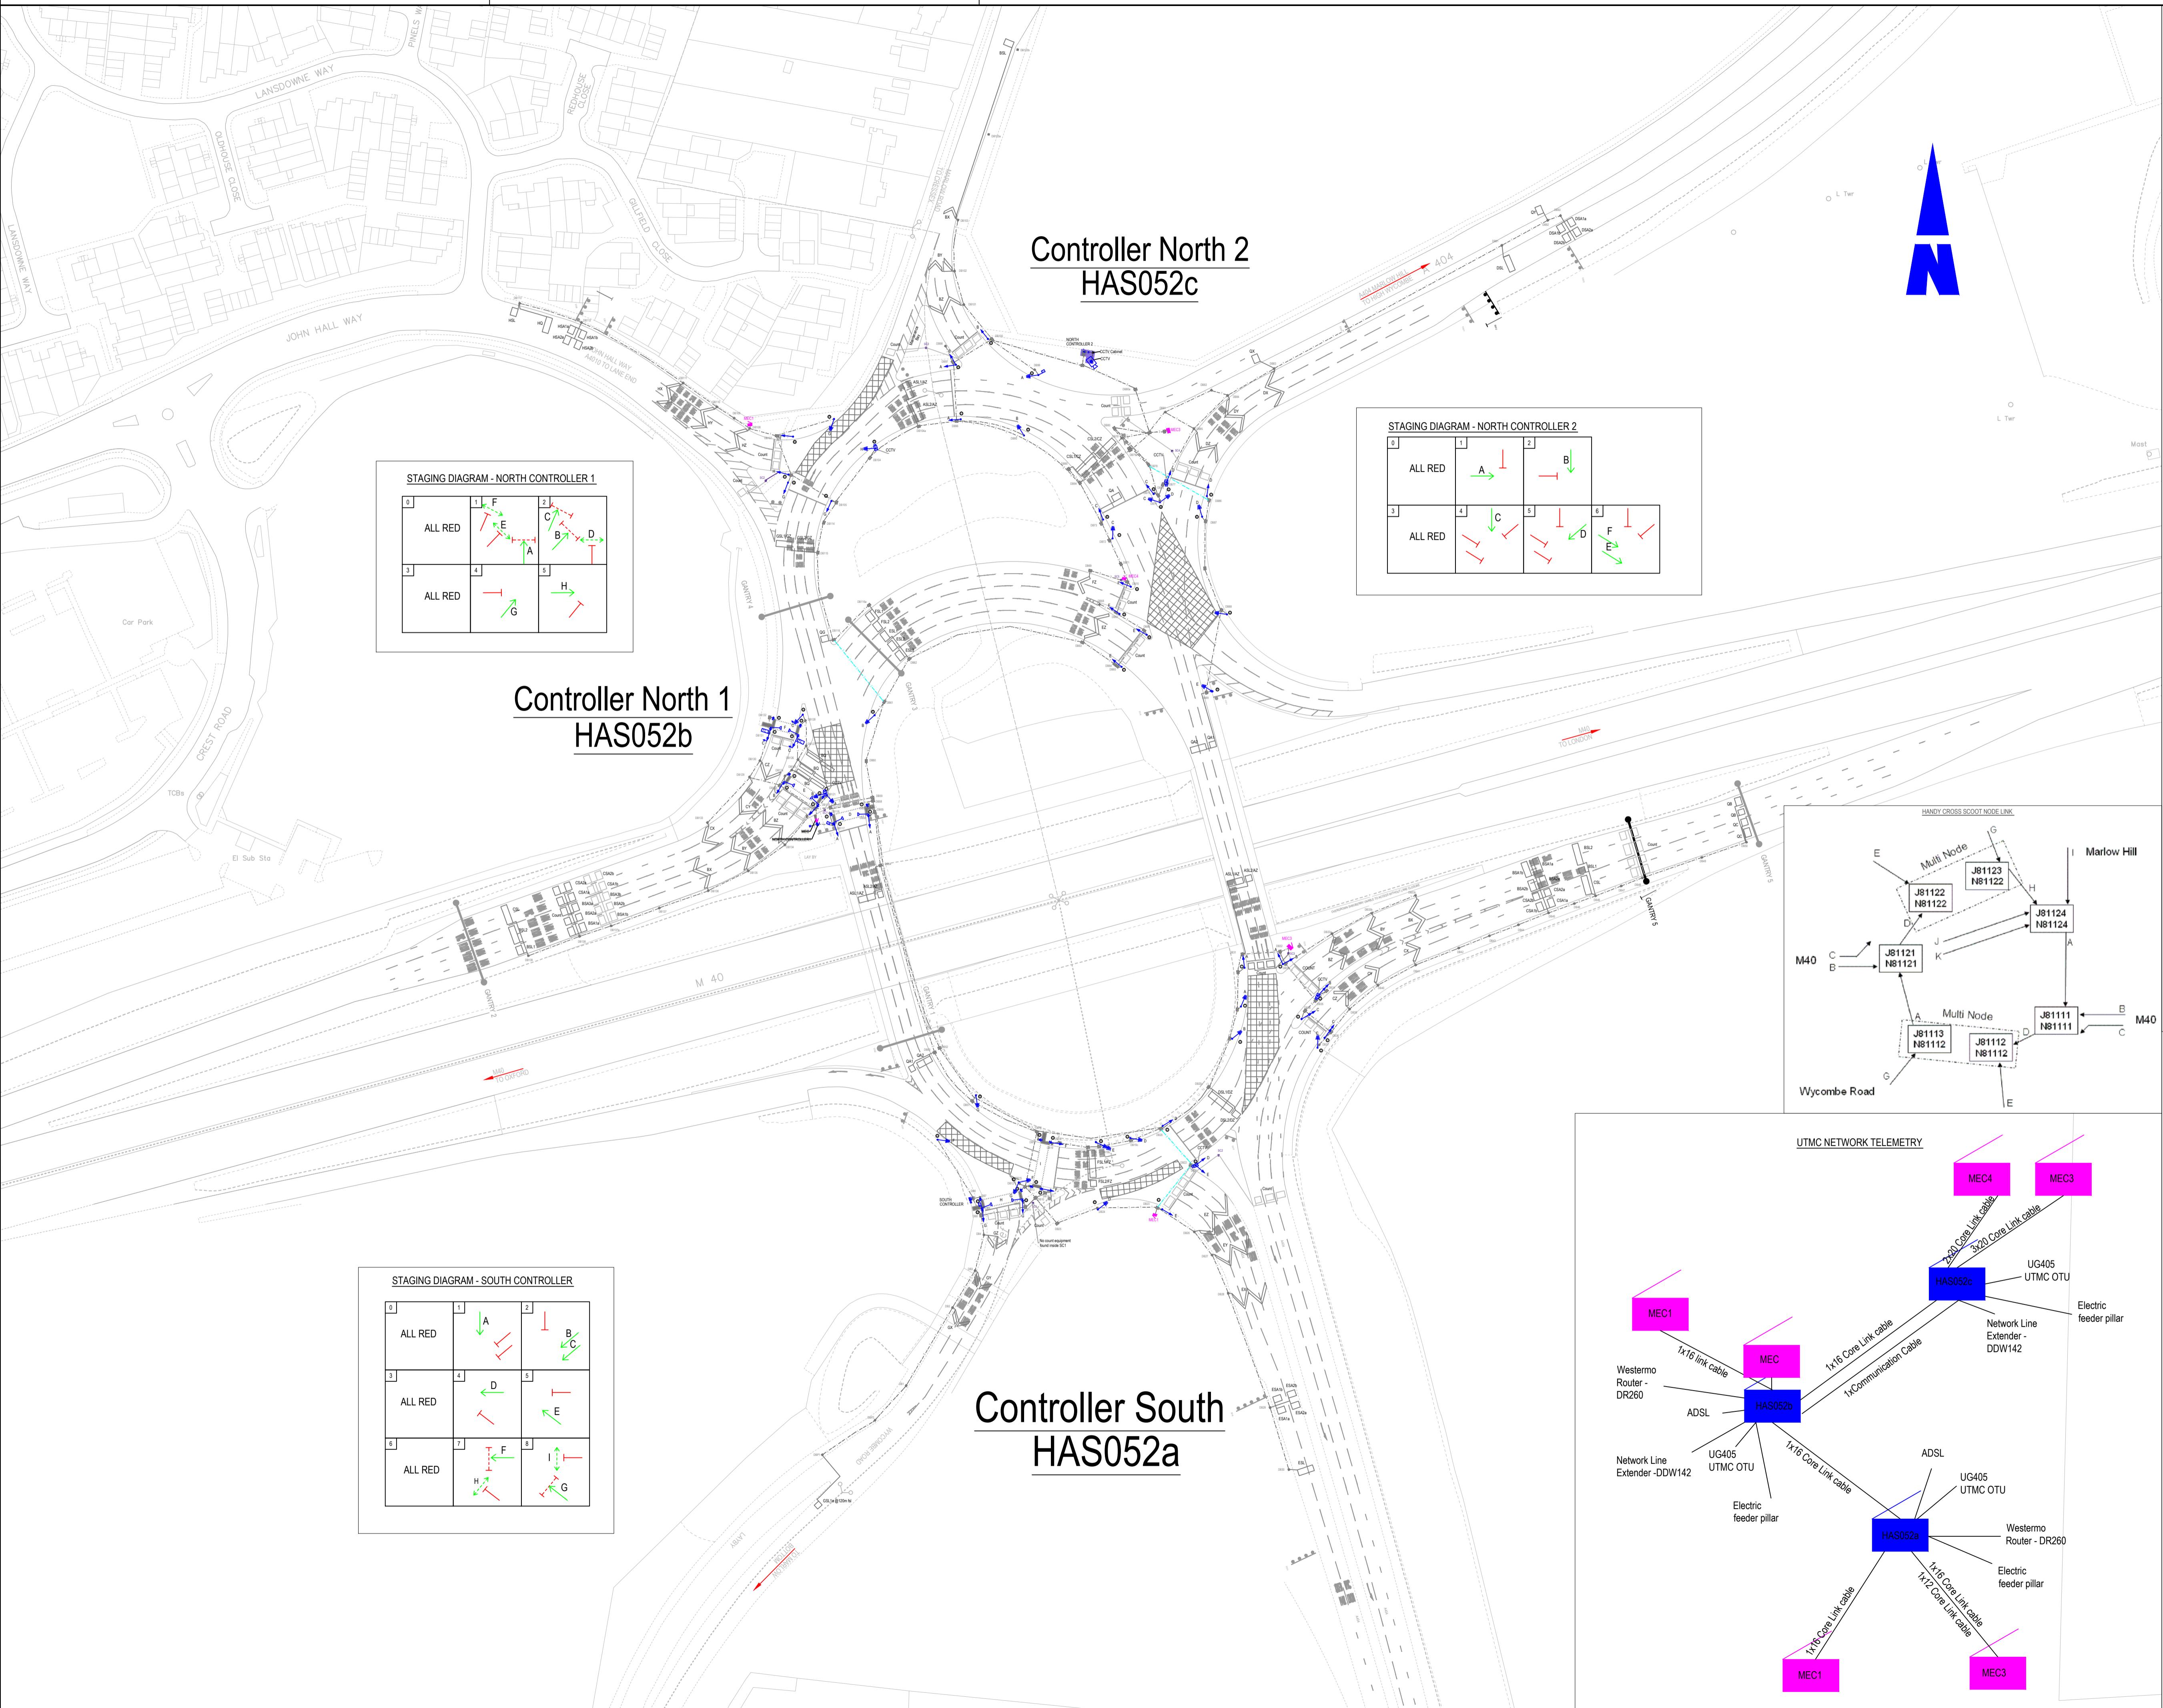

- POLES**
  - Traffic Signal Poles
- VEHICLE SIGNAL HEADS**
  - Primary LV CLS RAG LED Signal Head
  - Secondary LV CLS RAG LED Signal Head
  - Primary LV CLS RAG LED Signal Head with Left Turn Green Arrow Aspect (3-in-line)
  - Secondary LV CLS RAG LED Signal Head with Left Turn Green Arrow Aspect (3-in-line)
- PEDESTRIAN SIGNAL HEADS**
  - RM/GM Pedestrian Display
  - Push Button Units with Tactile Device
- SIGNAL EQUIPMENT**
  - Photo-Electric Cell
  - Traffic Signal Controller
  - MEC Cabinet
  - Electric Feeder Pillar (FP)
  - Solar Cabinet (SC)
  - VA Loops (XYZ)
  - SA Loops (SA)
  - Count Loops (COUNT)
  - Queue Loops (Q)
  - SCOOT Loops (SL)
- CIVILS**
  - 1x50mm Black Duct
  - 1x100mm Polyethylene Traffic Signal Duct
  - Blocked Traffic Signal Duct
  - Duct Chambers
- MISCELLANEOUS**
  - Pole Number
  - Kerbing and Road Furniture
  - Pedestrian Studs
  - Red Coloured Tactile Paving (400x400mm)
  - CCTV

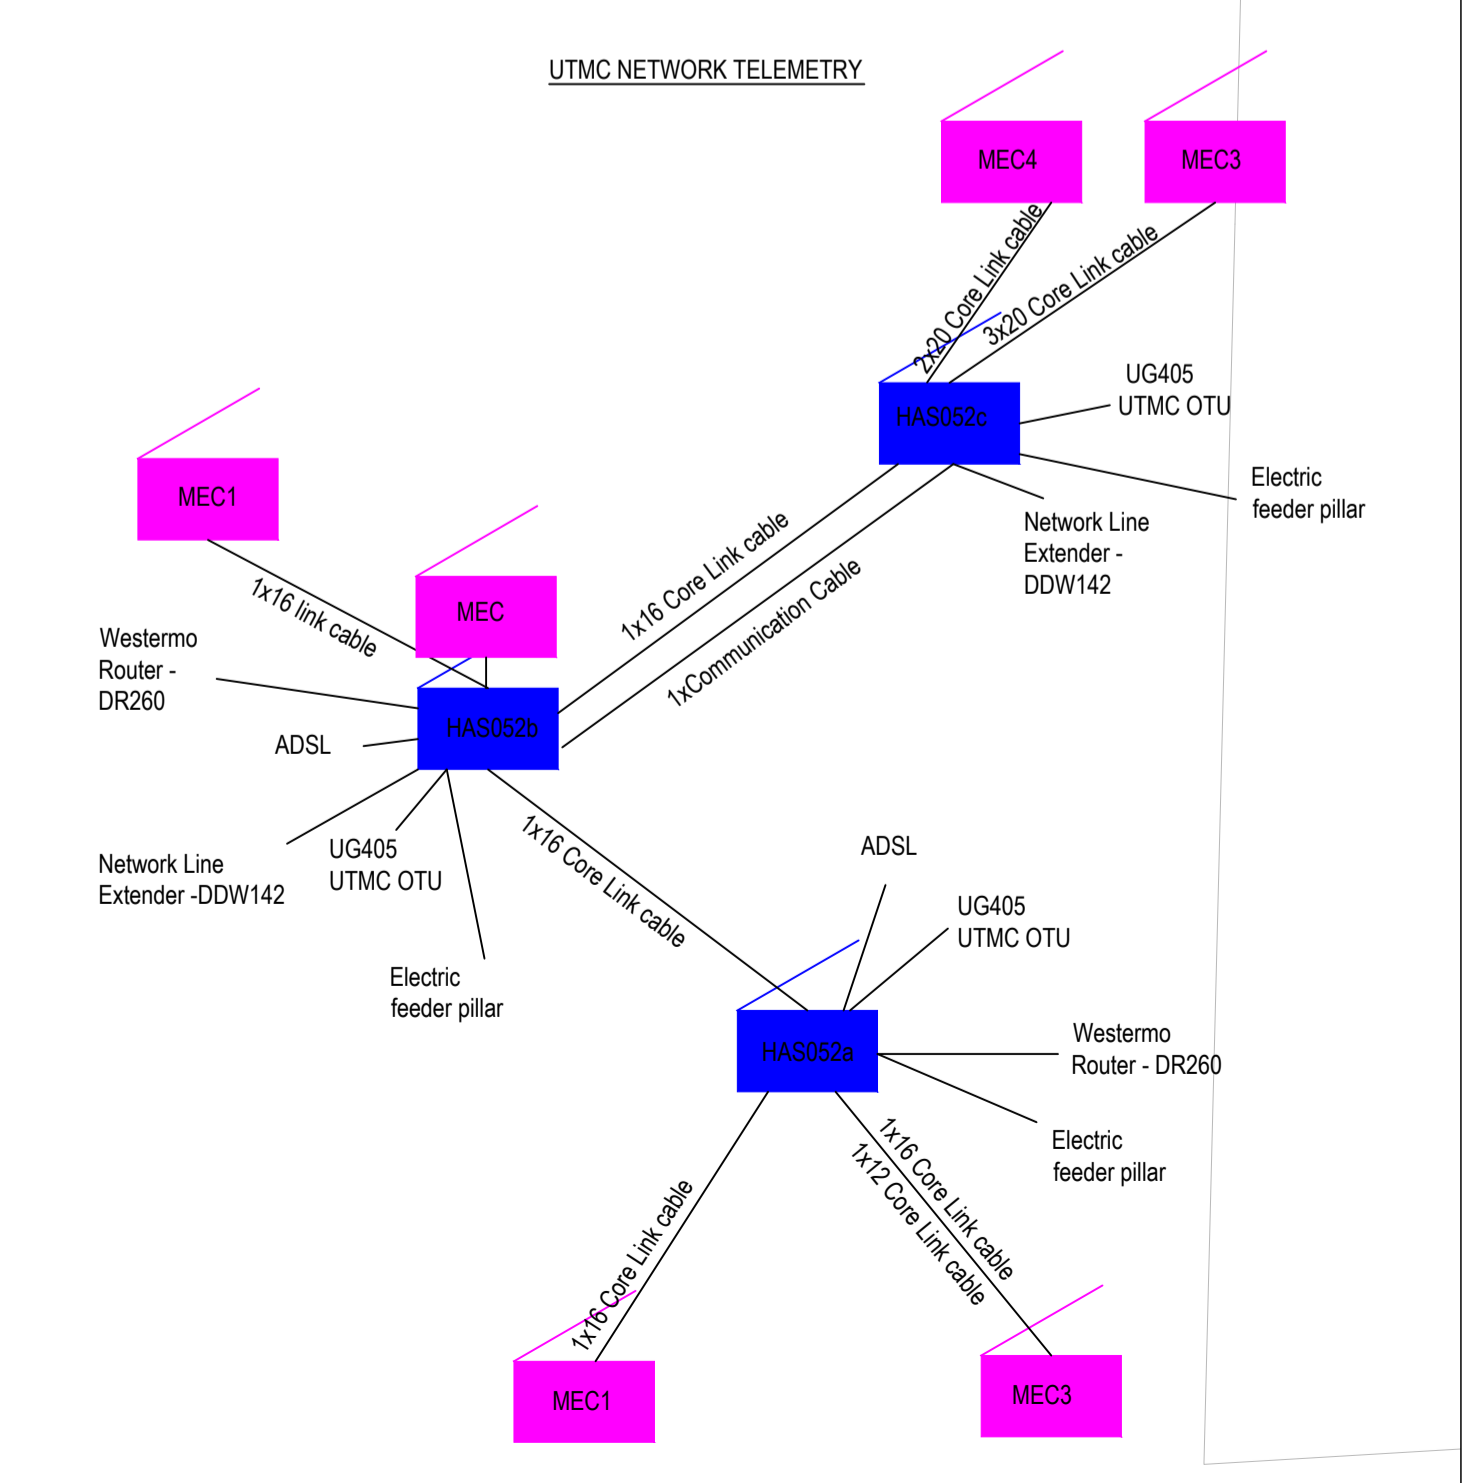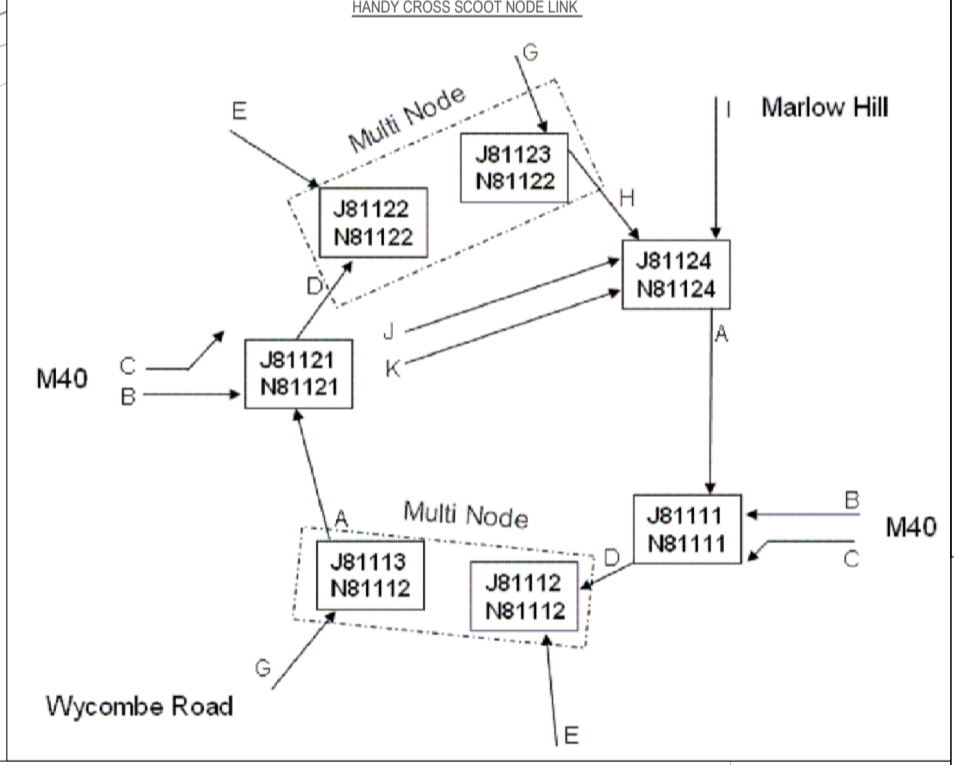

REV	DATE	DESCRIPTION	BY	CHKD	APPD
G	17/06/14	AS BUILT FOLLOWING THE CHANGES ON SITE	MG	CWH	GW
F	17/02/14	AS BUILT	MG	CWH	GW
E	17/12/13	FOR CONSTRUCTION	MG	CWH	GW
D	13/08/13	AMENDED FOLLOWING MEETING 07/08	MG	CWH	GW
C	16/07/13	AMENDED FOLLOWING MEETING 19/07	MG	CWH	GW
B	16/07/13	FOLLOWING EM COMMENTS	MG	CWH	GW
A	10/07/13	FIRST ISSUE	MG	MA	GW

Rosslind House  
Jays Close  
Viabes Business Park  
Basingstoke  
Hampshire  
RG22 4BS  
Tel: 01256 481000  
Fax: 01256 481001

**CLIENT**  
**HIGHWAYS AGENCY**  
Federated House  
London Road  
Dorking  
RH4 1SZ

**PROJECT**  
**M40 J4 / A404**  
**HANDY CROSS ROUNDABOUT**

**TITLE**  
**HAS052 - HANDY CROSS ROUNDABOUT**  
**SCOOT PROPOSALS**  
**GENERAL LAYOUT**  
**DRAWING 1of 4**

DATE	SCALE	STATUS	DESIGNED	CHECKED	APPROVED
17/06/2014	AS SHOWN	AS BUILT	MG	CWH	GW

**DRAWING NUMBER**  
**3/15004/DR/1200/010**

**STATUS**  
**AS BUILT**