





The Excitement is Building



NOTES  
New walls and partitions shown in red

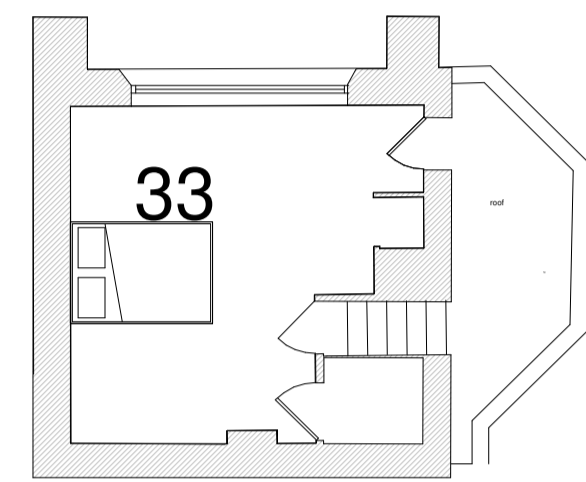

Third floor

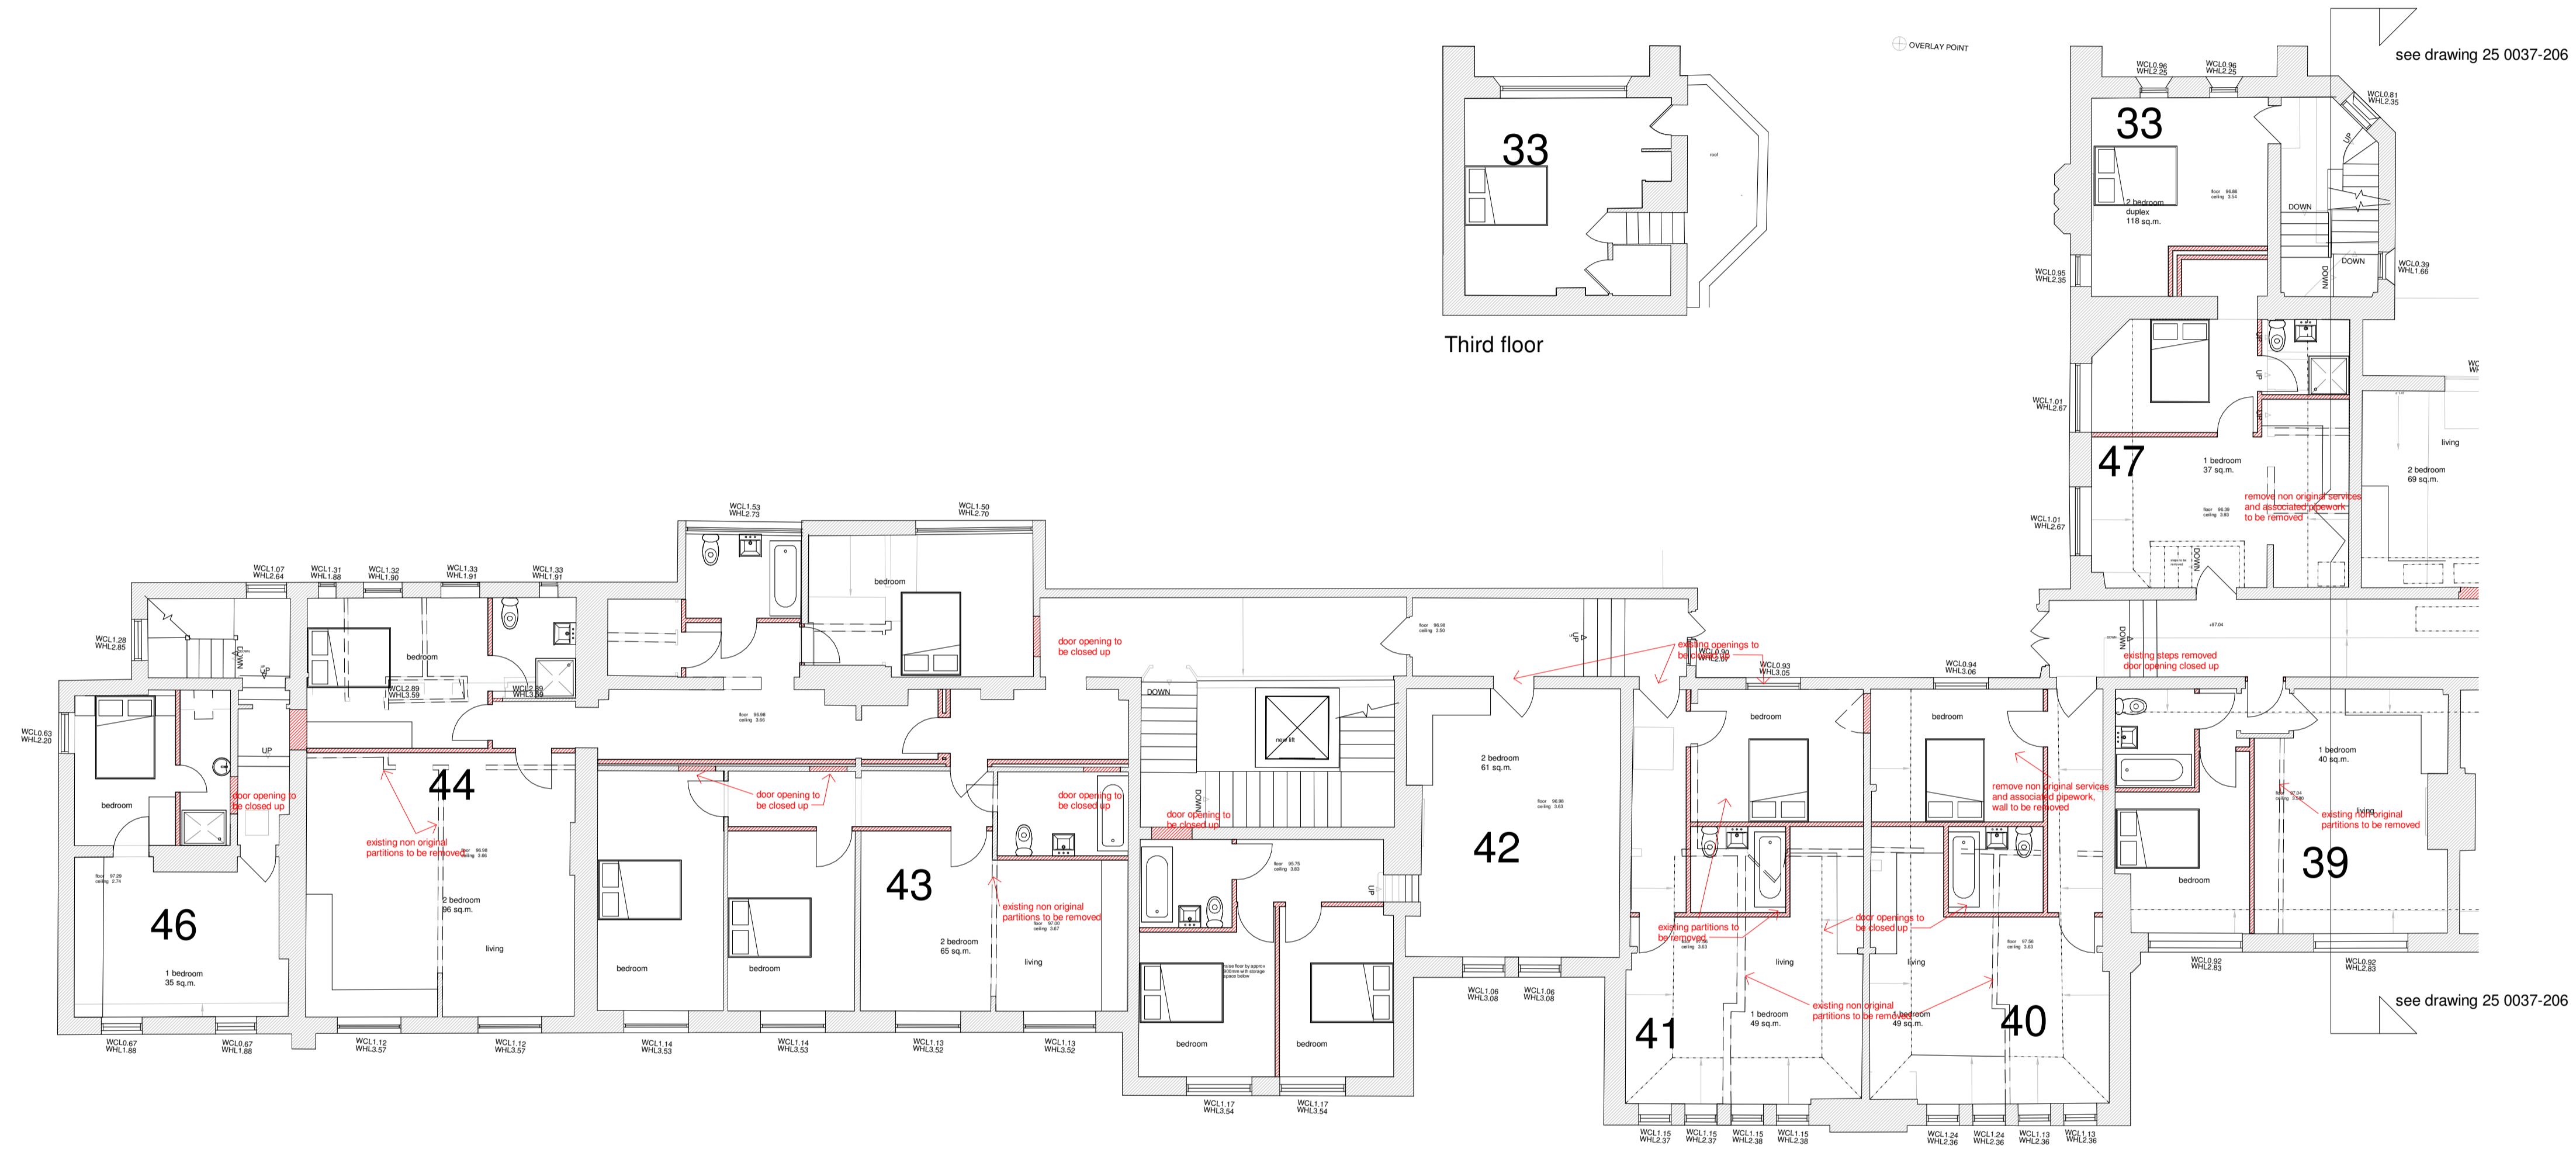

Second floor plan (west side)  
1 : 100

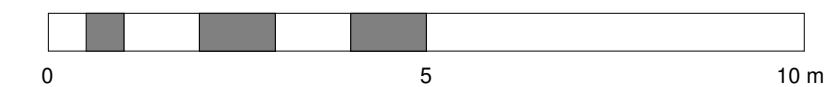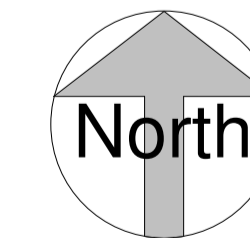

REV	AMENDMENTS	DATE
DRAWN BY		DATE
Author		03/01/22
SCALE (@ A1)		PROJECT NUMBER
As indicated		Project Number
CHECKED BY	APPROVED	
Checker		
TITLE		
School building conversion proposed alterations to second floor plans (west side)		
PROJECT		
Walden School, Saffron Walden		
DRAWING NUMBER		
21 0037-414		