
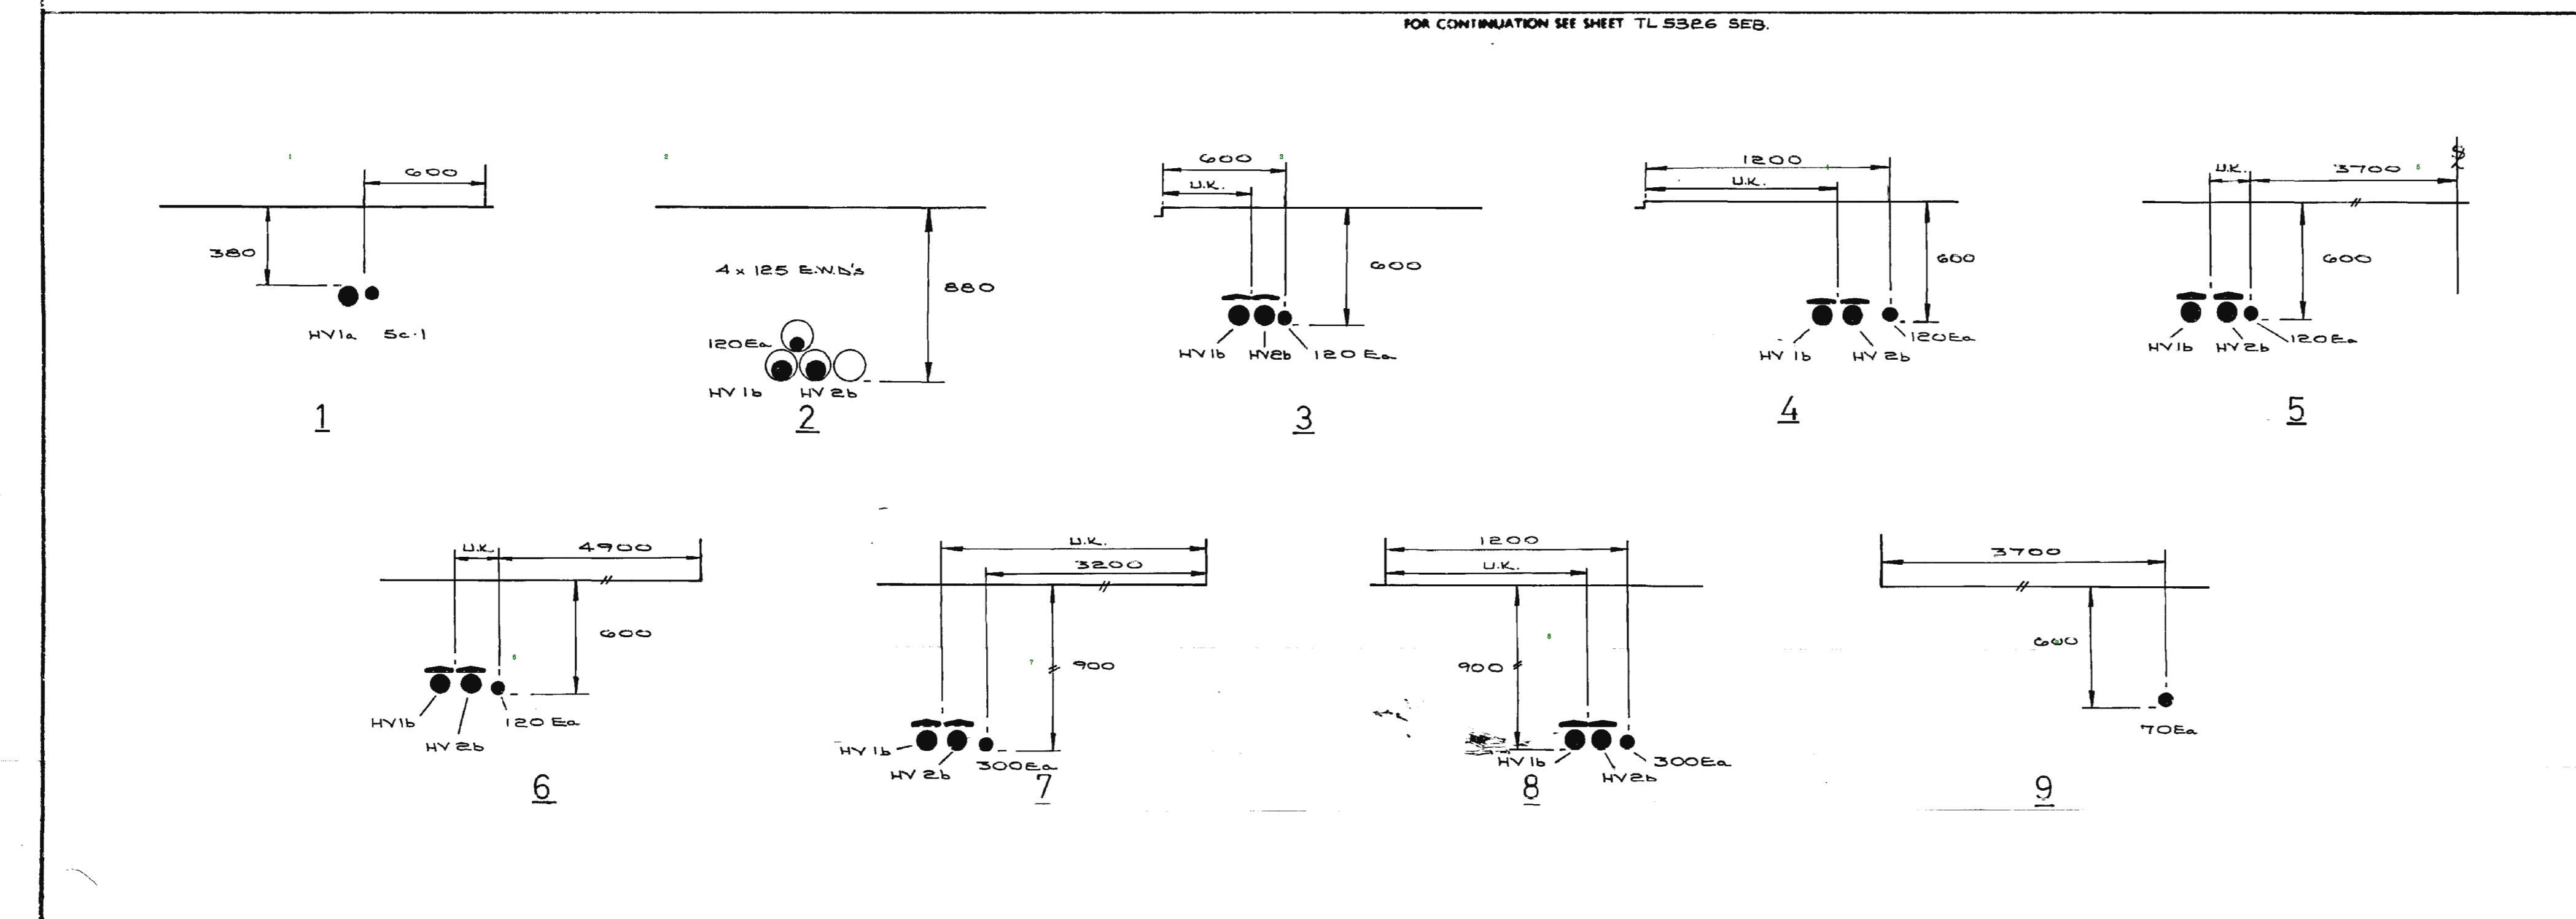


TL 5326 SEA

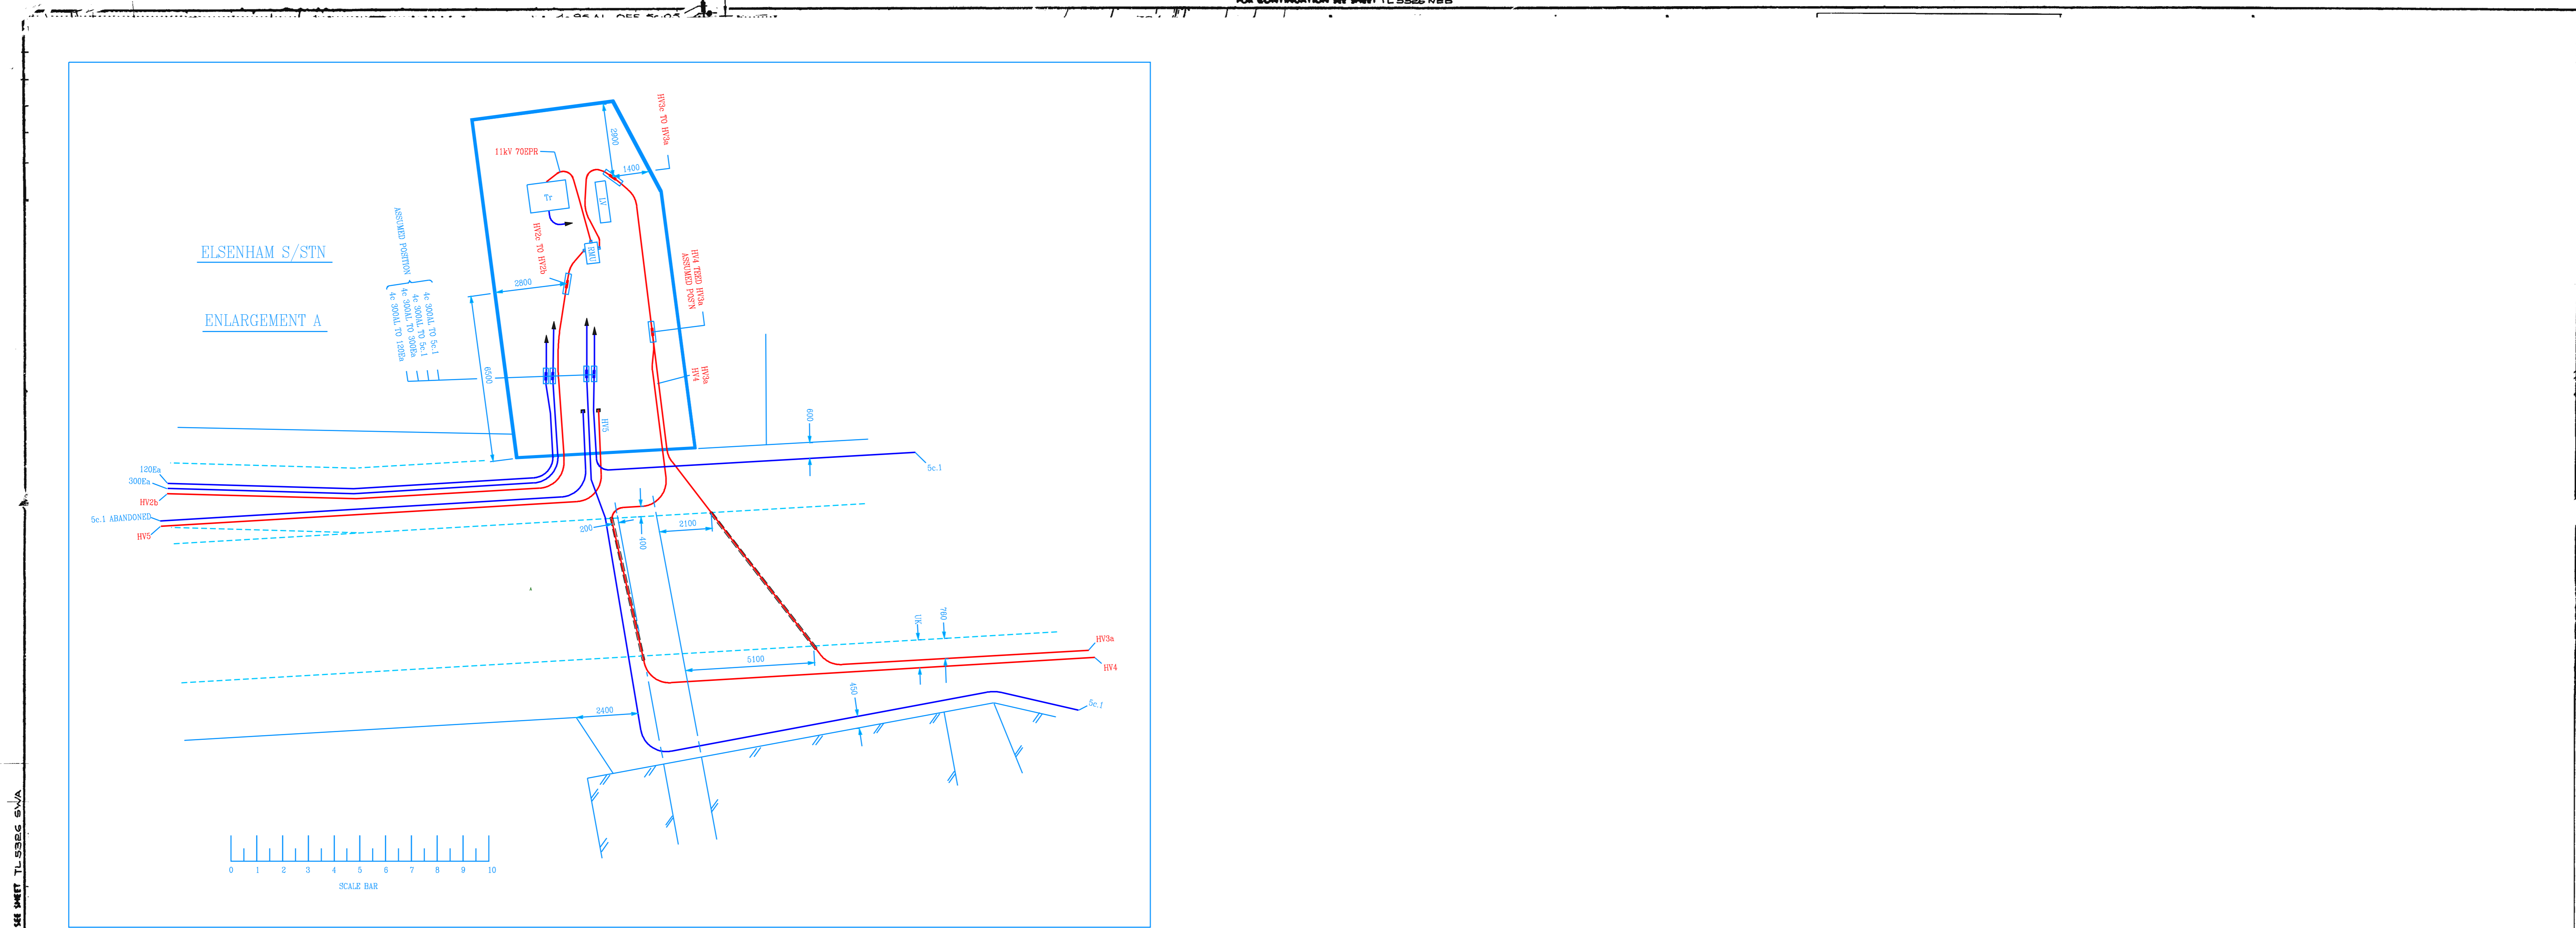

PILOT CABLES AND HIGH VOLTAGE CABLES
Serial numbers refer to this sheet only and lengths are to sheet edge

No.	kV	Size	Cores	Designation	Length		No.	kV	Size	Cores	Designation	Length	
					metres	yards						metres	yards
	HV1A	27	3	HIGHFIELDS - ELSHAM HOOD									
	HV1B	11	3	" " " "									
	HV2A	11	3	ROBIN HOOD - ELSHAM									
	HV2B	11	3	" " " "									
	HV3	11	3	ELSHAM - POLE 6/1									
	HV4	11	3	ELSHAM PLACE TRSS HV3									
	HV5	3	3	ABANDONED									
					Total length								

NOTES (1) FOR FULL DETAILS OF HV CABLES REFERENCE SHOULD BE MADE TO THE PRIMARY RECORDS
(2) E DENOTES CNE CABLE & DENOTES ALPEX TYPE, e DENOTES HYBRID COPPER & ALUMINIUM CONDUCTORS
(3) ALL DEPTHS SHOWN ARE AS LAID, SUBJECT TO FINAL LEVELS
(4) U.K. DENOTES UNILATERAL
(5) # DENOTES 3KV OPPAT 11KV (TAPE ARMoured CABLES)


eastern electricity


1 : 500 SCALE U/G MAINS

LOCATION: ELSHAM

DIMENSIONS IN MILLIMETRES	REPRODUCED FROM OR BASED UPON THE ORDINANCE SURVEY MAP WITH THE SANCTION OF THE CONTROLLER OF HM STATIONERY OFFICE CROWN COPYRIGHT RESERVED	SERVICES FOR DETAILS OF SERVICE CABLE REFERENCE SHOULD BE MADE TO THE SERVICE CARDS IN THE DISTRICT OFFICE	SHEET NO.	ISSUE	DATE
			TL5326SEA.S0	C	08-06-01
			SUPPLEMENTARY SHEET NO. TL 5326SEA.S0		

FOR CONTINUATION SEE SHEET TL 5326 SEA

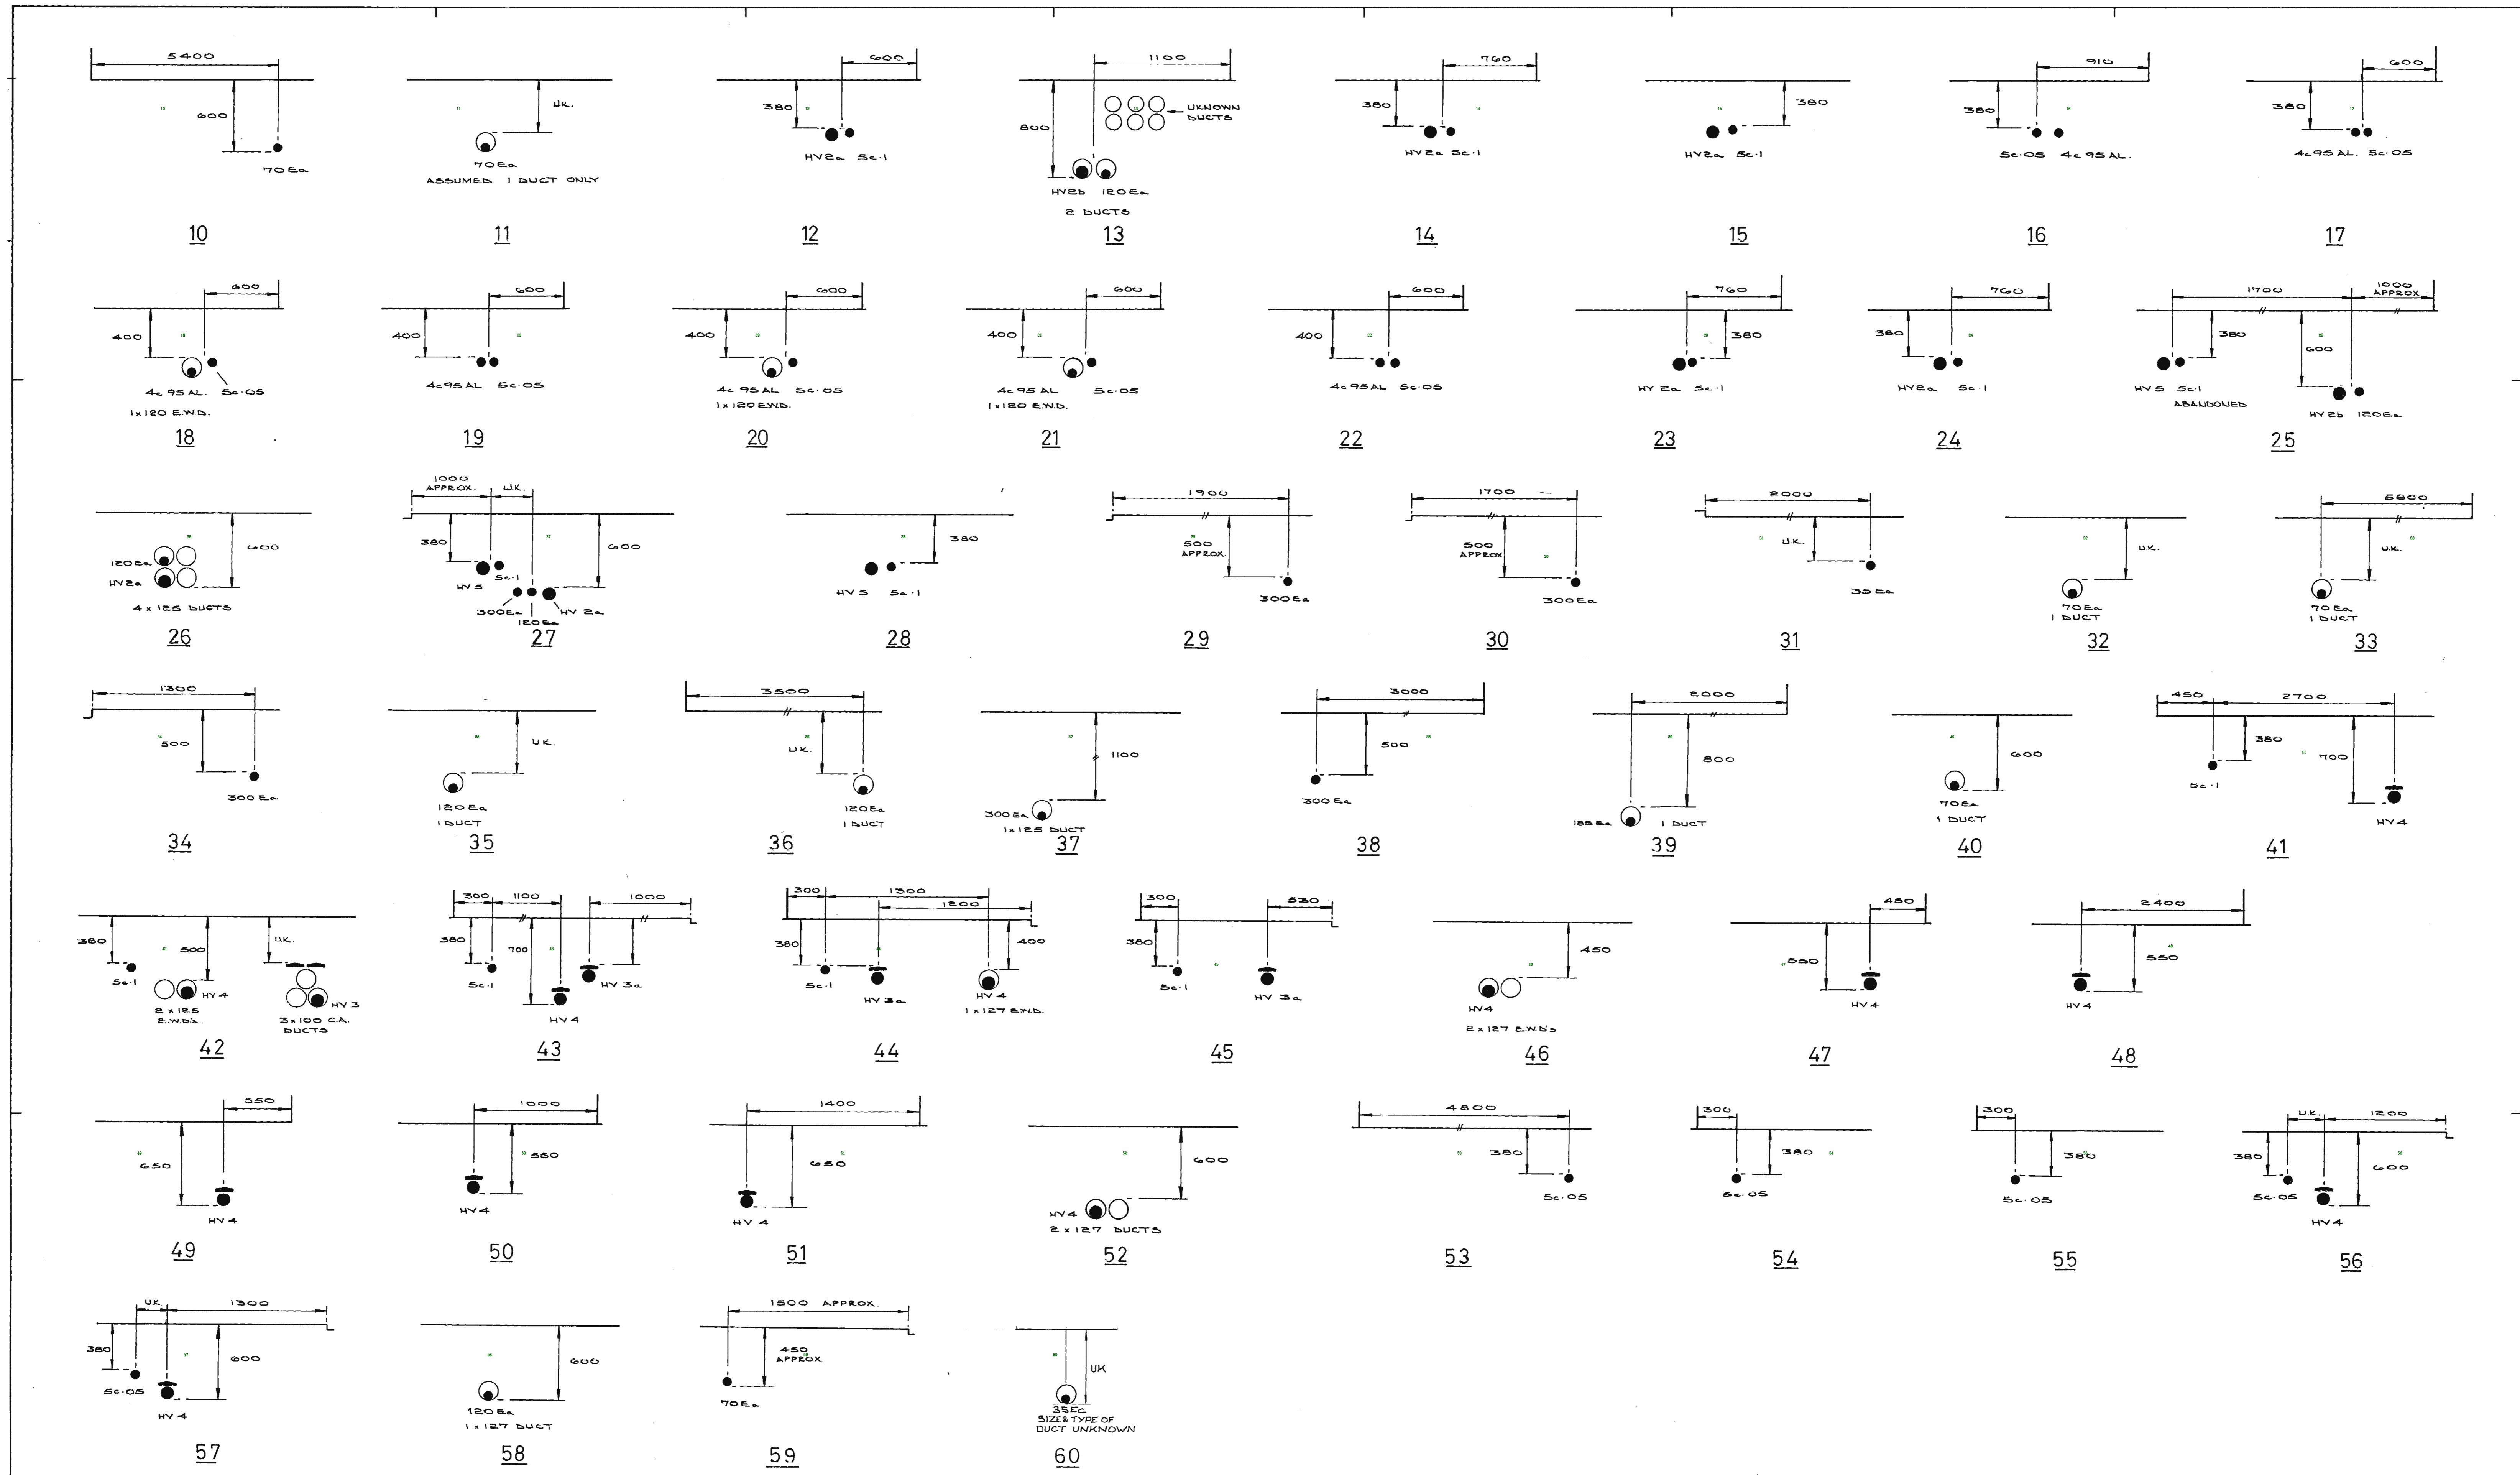

eastern electricity 	
SCALE	N.T.S.
LOCATION	ELSENHAM
SHEET NO.	TL 5326 SEA/1
ISSUE	D
DATE	FEB 87
SUPPLEMENTARY SHEET NO.	

REPRODUCED FROM OR BASED UPON THE ORDNANCE SURVEY MAP WITH THE PERMISSION OF THE CONTROLLER OF H.M. STATIONERY OFFICE. CROWN COPYRIGHT RESERVED.

SERVICES FOR DETAILS OF SERVICE CABLES REFERENCE SHOULD BE MADE TO THE SERVICE CARDS IN THE LOCAL OFFICE.

SO


TL5326SEB 1:500 LV

TL 5326 SEB

FOR CONTINUATION SEE SHEET TL 5326 6/A.

FOR CONTINUATION SEE SHEET TL 5326 6/A/B.

FOR CONTINUATION SEE SHEET TL 5326 6/A/B.

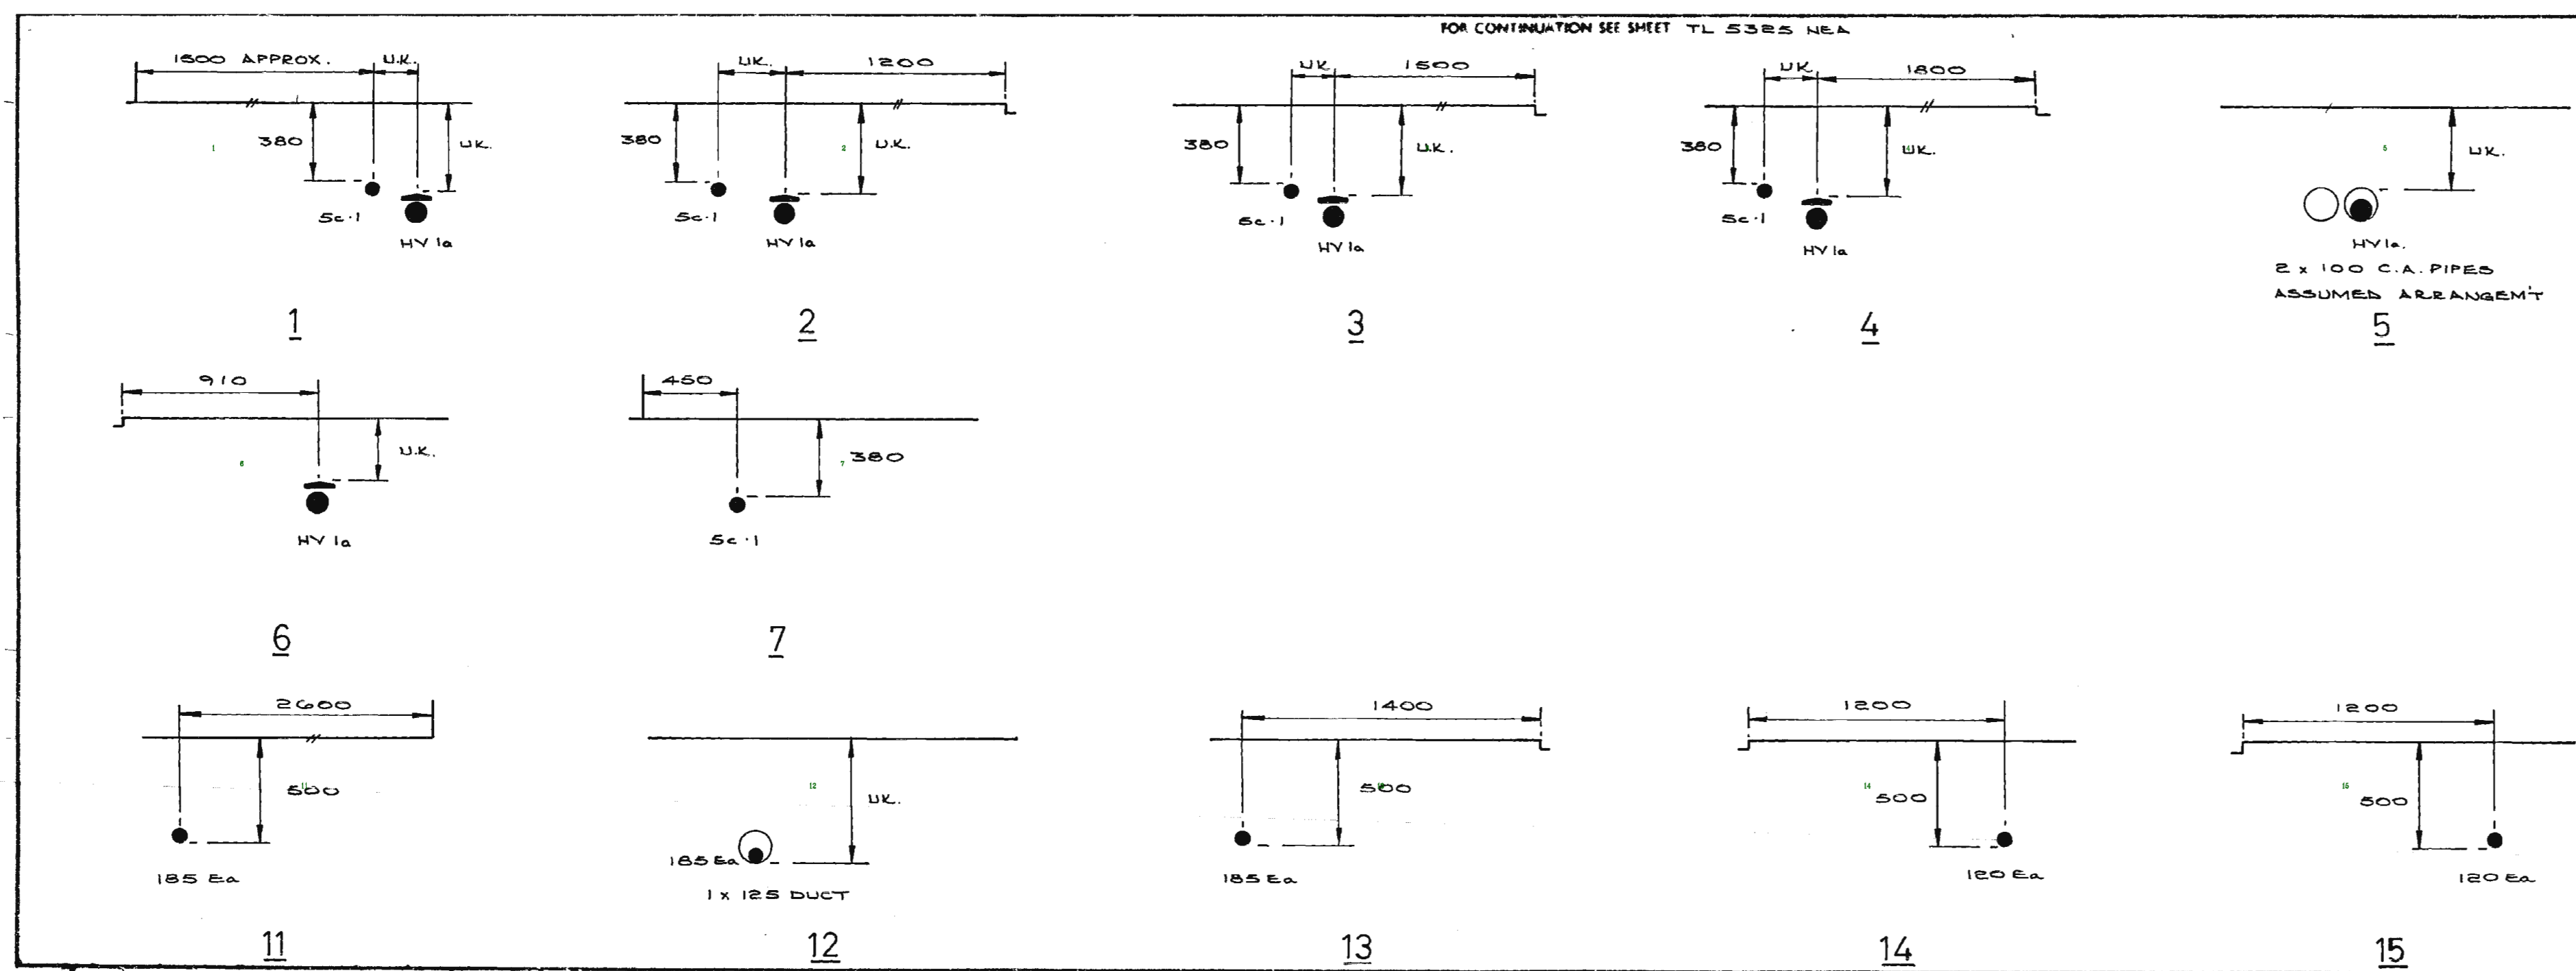

PILOT CABLES AND HIGH VOLTAGE CABLES

Serial numbers refer to this sheet only and lengths are to sheet edge.

No.	KV	Site	Cores	Designation	Length		No.	KV	Site	Cores	Designation	Length	
					metres	yards						metres	yards
	HV 16	ELSENHAM	2	ELSENHAM - POLE A / 1									
	HV 16	ELSENHAM	2	ELSENHAM - POLE B / 1									
	HV 16	ELSENHAM	2	ELSENHAM - POLE C / 1									
Total length							Total length						

NOTES (1) FOR FULL DETAILS OF (1) BY CABLES REFERENCE SHOULD BE MADE TO THE PRIMARY RECORDS.
 (2) E DENOTES CNE CABLE - DENOTES ALPEX TYPE.
 (3) ALL DEPTH SHOWN ARE AS LAD, SUBJECT TO FINAL LEVELS.
 (4) UK, MEANED UNKNOWN.



1: 500 SCALE LVG MAINS
 LOCATION
 ELSENHAM

DIMENSIONS IN MILLIMETRES	REPRODUCED FROM OR BASED UPON THE ORDINANCE SURVEY MAP WITH THE SANCTION OF THE CONTROLLER OF HIS STATIONERY OFFICE. CROWN COPYRIGHT RESERVED	SERVICES FOR DETAILS OF SERVICE CABLE REFERENCE SHOULD BE MADE TO THE SERVICE CARDS IN THE DISTRICT OFFICE.	SHEET NO. TL 5326 SEB	ISSUE B	DATE DEC 87
SUPPLEMENTARY SHEET NO.					


SO

TL5426SWA 1:500 LV

FOR CONTINUATION SEE SHEET TL 5426 NWB

FOR CONTINUATION SEE SHEET TL 5426 SEA

FOR CONTINUATION SEE SHEET TL 5426 SEA

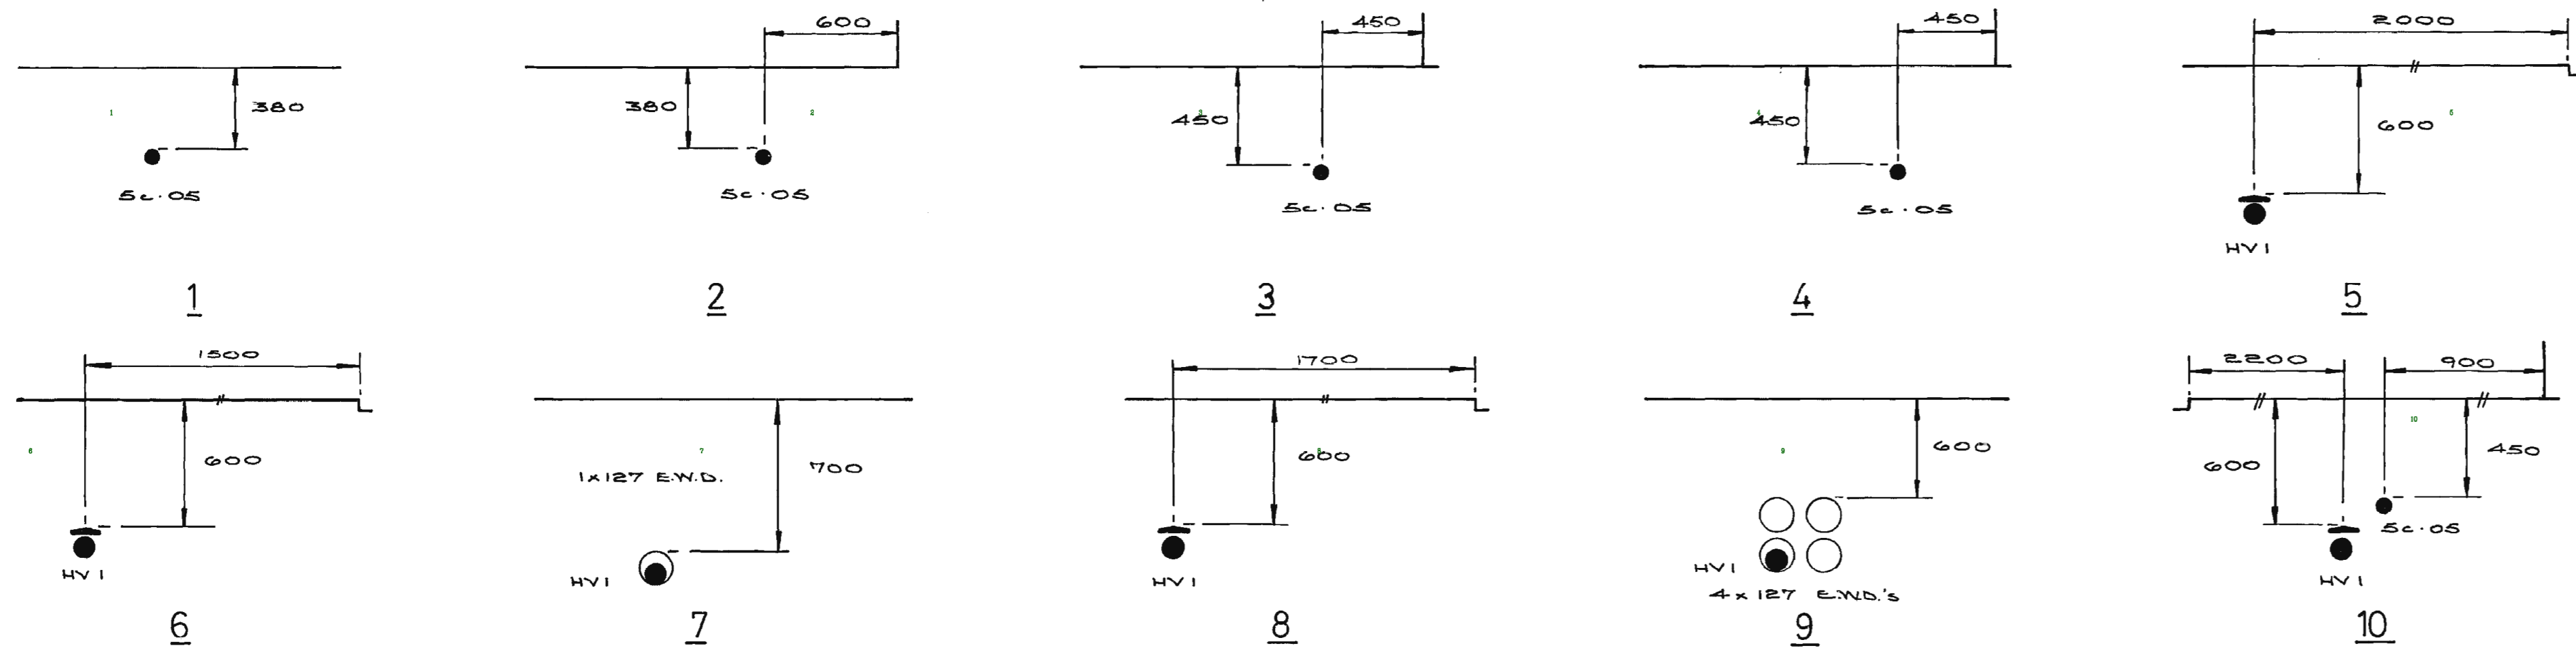

FOR CONTINUATION SEE SHEET TL 5426 SWB

PILOT CABLES AND HIGH VOLTAGE CABLES

Serial numbers refer to this sheet only and lengths are to sheet edge

No.	kV	Size	Cores	Designation	Lengths		No.	kV	Size	Cores	Designation	Lengths	
					metres	yards						metres	yards
											ELSENHAM PLACE TELL		
											ELSENHAM - POLE #/1	802	
Total length													

NOTES (1) FOR FULL DETAILS OF 33 kV CABLES REFERENCE SHOULD BE MADE TO THE PRIMARY RECORDS
 (2) E DENOTES CNE CABLE & DENOTES ALPEX TYPE
 (3) ALL DEPTHS SHOWN ARE AS LWD, SUBJECT TO FINAL LEVELS



1:500 SCALE U/G MAINS
 LOCATION ELSENHAM

DIMENSIONS IN MILLIMETRES
 REPRODUCED FROM OR BASED UPON THE ORDINANCE SURVEY MAP WITH THE SANCTION OF THE CONTROLLER OF HM STATIONERY OFFICE CROWN COPYRIGHT RESERVED
 SERVICES FOR DETAILS OF SERVICE LABEL REFERENCE SHOULD BE MADE TO THE SERVICE CARDS IN THE DISTRICT OFFICE
 SHEET NO TL 5426 SWA
 SUPPLEMENTARY SHEET NO
 ISSUE A
 DATE JAN. 87

TL 5426 SWA

SO


TL5426SWB 1:500 LV

FOR CONTINUATION SEE SHEET TL 5205 SEB


FOR CONTINUATION SEE SHEET TL 5426 SWA

FOR CONTINUATION OF SHEET TL 5426 SEB

FOR CONTINUATION SEE SHEET TL 5425 NWA

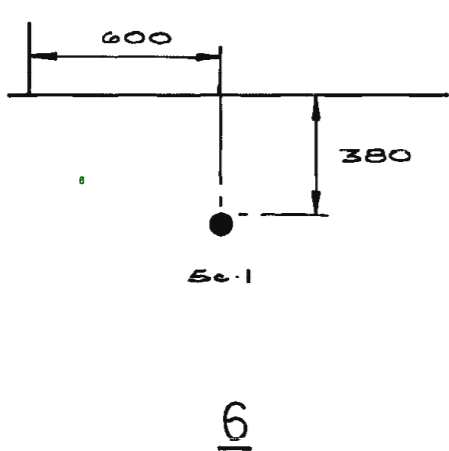

6

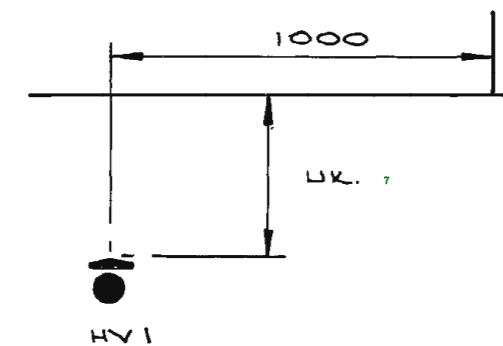

7

PILOT CABLES AND HIGH VOLTAGE CABLES

Serial numbers refer to this sheet only and lengths are to sheet edge

No	kV	Size	Cores	Designation	Lengths		No	kV	Size	Cores	Designation	Lengths	
					meters	feet						meters	feet
											ELSENHAM - POLE #/1		117
					Total length							Total length	

NOTES (1) FOR FULL DETAILS OF 33 kV CABLES REFERENCE SHOULD BE MADE TO THE PRIMARY RECORDS
 (2) E DENOTES CNE CABLE, DENOTES ALPEX TYPE
 (3) ALL SIZES AND SHOWN ARE AS LAYS, SUBJECT TO FINAL LEVELS
 (4) U.C. DENOTES



1:500 SCALE U/G MAINS

LOCATION ELSENHAM

DIMENSIONS IN MILLIMETRES

REPRODUCED FROM OR BASED UPON THE ORDNANCE SURVEY MAP WITH THE SANCTION OF THE CONTROLLER OF HIS STATIONERY OFFICE. CROWN COPYRIGHT RESERVED

SERVICES FOR DETAILS OF SERVICE LABELS REFERENCE SHOULD BE MADE TO THE SERVICE CARDS IN THE CONTACT OFFICE

SHEET NO TL 5426 SWB
 SUPPLEMENTARY SHEET NO

ISSUE A
 DATE MAY 86

TL 5426 SWB