
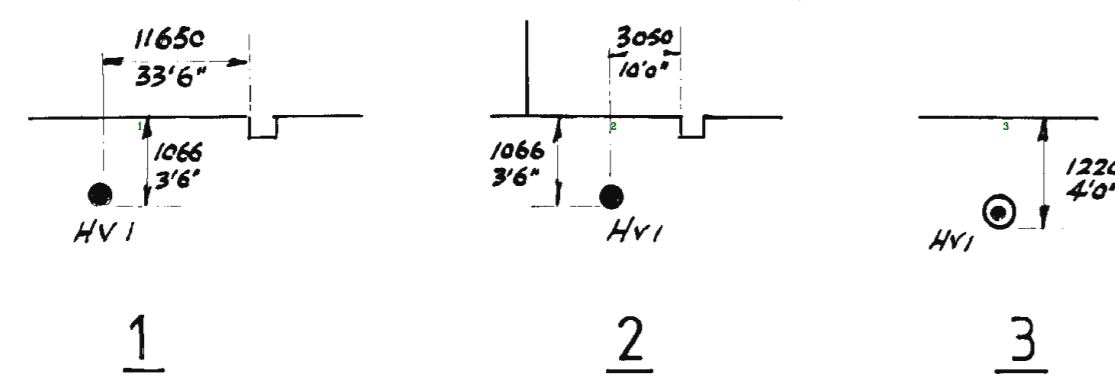


SO

TL4528NEB 1:500 LV

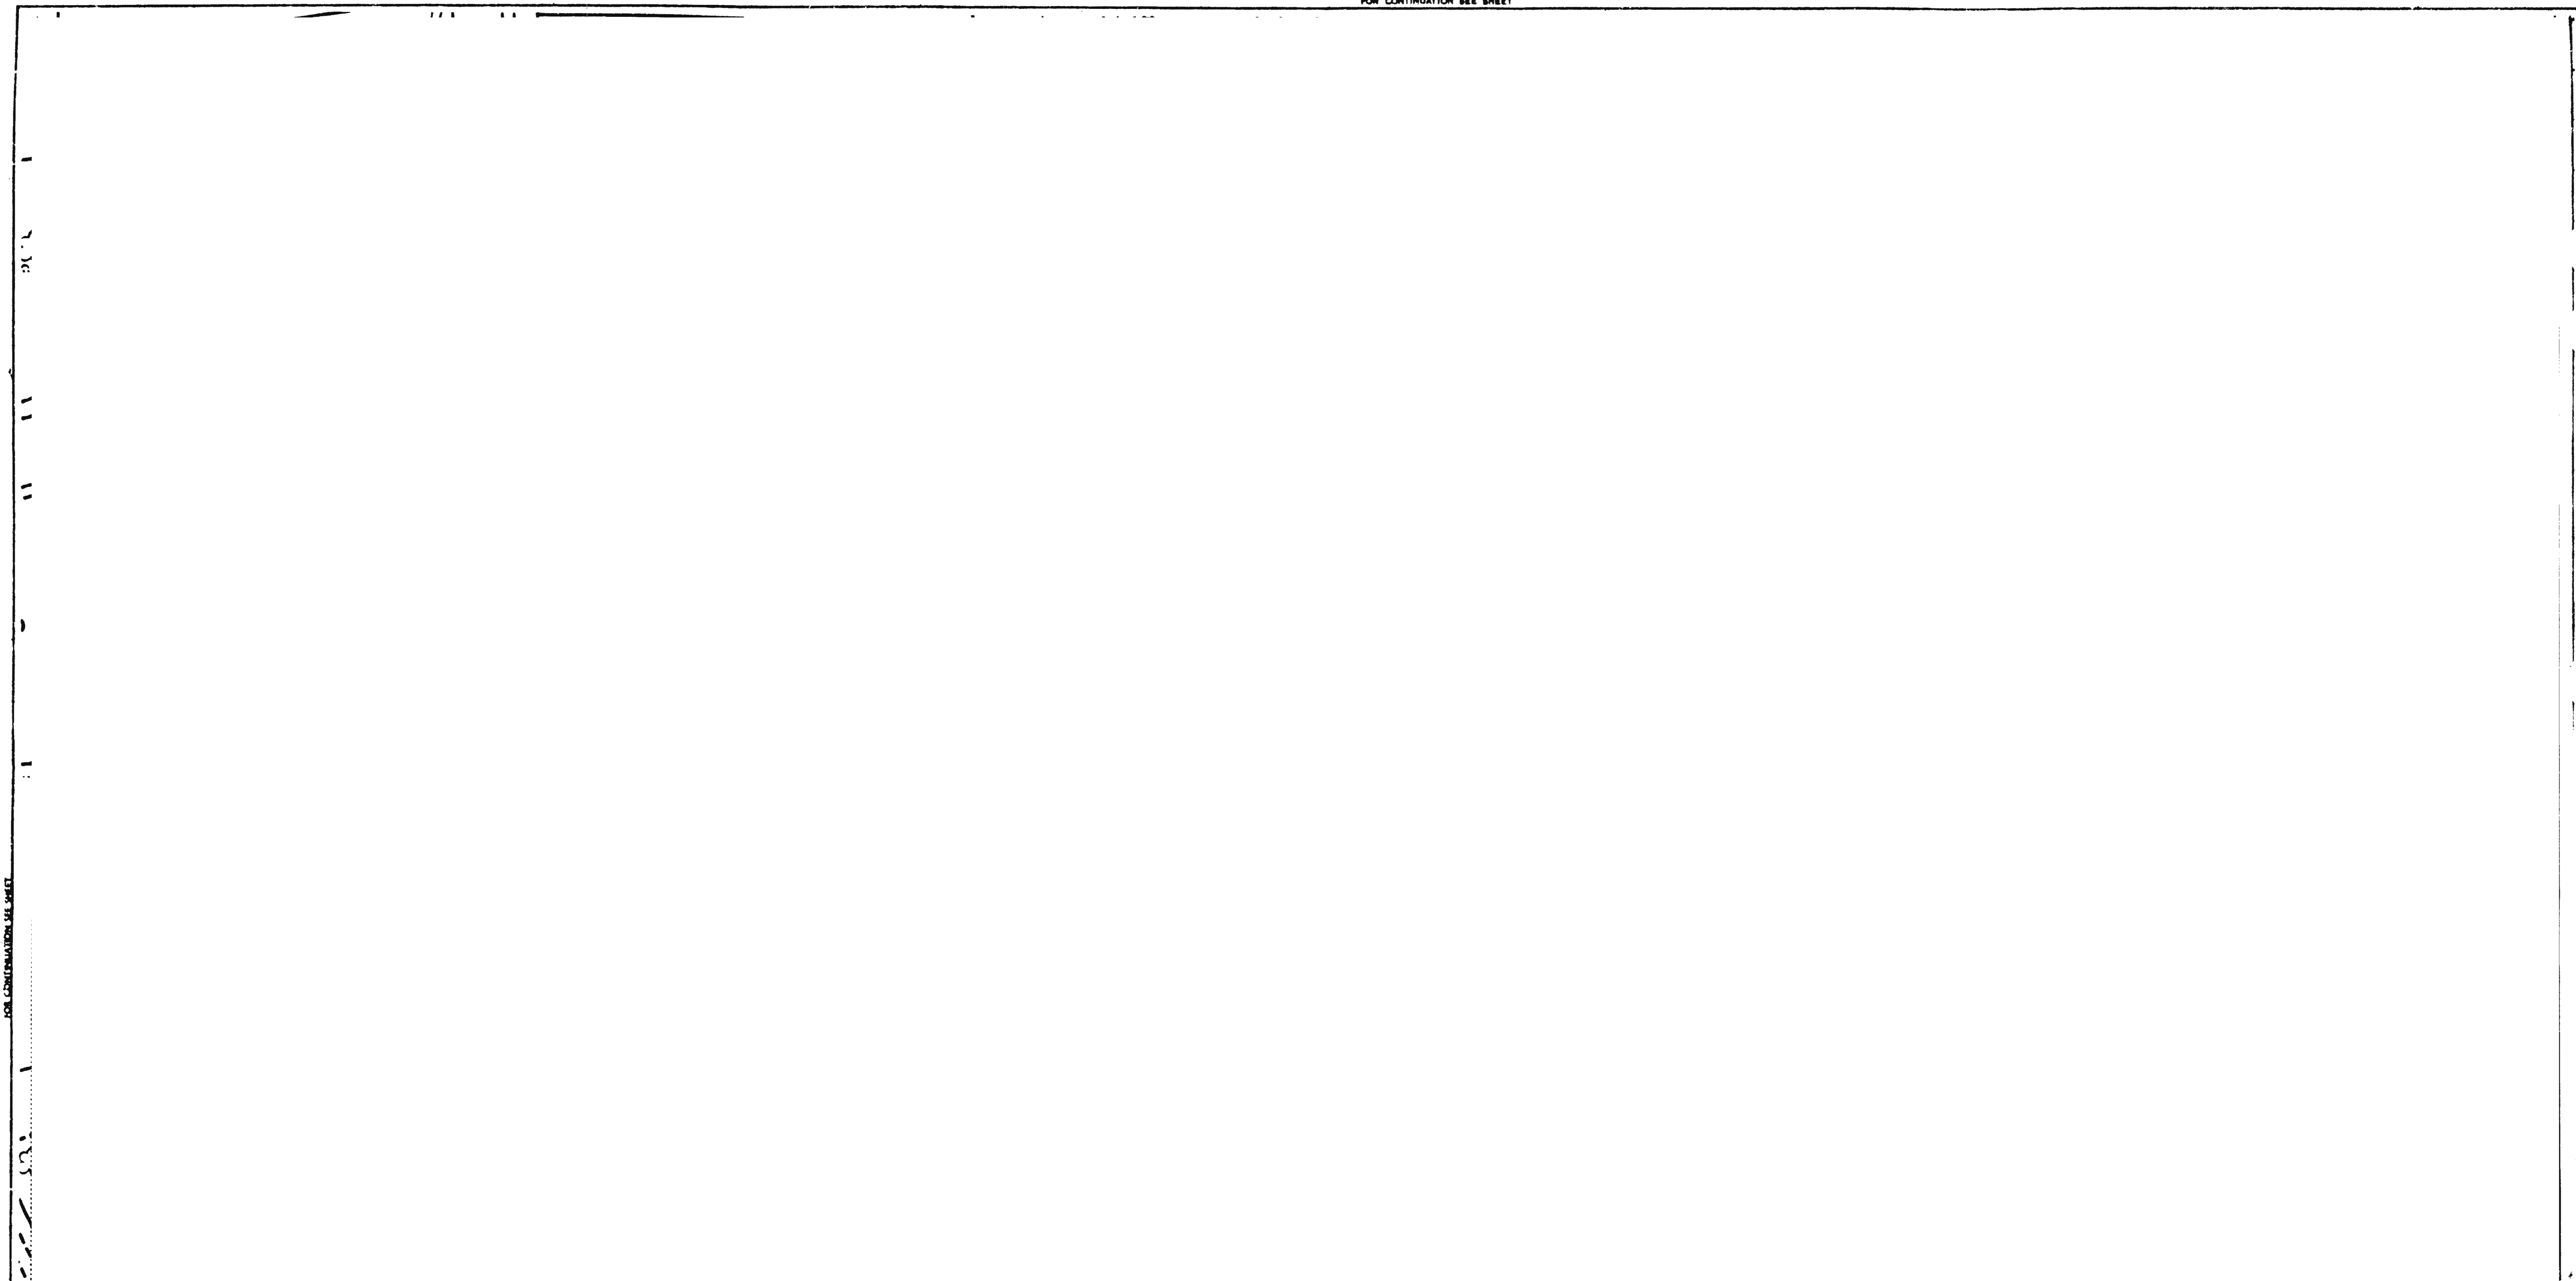


FOR CONTINUATION SEE SHEET

PILOT CABLES AND HIGH VOLTAGE CABLES

Serial numbers refer to this sheet only and lengths are to sheet edge

No.	kV	Size	Cores	Designation	Lengths		No.	kV	Size	Cores	Designation	Lengths	
					metre	yards						metre	yards
1	11	10	3	PELHAM 000 - PELHAM 000 BATTERY STORAGE			1	11	10	3	POLE 33 - PELHAM 400KV SITE	247	270
					Total length							Total length	

NOTES (1) FOR FULL DETAILS OF 33 kV CABLES REFERENCE SHOULD BE MADE TO THE PRIMARY RECORDS
(2) E DENOTES CNE CABLE - DENOTES ALPEX TYPE

eastern electricity 



1:500 SCALE U/G MAPS
LOCATION PELHAM

DIMENSIONS IN MILLIMETRES	REPRODUCED FROM OR BASED UPON THE ORDINANCE SURVEY MAP WITH THE SANCTION OF THE CONTROLLER OF HM STATIONERY OFFICE. CROWN COPYRIGHT RESERVED	SERVICES FOR DETAILS OF SERVICE CABLE REFERENCE SHOULD BE MADE TO THE SERVICE CARDS IN THE DISTRICT OFFICE	SHEET NO TL4528NEB.s0 SUPPLEMENTARY SHEET NO	ISSUE A	DATE 07-08-01
---------------------------	--	--	---	---------	---------------

SO

TL4528SEA 1:500 LV

FOR CONTINUATION SEE SHEET TL 4528 SEA

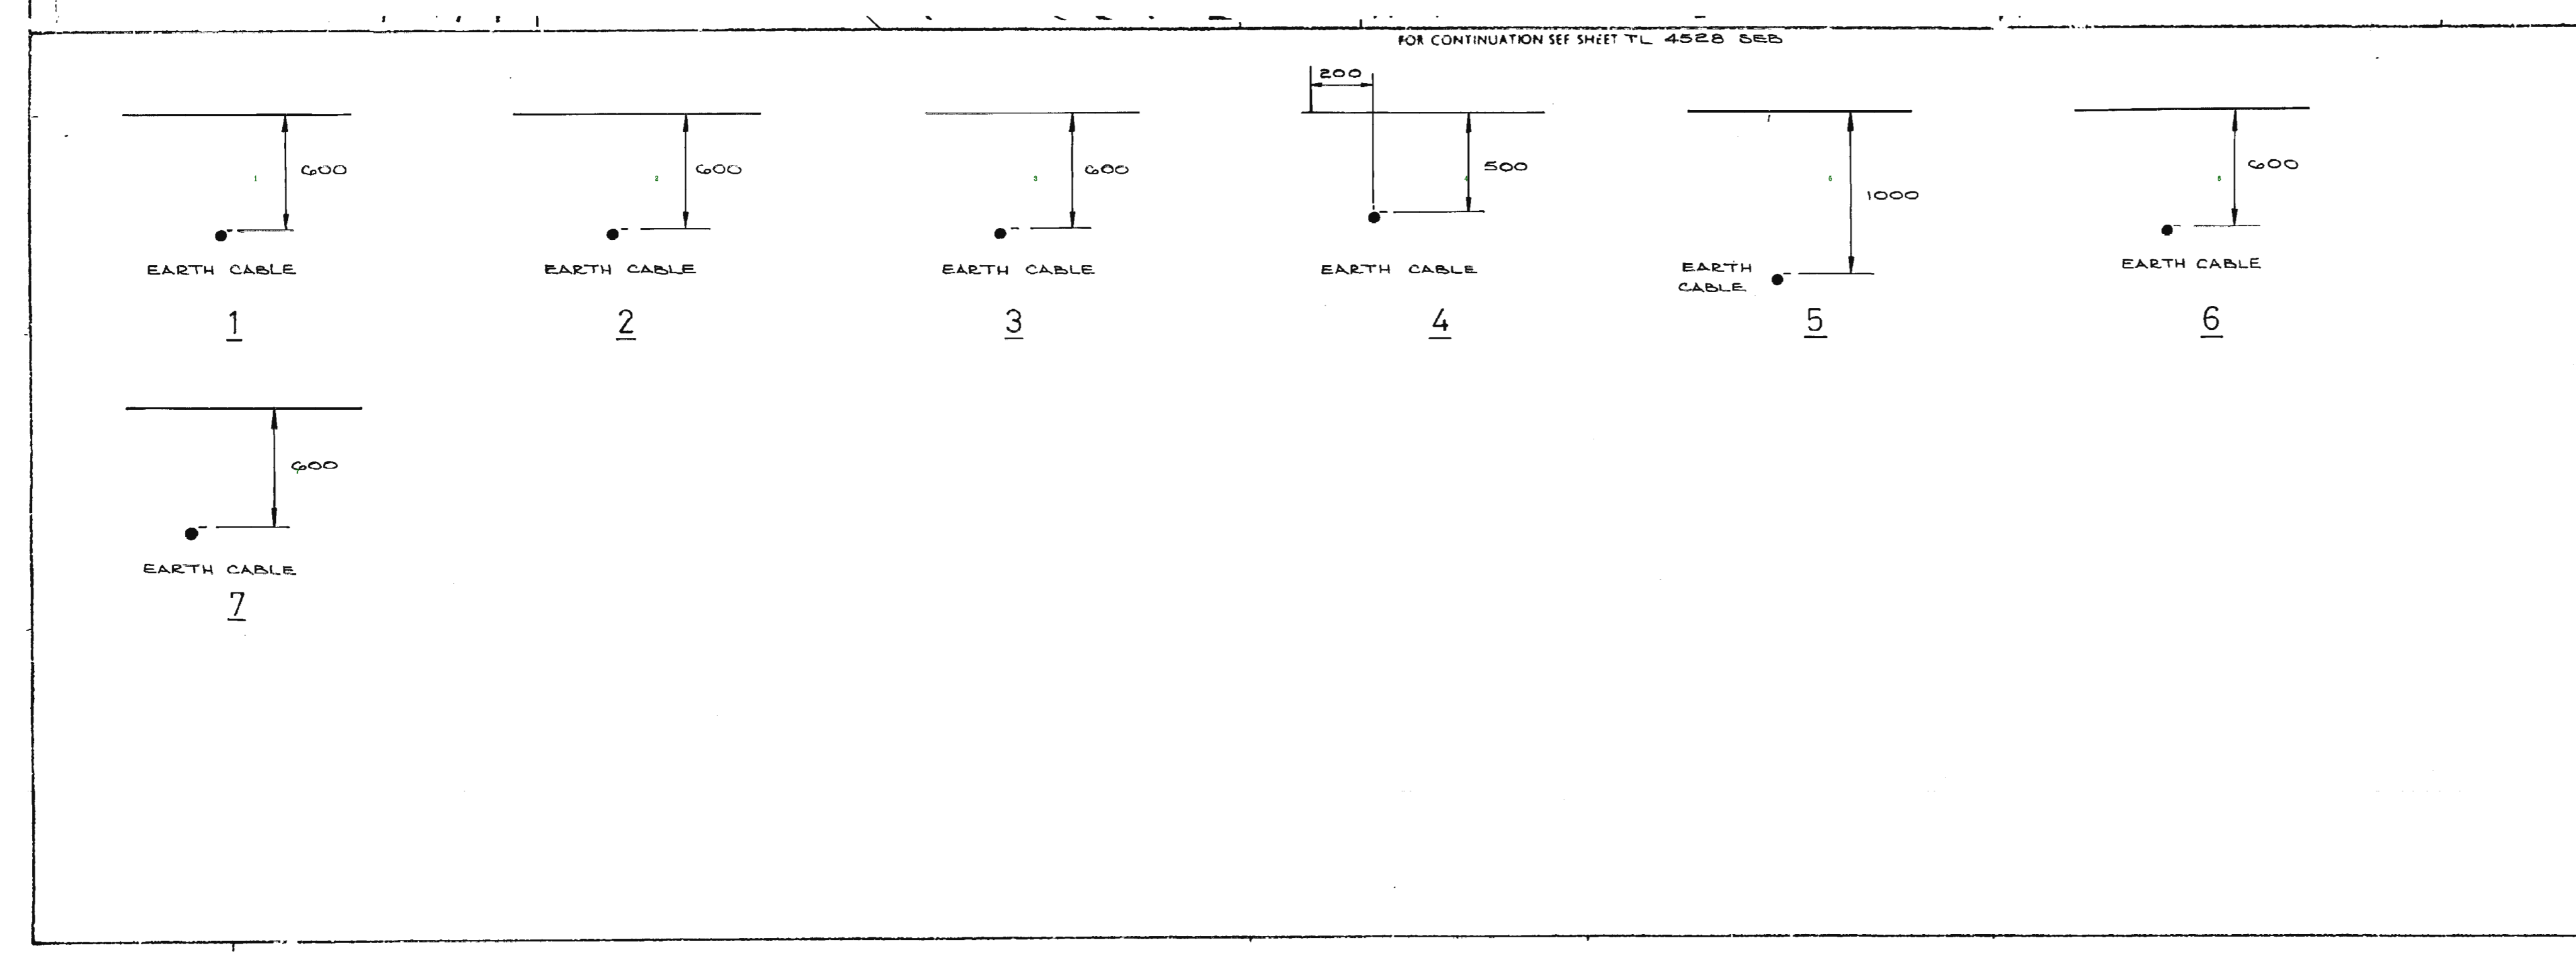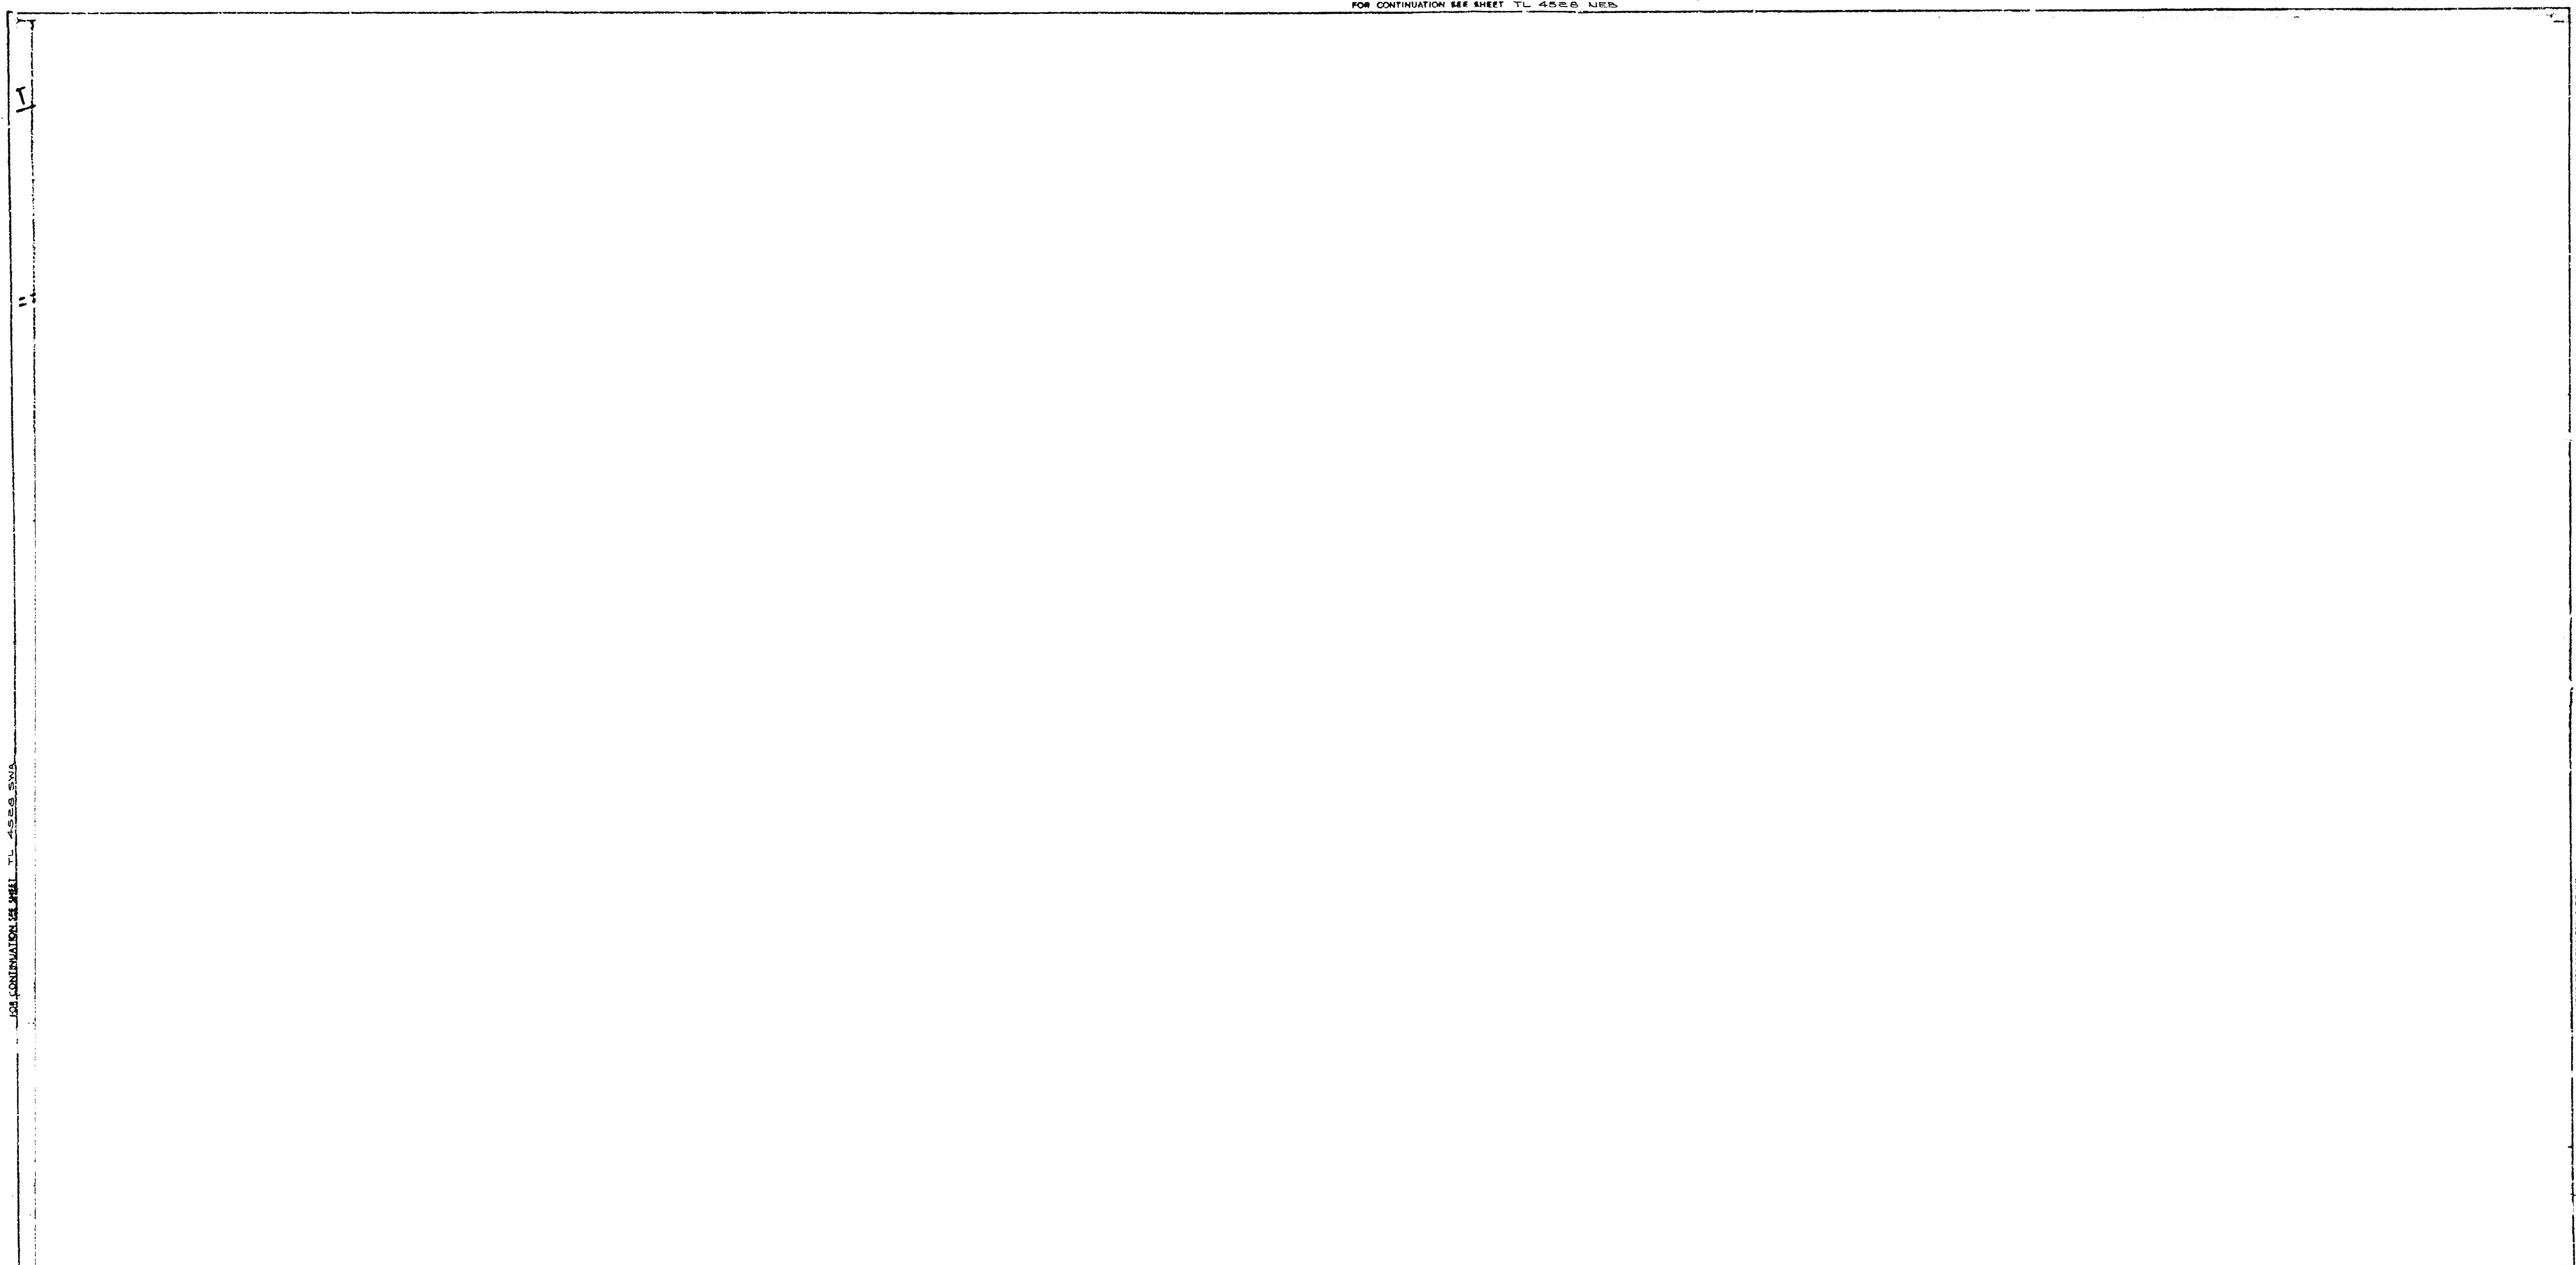

PILOT CABLES AND HIGH VOLTAGE CABLES

Serial numbers refer to this sheet only and lengths are to sheet edge

No	kV	Size	Cores	Designation	Lengths		No	kV	Size	Cores	Designation	Lengths	
					metres	yards						metres	yards
HW504	FIBRE			PELHAM GRID - PELHAM GRID BATTERY STORAGE			HW504	132	3000	3/0	PELHAM GRID - PELHAM GRID BATTERY STORAGE		
							HW3	132			PELHAM - T.PCB 234 (THATTS D)		
							HW4	132			IBLE		
							HW202	132	0.40	3/0	PELHAM TO TOWER PCB 1 CIRCUIT NO.1 (BISHOP STATIONERS)		
							HW203	132	0.40	3/0	PELHAM TO TOWER PCB 1 CIRCUIT NO.2 (BISHOP STATIONERS)		
							HW207	132	0.75	3/0	PELHAM TO TOWER PCB 234 CIRCUIT NO.1 (ANNONKLEY / STEVENAGE)		
							HW208	132	0.75	3/0	PELHAM TO TOWER PCB 234 CIRCUIT NO.2 (ANNONKLEY / STEVENAGE)		
							HW211	132	0.75	3/0	PELHAM TO TOWER PCB 234 CIRCUIT NO.1 (CHAYED)		
							HW212	132	0.75	3/0	PELHAM TO TOWER PCB 234 CIRCUIT NO.2 (CHAYED)		
					Total length							Total length	

NOTES (1) FOR FULL DETAILS OF 33 kV CABLES REFERENCE SHOULD BE MADE TO THE PRIMARY RECORDS
 (2) E DENOTES CNE CABLE & DENOTES ALPEX TYPE
 (3) ALL DEPTHS SHOWN ARE AS LAID, SUBJECT TO FINAL LEVELS.

eastern electricity



1:500 SCALE LV/G MAINS

LOCATION: FURNEUX PELHAM

DIMENSIONS IN MILLIMETRES	APPROVED FROM OR BASED UPON THE ORDINANCE SURVEY MAP WITH THE SANCTION OF THE CONTROLLER OF HM STATIONERS OFFICE. CROWN COPYRIGHT RESERVED.	SERVICES FOR DETAILS OF SERVICE CABLES REFERENCE SHOULD BE MADE TO THE SERVICE CARDS IN THE DISTRICT OFFICE.	SHEET NO TL 4528 SEA SUPPLEMENTARY SHEET NO	ISSUE A	DATE NOV 84
---------------------------	---	--	---	------------	----------------

TL 4528 SEA

FOR CONTINUATION SEE SHEET

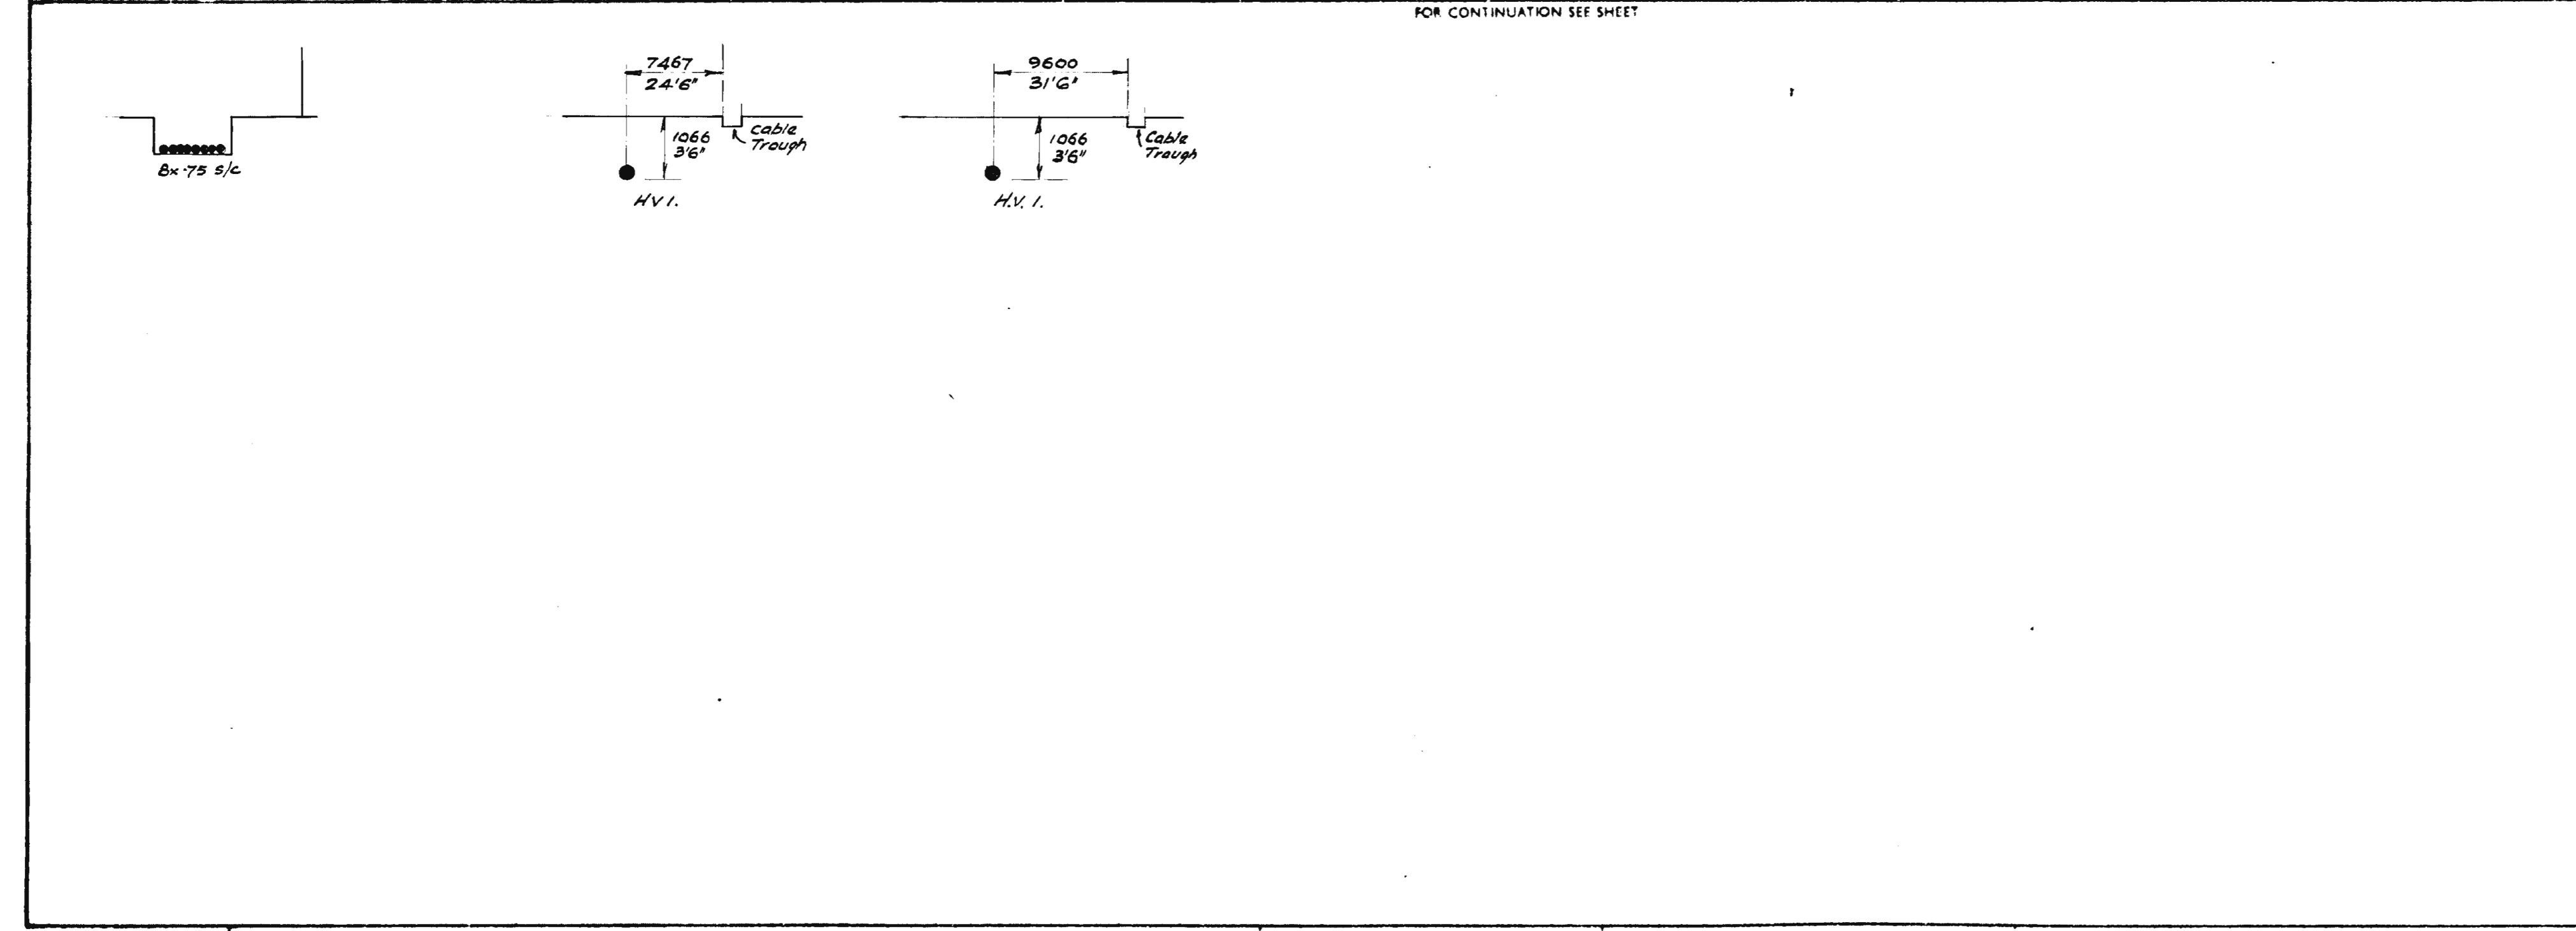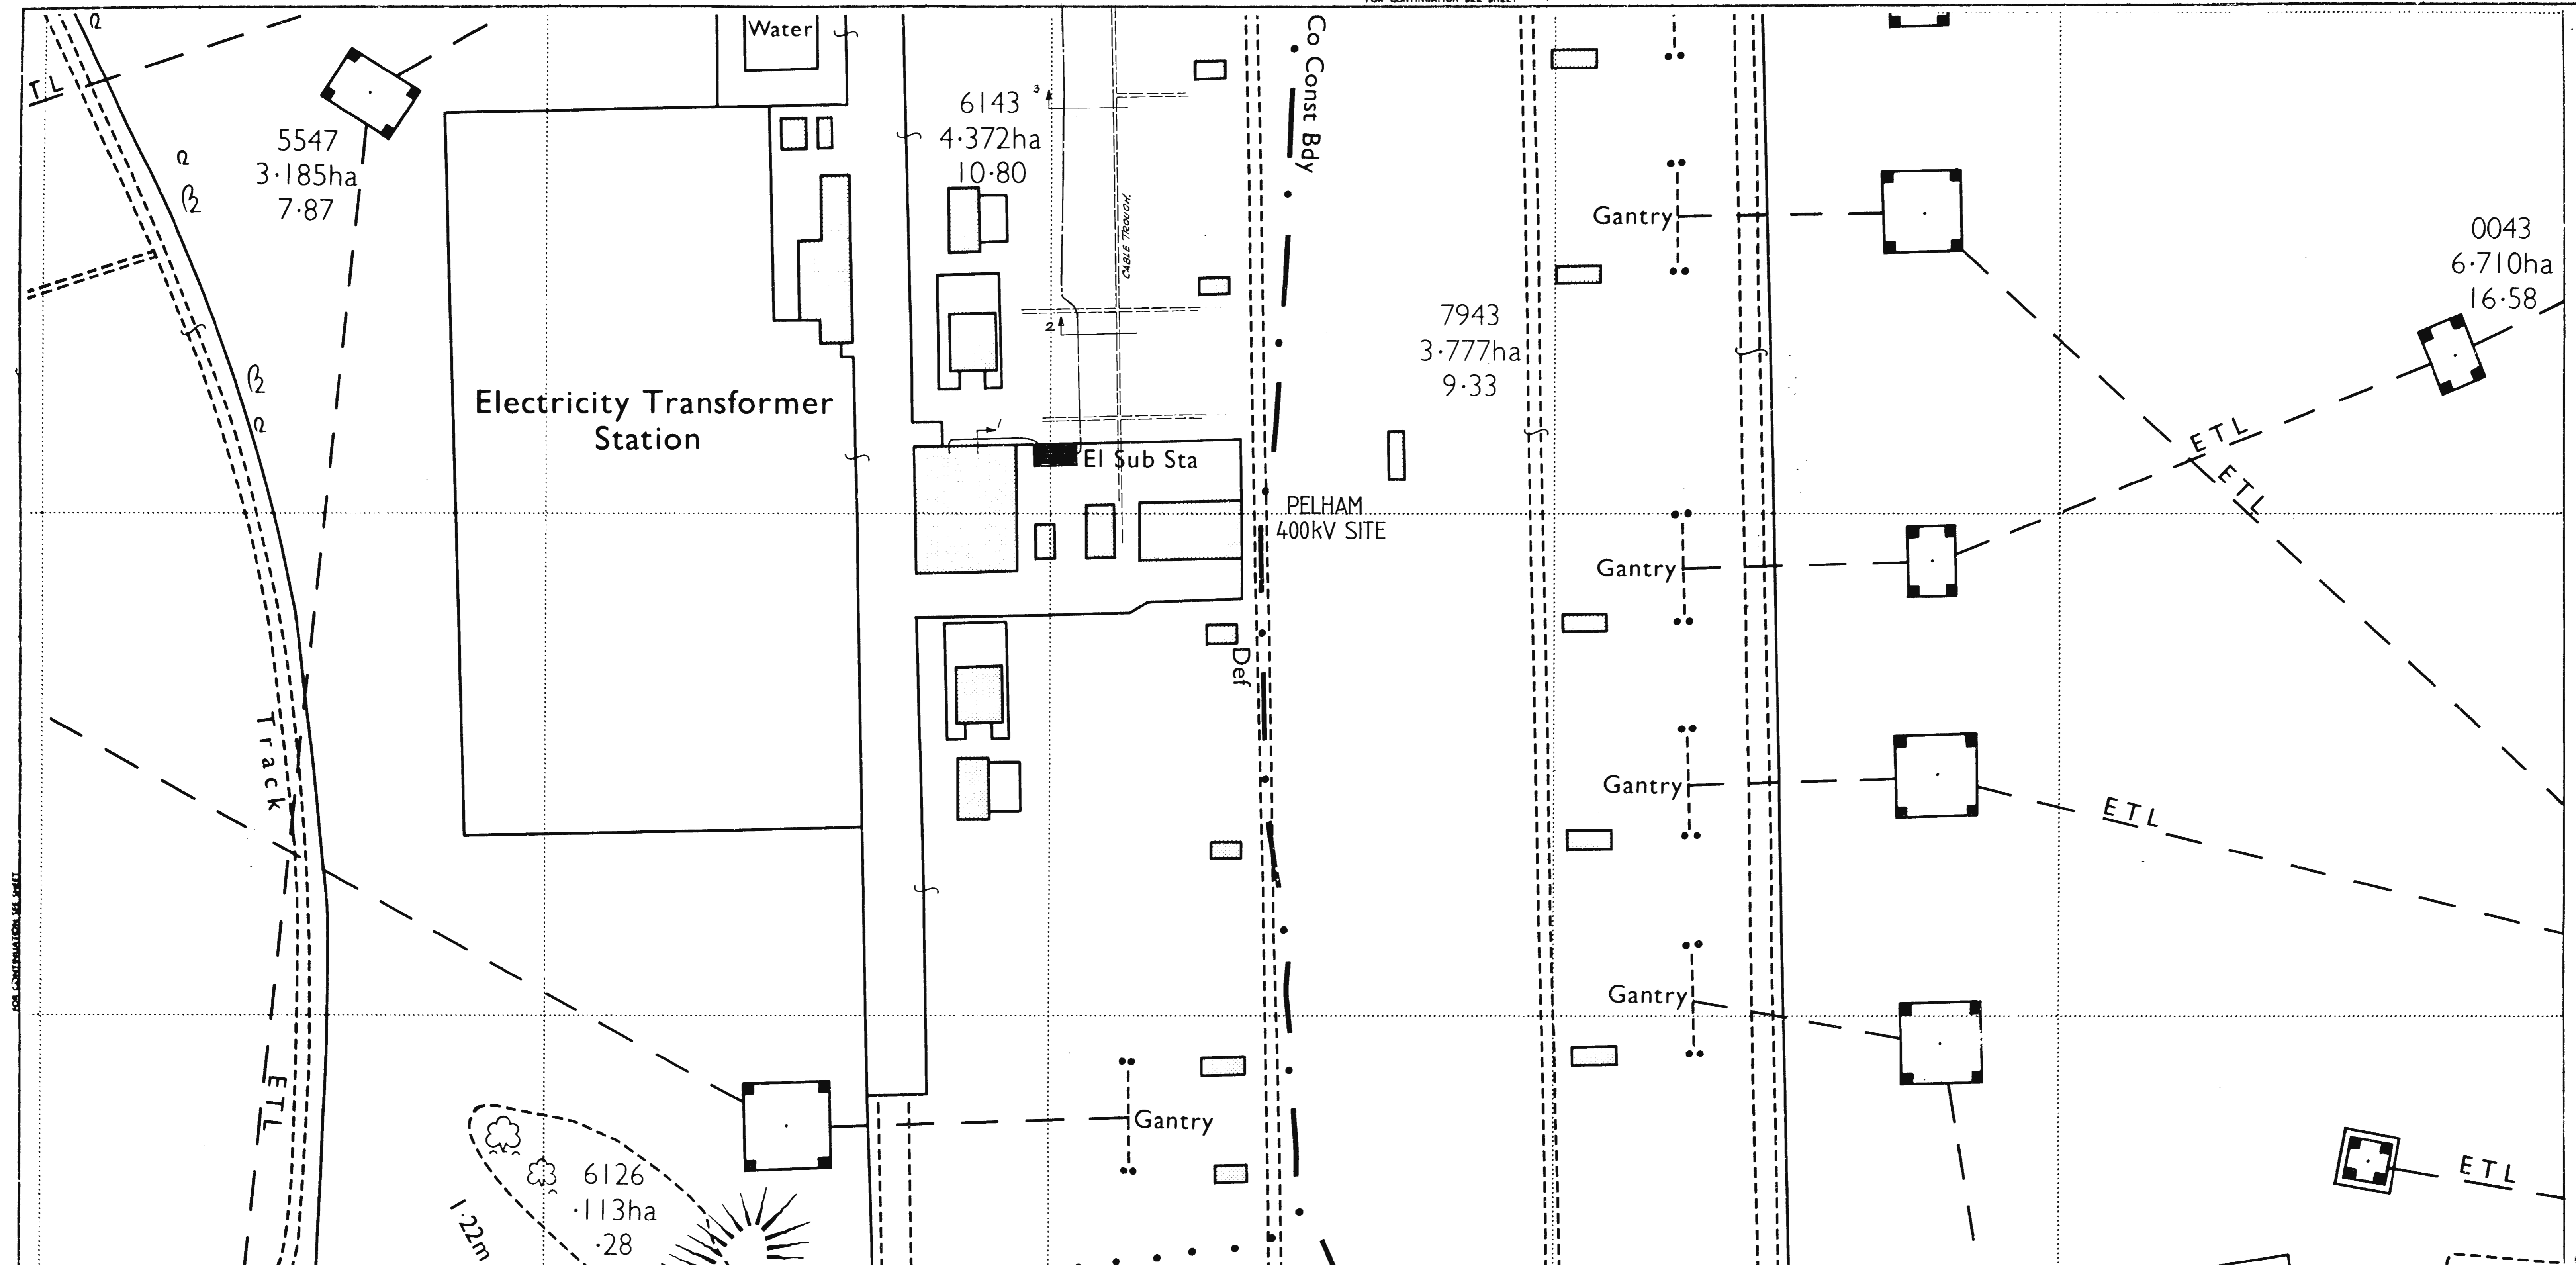

PILOT CABLES AND HIGH VOLTAGE CABLES

Serial numbers refer to this sheet only and lengths are to sheet edge

No.	kV	Size	Cores	Designation	Lengths		No.	kV	Size	Cores	Designation	Lengths	
					mets.	feet.						mets.	feet.
							1	11	40	3	POLE B3 - PELHAM ARBORE SITE.		
Total length												Total length	

NOTES (1) FOR FULL DETAILS OF 33 kV CABLES REFERENCE SHOULD BE MADE TO THE PRIMARY RECORDS
(2) E DENOTES CNE CABLE & DENOTES ALPEX TYPE

eastern electricity

1:500 SCALE U/G MAINS

LOCATION **PELHAM**

SHEET NO
TL 4528 SEA

SUPPLEMENTARY SHEET NO


ISSUE

DATE

DIMENSIONS IN MILLIMETRES REPRODUCED FROM OR BASED UPON THE ORDINANCE SURVEY PLAN WITH THE SANCTION OF THE CONTROLLER OF HM STATIONERY OFFICE CROWN COPYRIGHT RESERVED SERVICES FOR DETAILS OF SERVICE CABLE REFERENCE SHOULD BE MADE TO THE SERVICE CAPS IN THE DISTRICT OFFICE

TL4529SEA 1:500 LV

SO

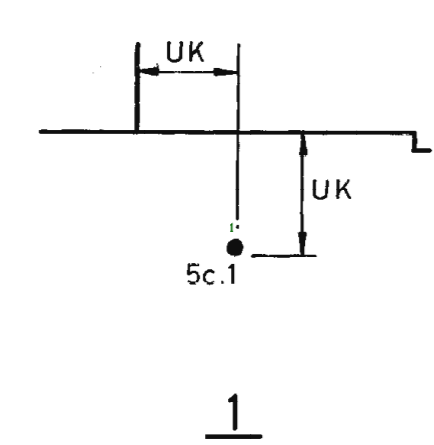

PILOT CABLES AND HIGH VOLTAGE CABLES

Serial numbers refer to this sheet only and lengths are to sheet edge

No.	kV	Size	Cores	Designation	Lengths		No.	kV	Size	Cores	Designation	Lengths	
					metres	yards						metres	yards

NOTES (1) FOR FULL DETAILS OF 33 kV CABLES REFERENCE SHOULD BE MADE TO THE PRIMARY RECORDS
 (2) E DENOTES CNE CABLE - DENOTES ALPEx TYPE
 (3) ALL DEPTHS SHOWN ARE AS LAID, SUBJECT TO FINAL LEVELS.
 (4) UK DENOTES UNKNOWN.

eastern electricity

1:500 SCALE U/G MAINS

LOCATION STOCKING PELHAM

DIMENSIONS IN MILLIMETRES	REPRODUCED FROM OR BASED UPON THE ORDINANCE SURVEY MAP WITH THE SANCTION OF THE CONTROLLER OF H.M. STATIONERY OFFICE CROWN COPYRIGHT RESERVED	SERVICES FOR DETAILS OF SERVICE CABLE REFERENCE SHOULD BE MADE TO THE SERVICE CARDS IN THE DISTRICT OFFICE	SHEET NO TL 4529 SEA SUPPLEMENTARY SHEET NO	ISSUE A DATE NOV 90
---------------------------	---	--	--	------------------------



FOR COMPLETION SEE SHEET TL 4529 SWA

TL 4529 SEA

S0

TL4629NEA 1:500 LV

FOR CONTINUATION SEE SHEET 4629 NEB

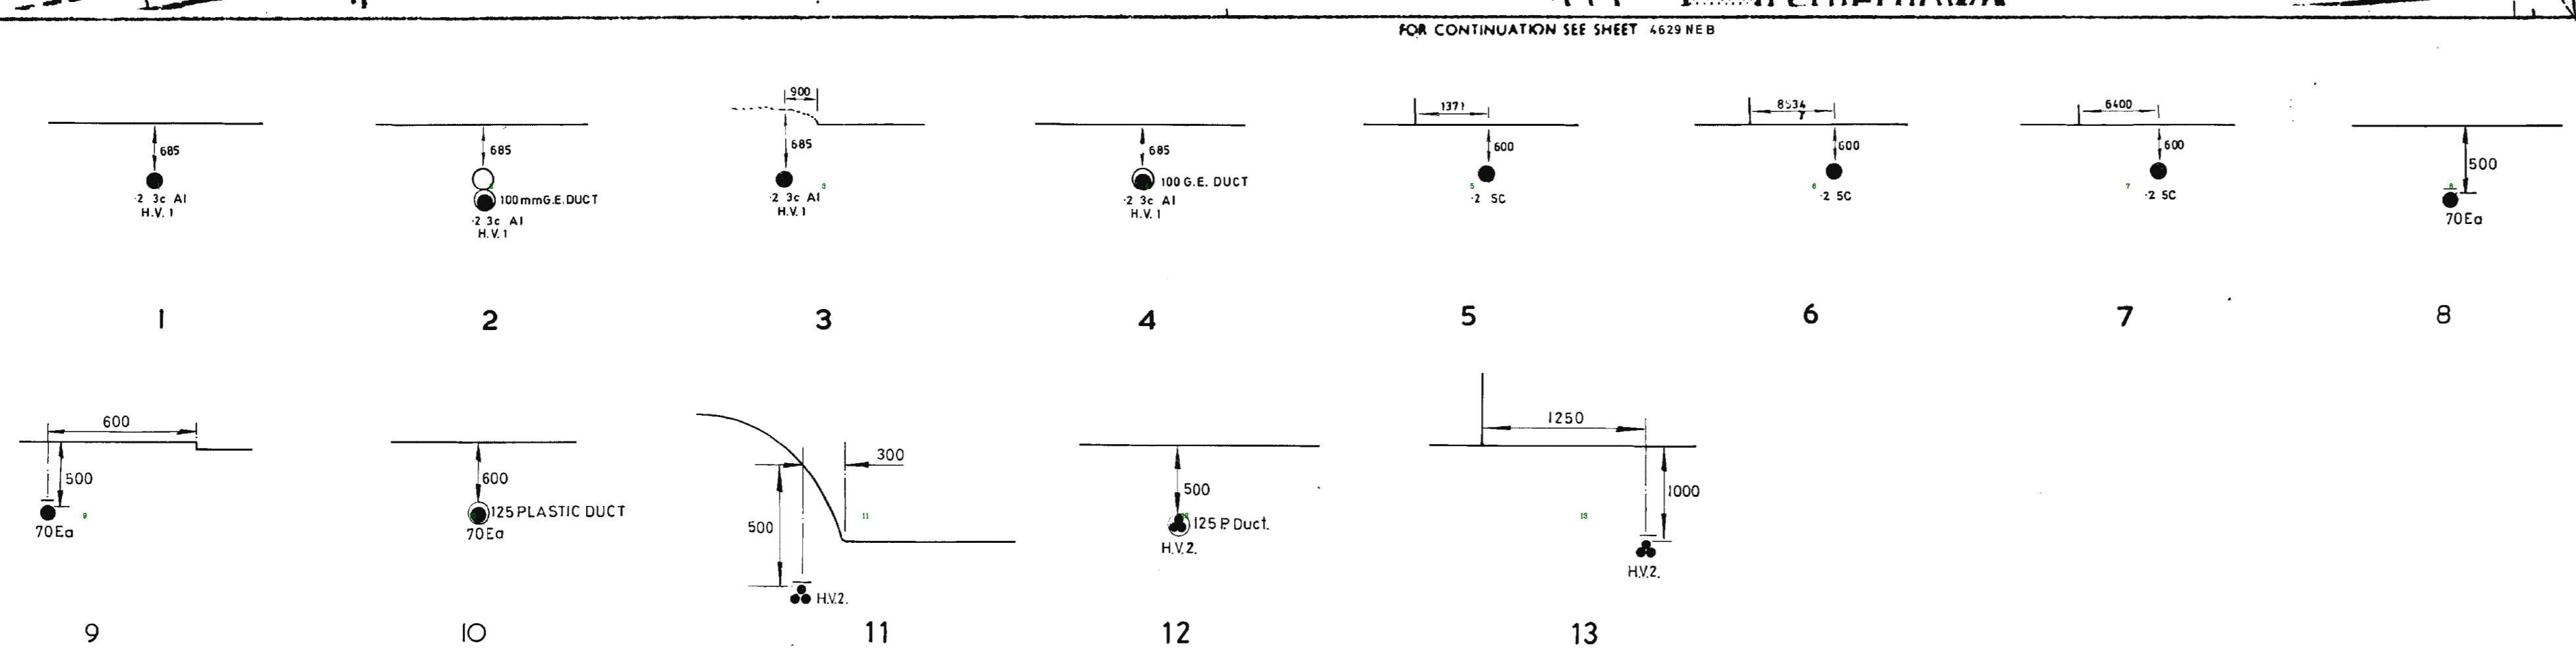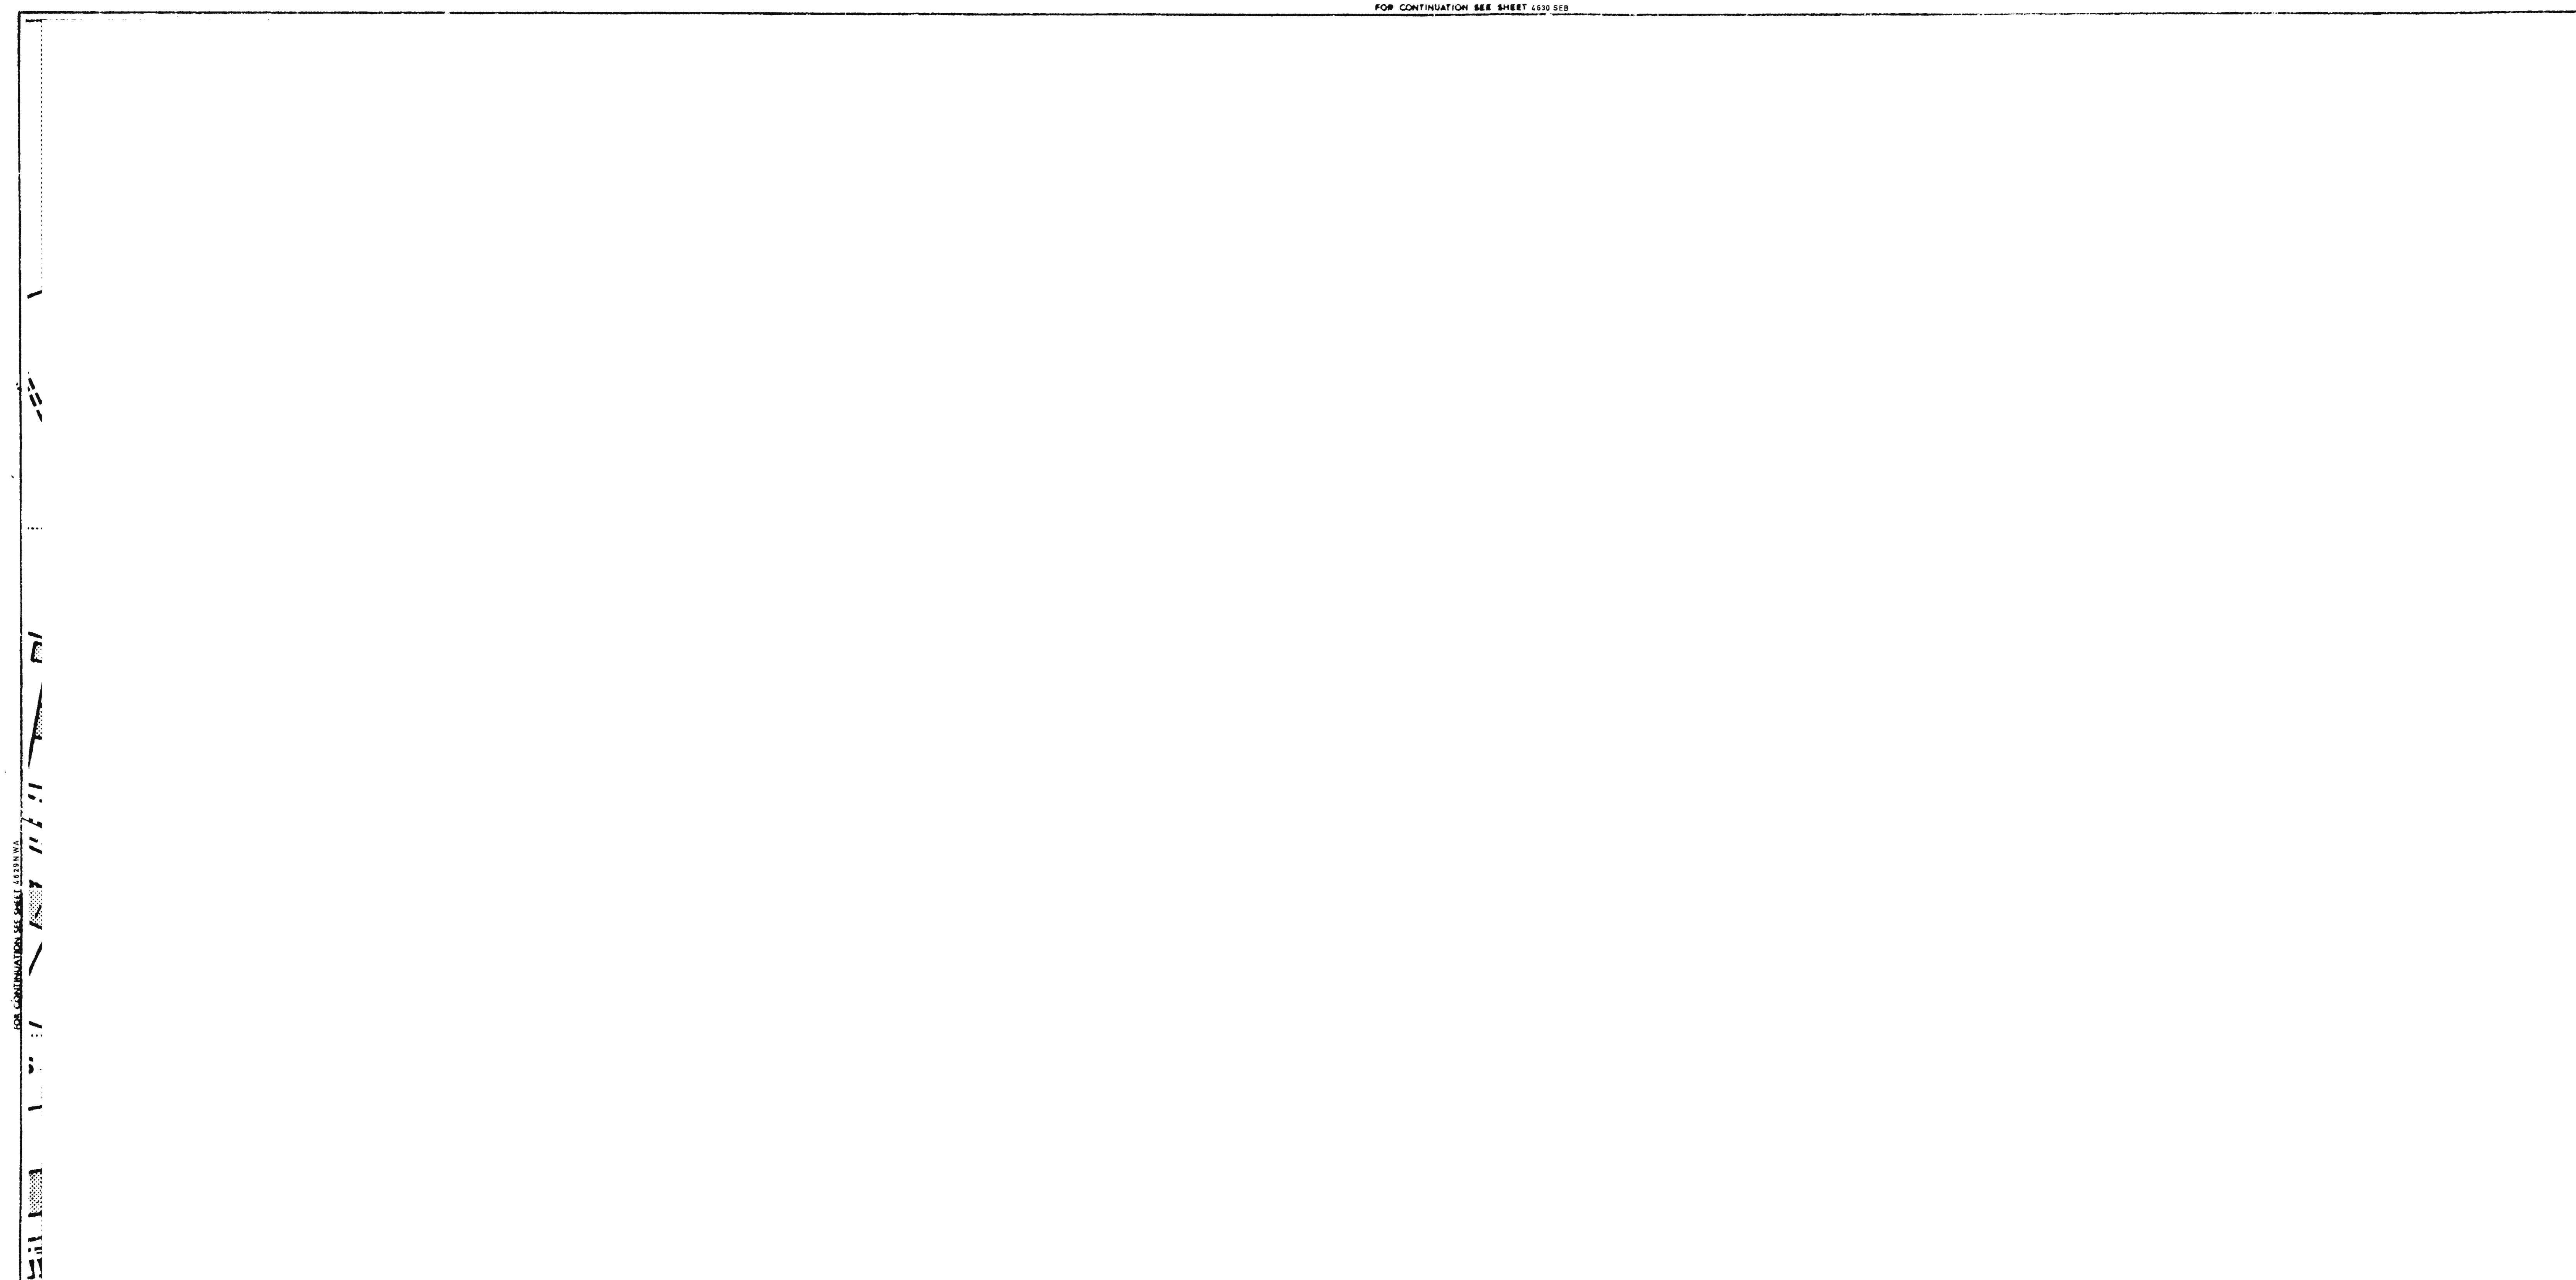

PILOT CABLES AND HIGH VOLTAGE CABLES													
Serial numbers refer to this sheet only and lengths are to sheet edge													
No.	kV	Size	Cores	Designation	Lengths		No.	kV	Size	Cores	Designation	Lengths	
					metres	yards						metres	yards
											H.V. POLE 2		
											H.V. POLE 3		
											H.V. POLE 2 - Benskins Close S/S		

NOTES (1) FOR FULL DETAILS OF 33 kV CABLES REFERENCE SHOULD BE MADE TO THE PRIMARY RECORDS
 (2) E DENOTES CNE CABLE - DENOTES ALPHEX TYPE



1:500 SCALE LV/G MAINS
 LOCATION: BERDEN



SHEET NO TL 4629 NEA
 SUPPLEMENTARY SHEET NO

TL 4629 NEA

SO

TL4629NEB 1:500 LV

FOR CONTINUATION SEE SHEET 4629NEA

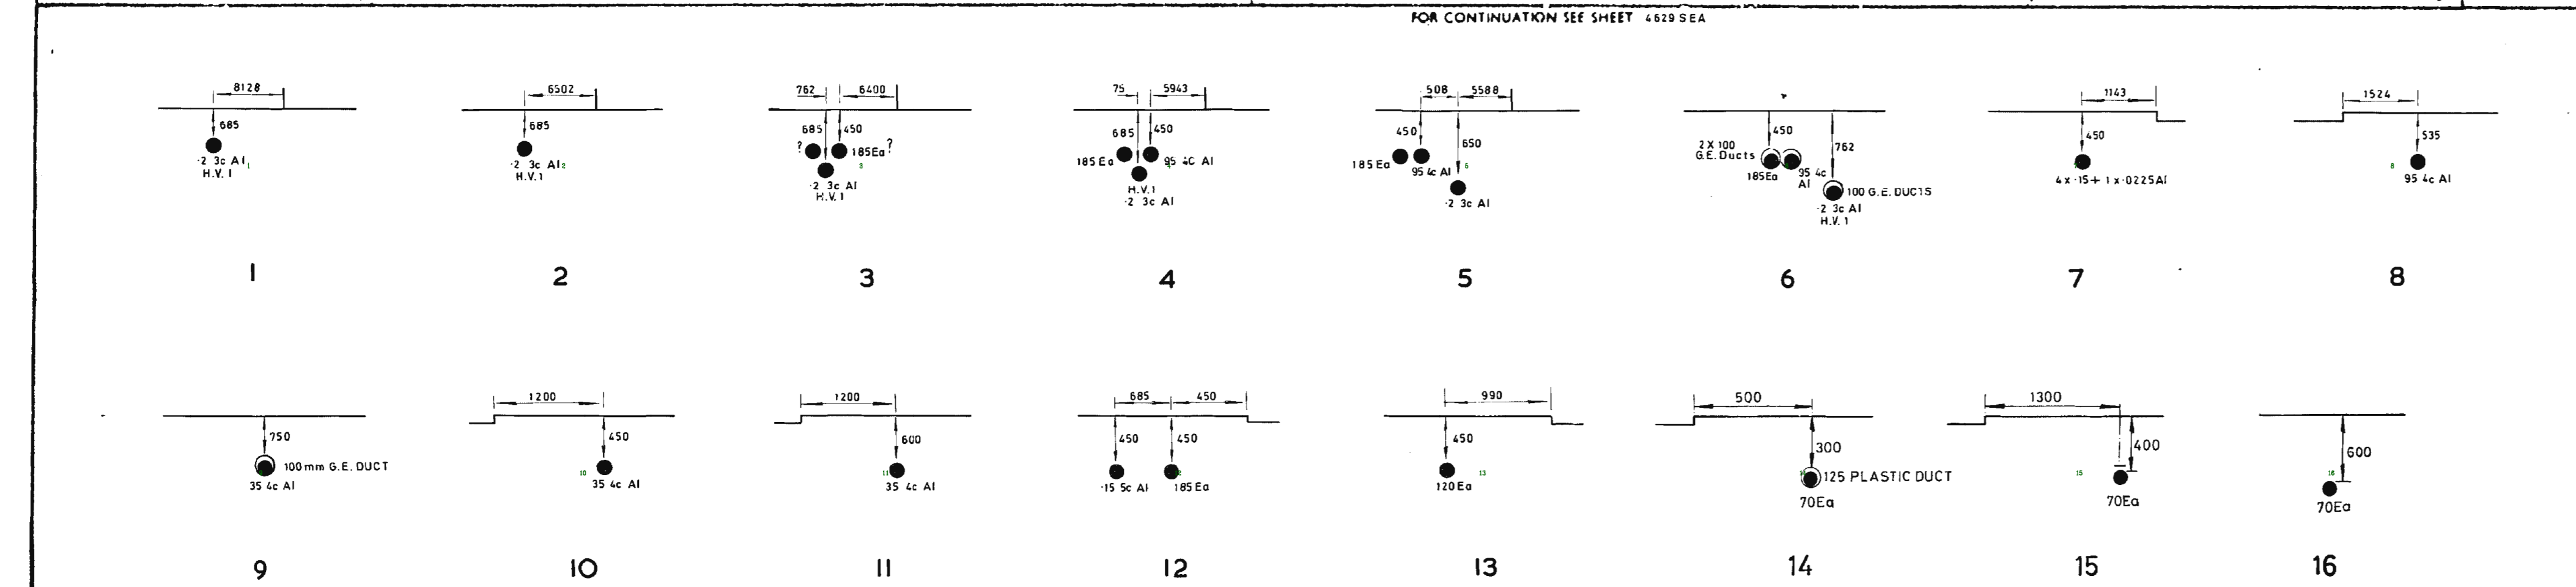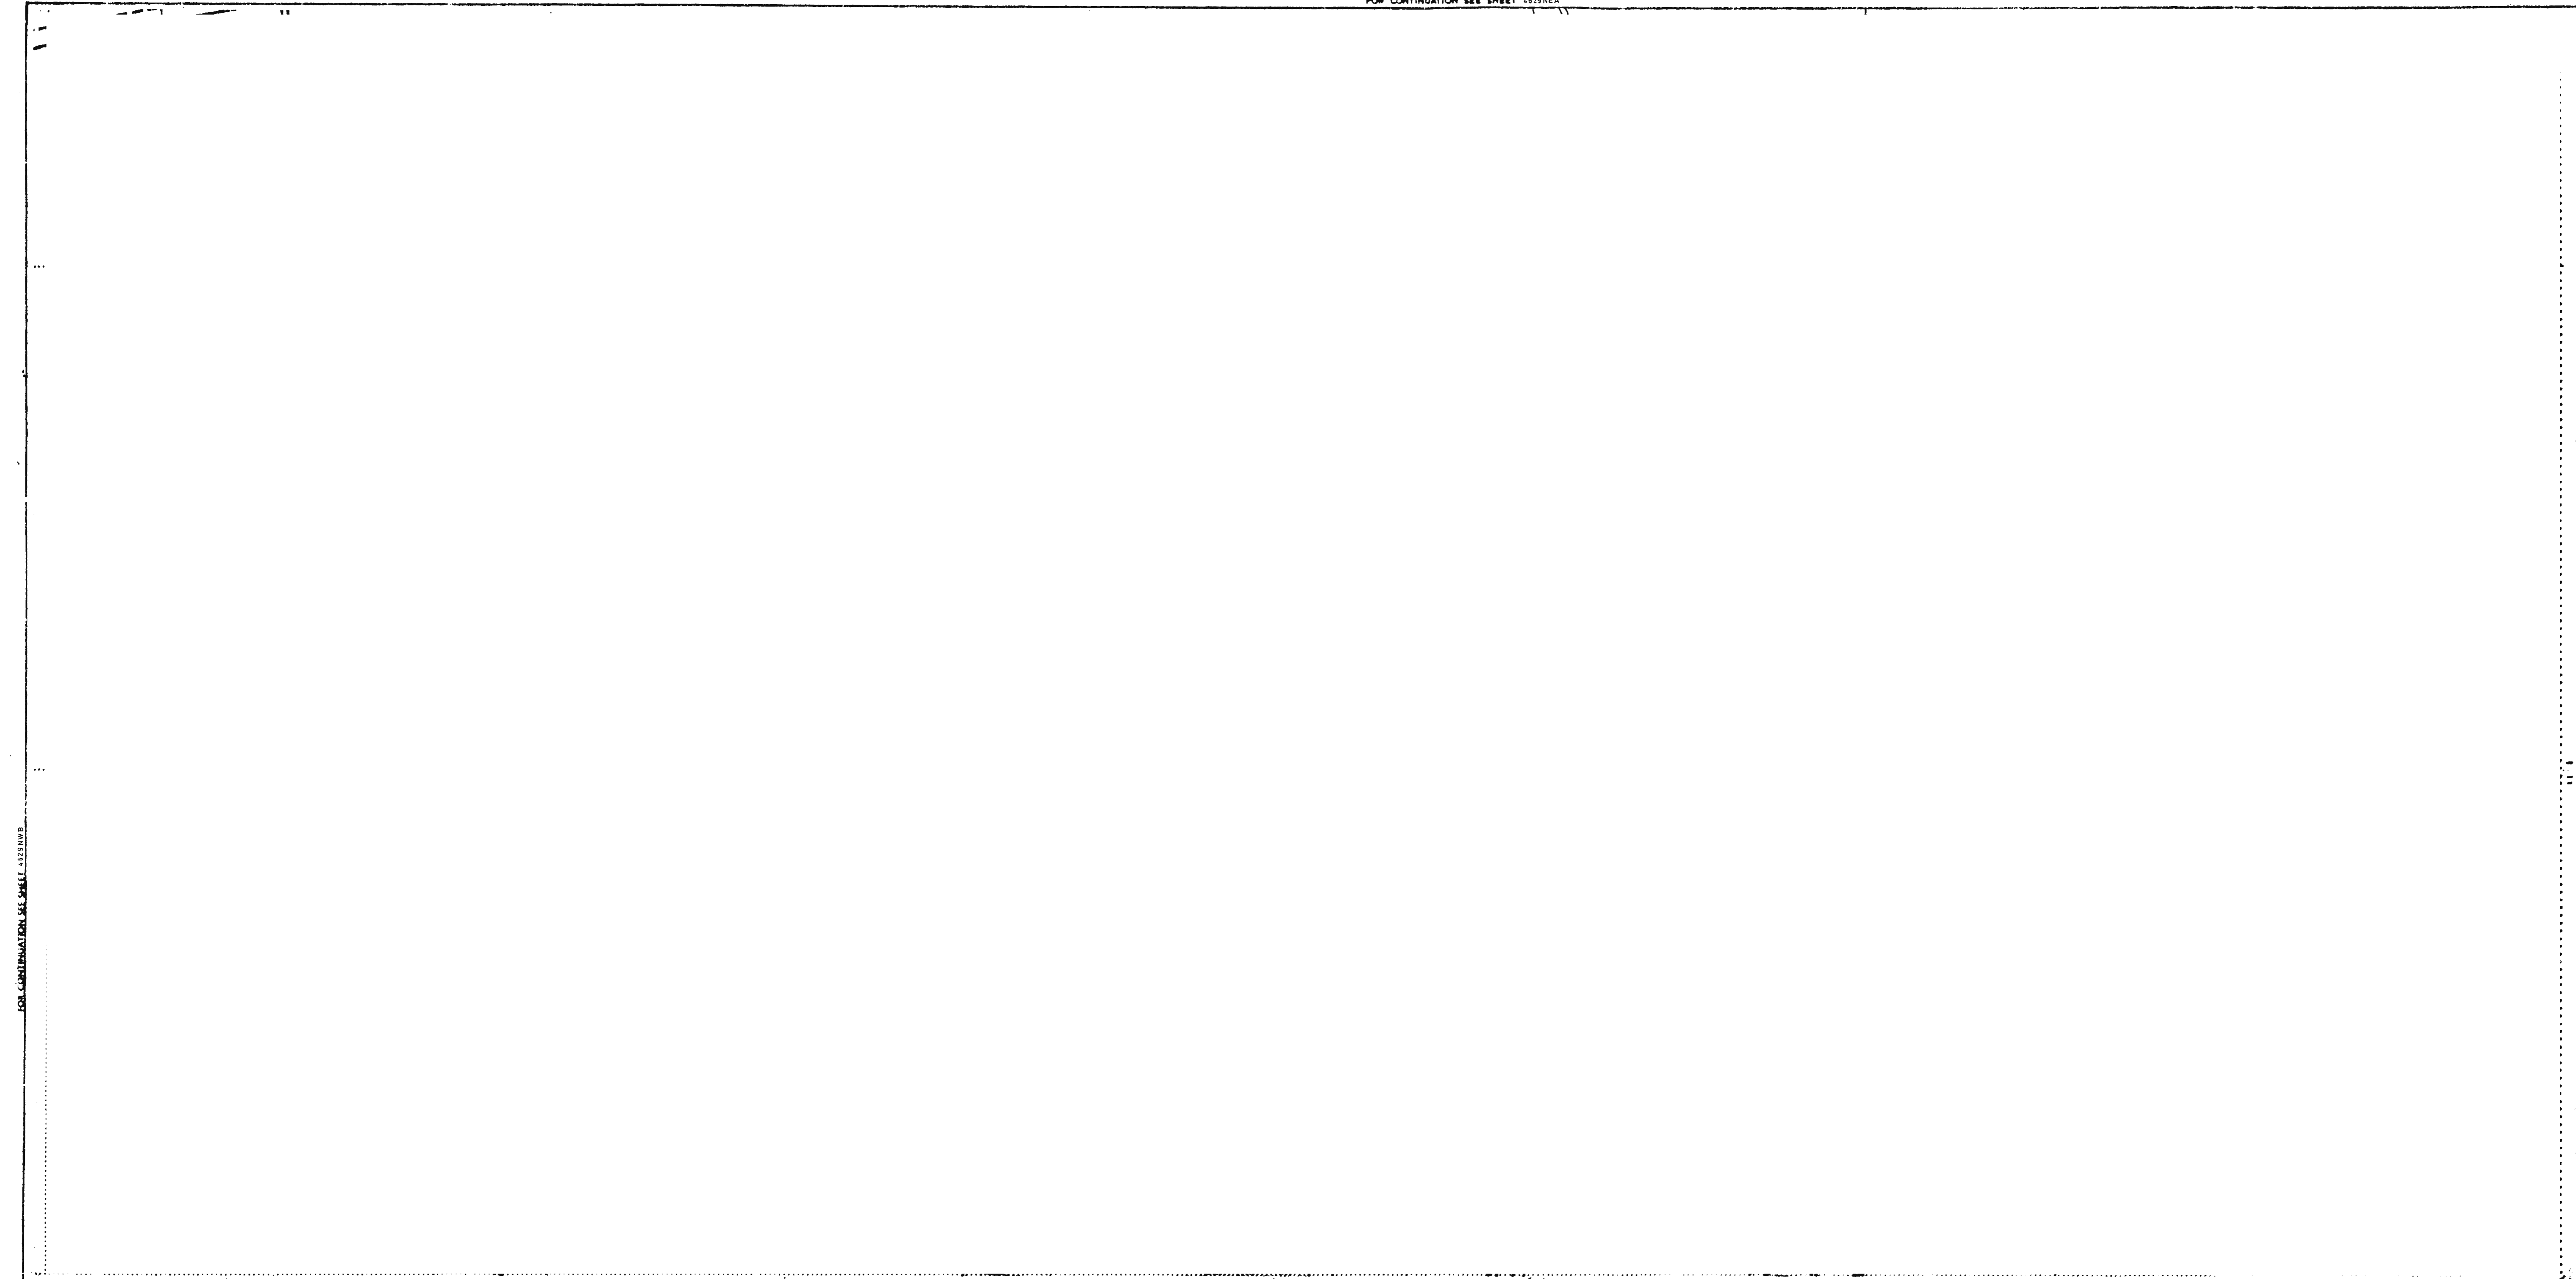

PILOT CABLES AND HIGH VOLTAGE CABLES
Serial numbers refer to this sheet only and lengths are to sheet edge

No.	kV	Size	Cores	Designation	Lengths		No.	kV	Size	Cores	Designation	Lengths	
					meters	feet						meters	feet

NOTES (1) FOR FULL DETAILS OF 33 kV CABLES REFERENCE SHOULD BE MADE TO THE PRIMARY RECORDS
(2) E DENOTES CNE CABLE & DENOTES ALEXEX TYPE

eastern electricity

1:500 SCALE U/G MAINS
LOCATION BERDEN

DIMENSIONS IN MILLIMETRES
REPRODUCED FROM OR BASED UPON THE ORDINANCE SURVEY MAP WITH THE SANCTION OF THE CONTROLLER OF H.M. STATIONERY OFFICE. CROWN COPYRIGHT RESERVED

SERVICES FOR DETAILS OF SERVICE CABLE REFERENCE SHOULD BE MADE TO THE SERVICE CARDS IN THE DISTRICT OFFICE

SHEET NO TL4629NEB.s0
ISSUE A
DATE 02-09-02

SUPPLEMENTARY SHEET NO

TL 4629 NEB

