
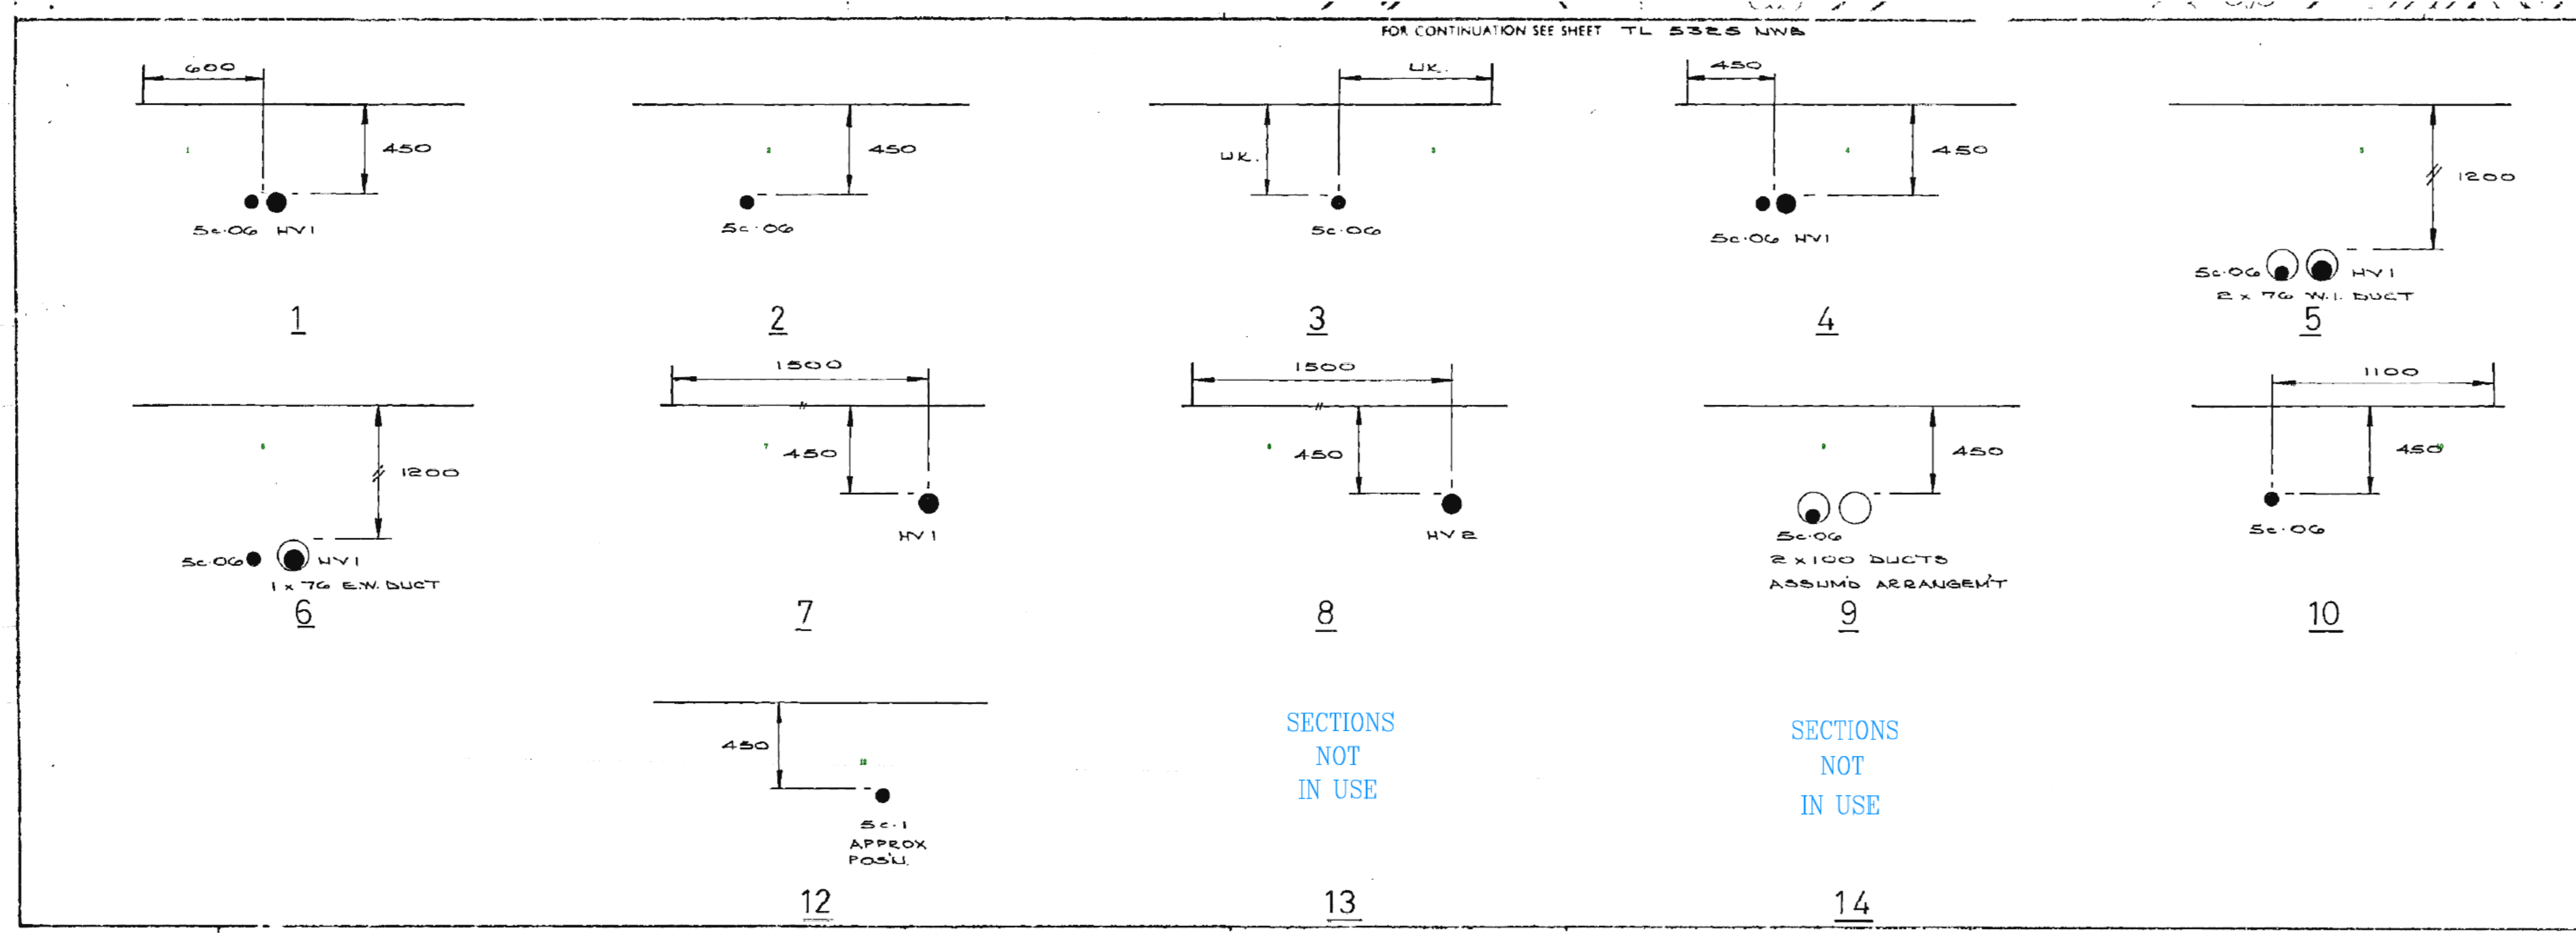


SO

TL5325NWA 1:500 LV

FOR CONTINUATION SEE SHEET TL 5325 NWA

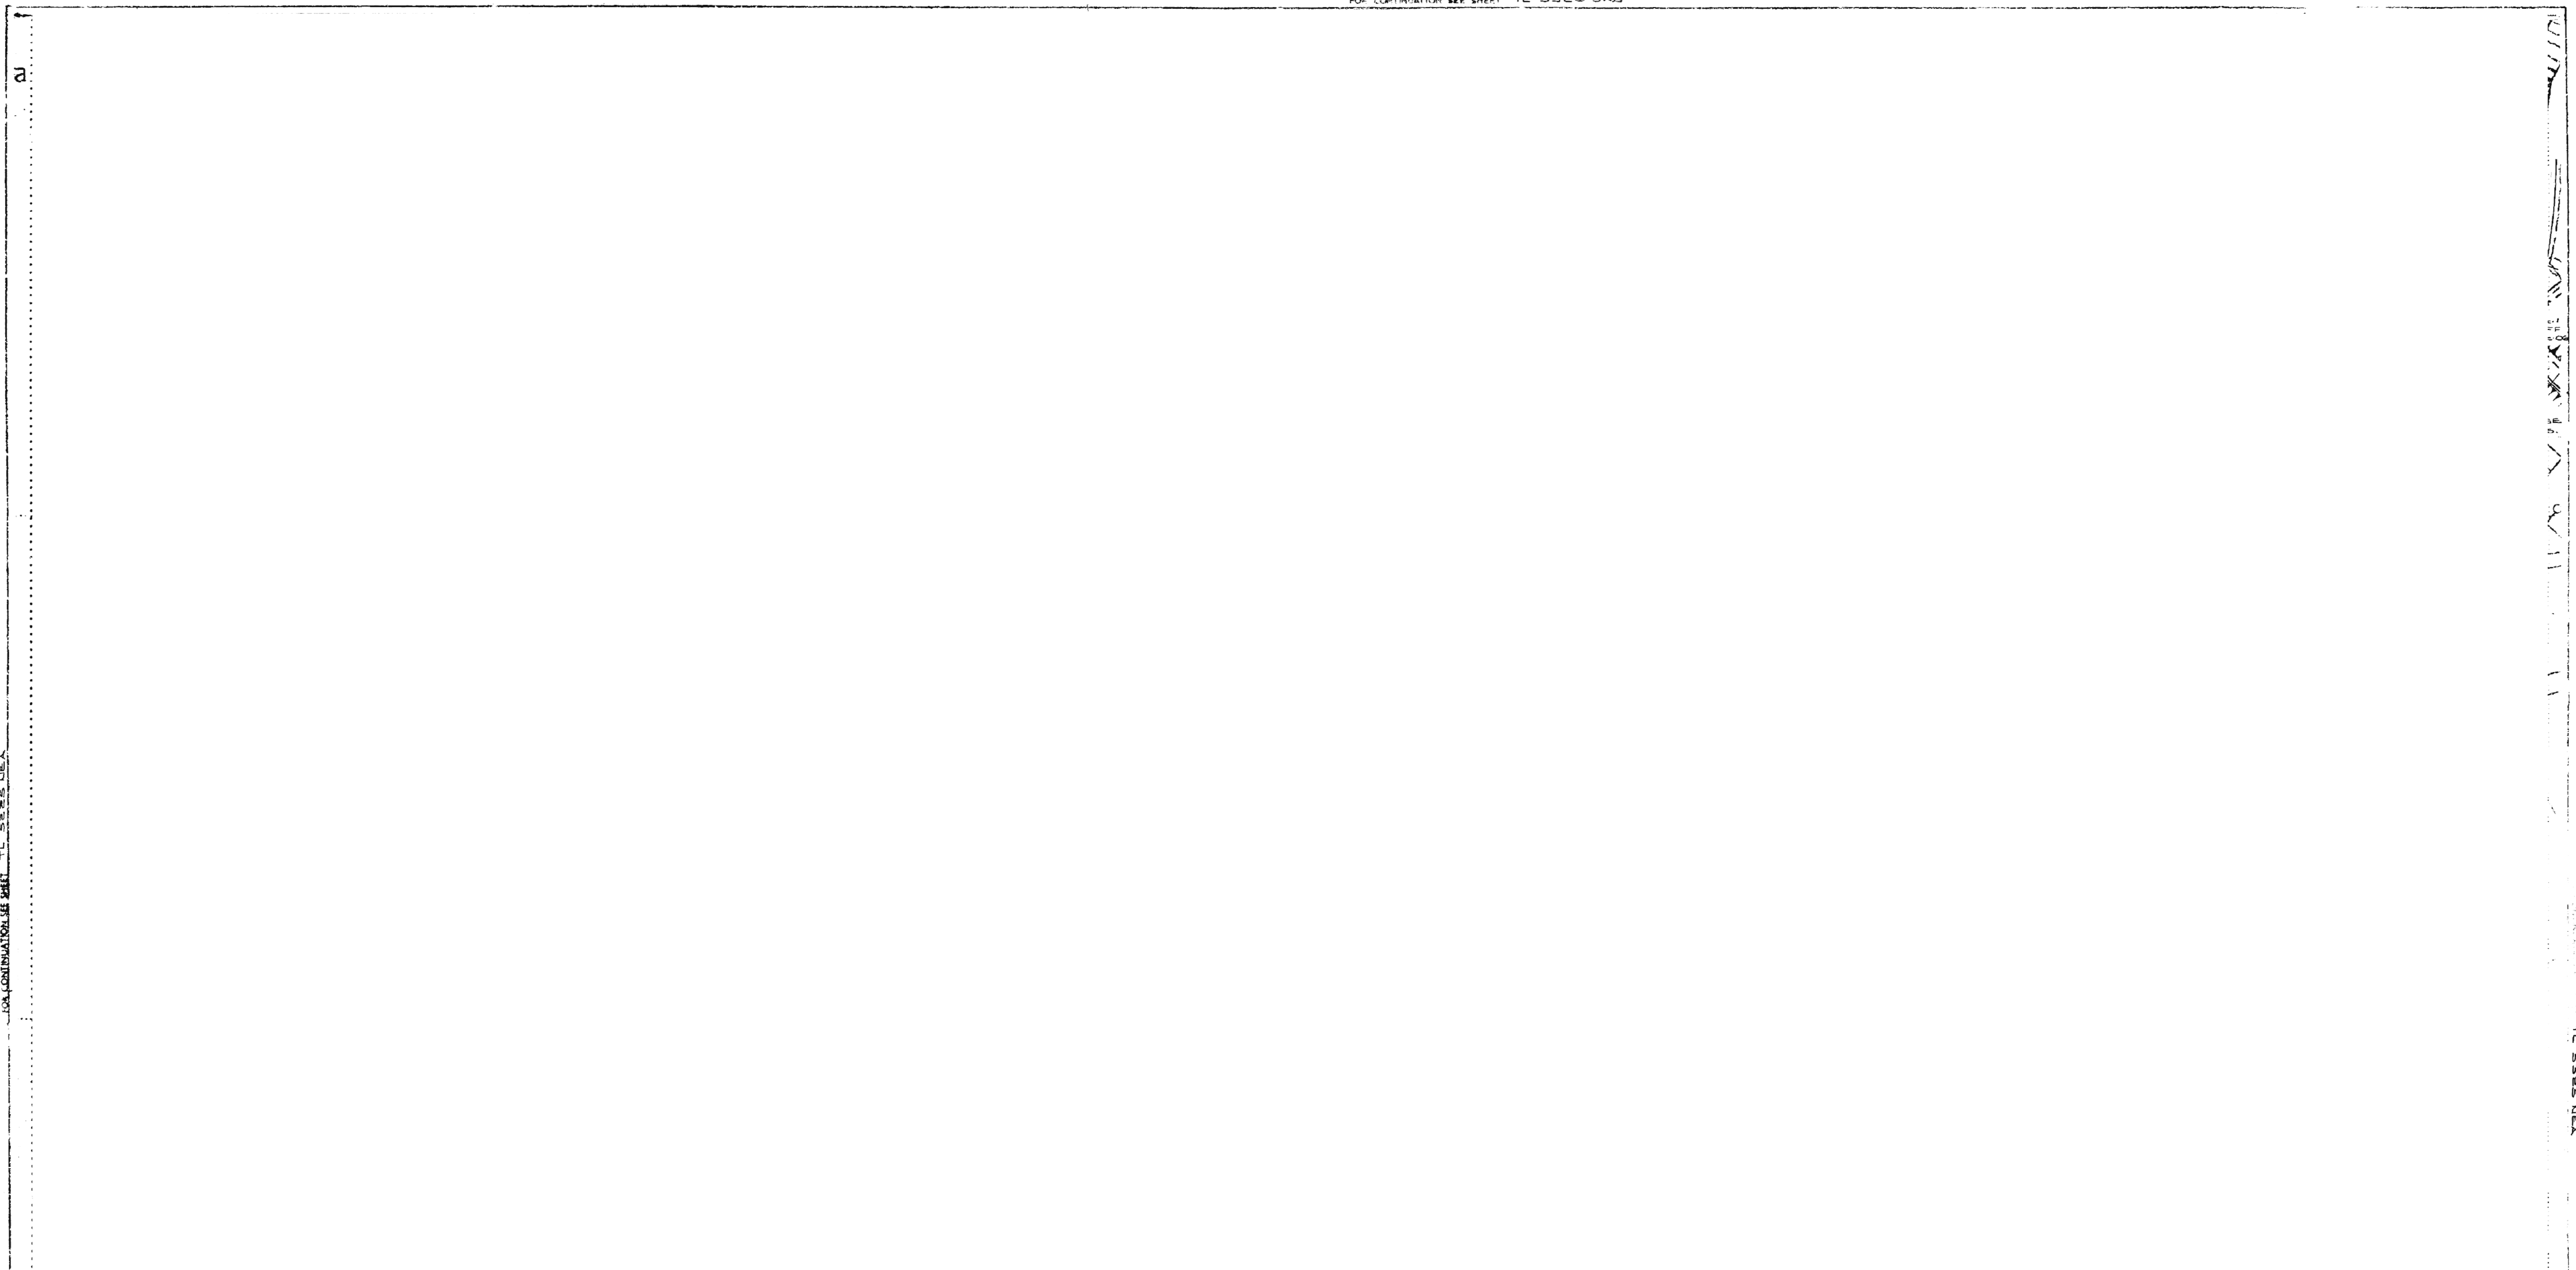

PILOT CABLES AND HIGH VOLTAGE CABLES
Serial numbers refer to this sheet only and lengths are to sheet edge

No	kV	Size	Cores	Designation	Lengths			Description	Remarks
					m	ft	in		
	HV1	3	05	3				ABANDONED	59
	HV2	3	05	3					37
	HV405	11	300	3				TIE OFF HV405 TO STANDED ROAD SOUTH END	

NOTES:
 (1) FOR FULL DETAILS OF TRAY CABLES REFERENCE SHOULD BE MADE TO THE RELEVANT RECORDS.
 (2) E LEMOTES CNE CABLE 2 SERVICES ALEX TIE.
 (3) ALL DEPTHS SHOWN ARE AS LAYS, SUBJECT TO FINAL LEVELS.
 (4) UK DEPTHS UNKNOWN.

Total length: _____

Total length: _____

eastern electricity

1:500 SCALE Dwg MAINS

LOCATION: **ELSENHAM**

SHEET NO: TL5325NWA.s0
 SUPPLEMENTARY SHEET NO: _____


ISSUE: **A** DATE: **22-04-02**

s0

TL5326SWB 1:500 LV

See continuation of sheet TL 5326SWB

See continuation of sheet TL 5326SWB

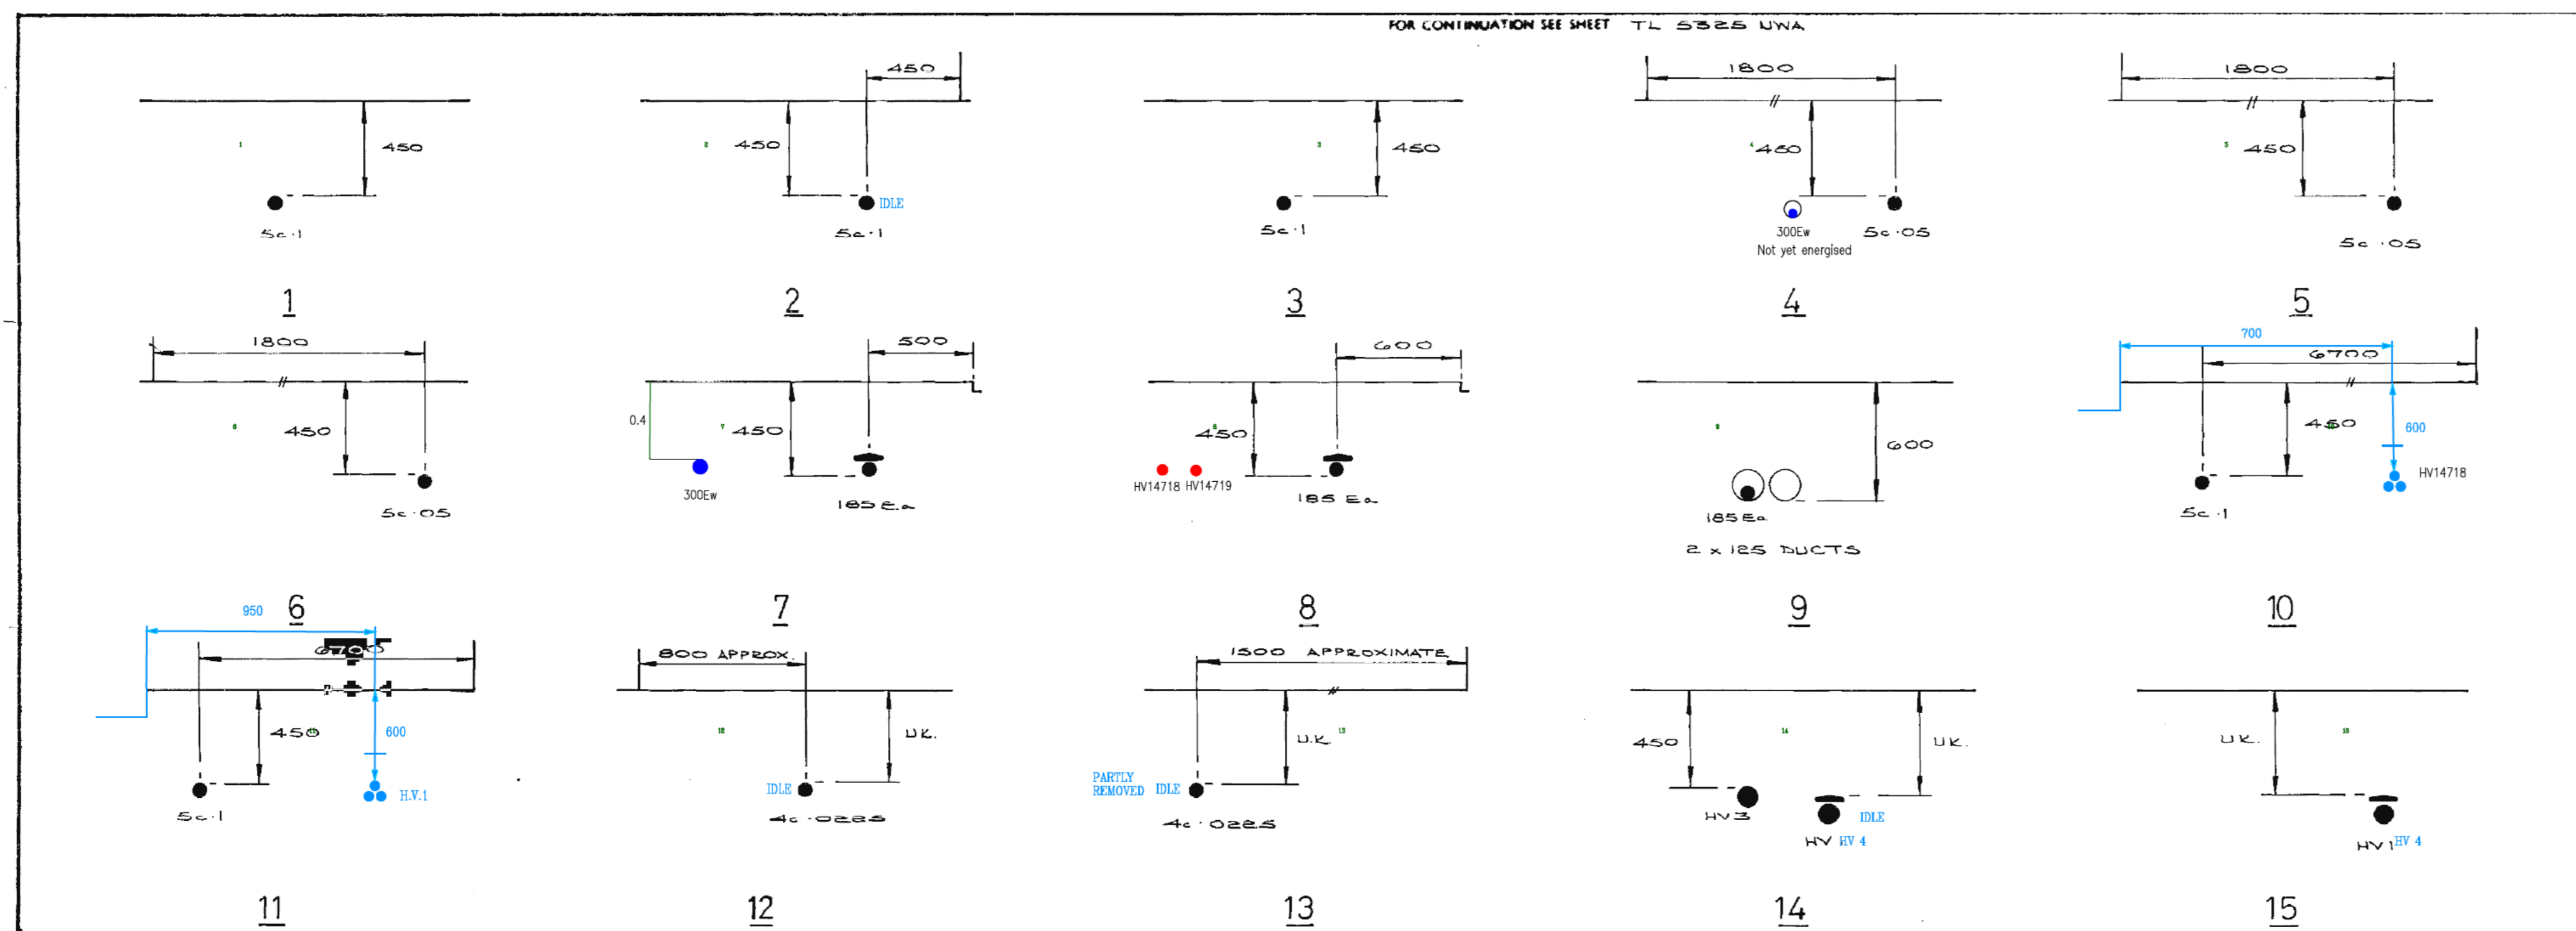

PILOT CABLES AND HIGH VOLTAGE CABLES

Serial numbers refer to this sheet only and lengths are to sheet edge

No	kV	Size	Cores	Designation	Lengths		No	kV	Size	Cores	Designation	Lengths	
					metres	yards						metres	yards
HW478	11	100PR	12x1	HIGHFIELDS-BARLEY WAY END									
HW478	11	100PR	12x1	ELSENHAM WEST - GURLEY COTT									
HW 3	3	0.5	3	BARBOLDS									
HW 3	3	0.5	3	BARBOLDS									
HW478	11	100PR	12x1	BAILEY WYND-ROBERTSDOWN SOUTH END									
					Total length							Total length	

NOTES (1) FOR FULL DETAILS OF 33 kV CABLES REFERENCE SHOULD BE MADE TO THE PRIMARY RECORDS
 (2) E DENOTES CNE CABLE & DENOTES ALPEX TYPE
 (3) ALL DEPTHS SHOWN ARE AS LAID, SUBJECT TO FINAL LEVELS.
 (4) U.K. DENOTES UNKNOWN.

eastern electricity

1:500 SCALE U/G MAINS

LOCATION
ELSENHAM

SHEET NO.
TL5326SWB.s0

ISSUE
B


DATE
26-04-99


DIMENSIONS IN MILLIMETRES

REPRODUCED FROM OR BASED UPON THE ORDINANCE SURVEY MAP WITH THE SANCTION OF THE CONTROLLER OF H.M. STATIONARY OFFICE. CROWN COPYRIGHT RESERVED.

SERVICES FOR DETAILS OF SERVICE CABLE REFERENCE SHOULD BE MADE TO THE SERVICE CARDS IN THE DISTRICT OFFICE.

SUPPLEMENTARY SHEET NO. TL 5326SWB.s1

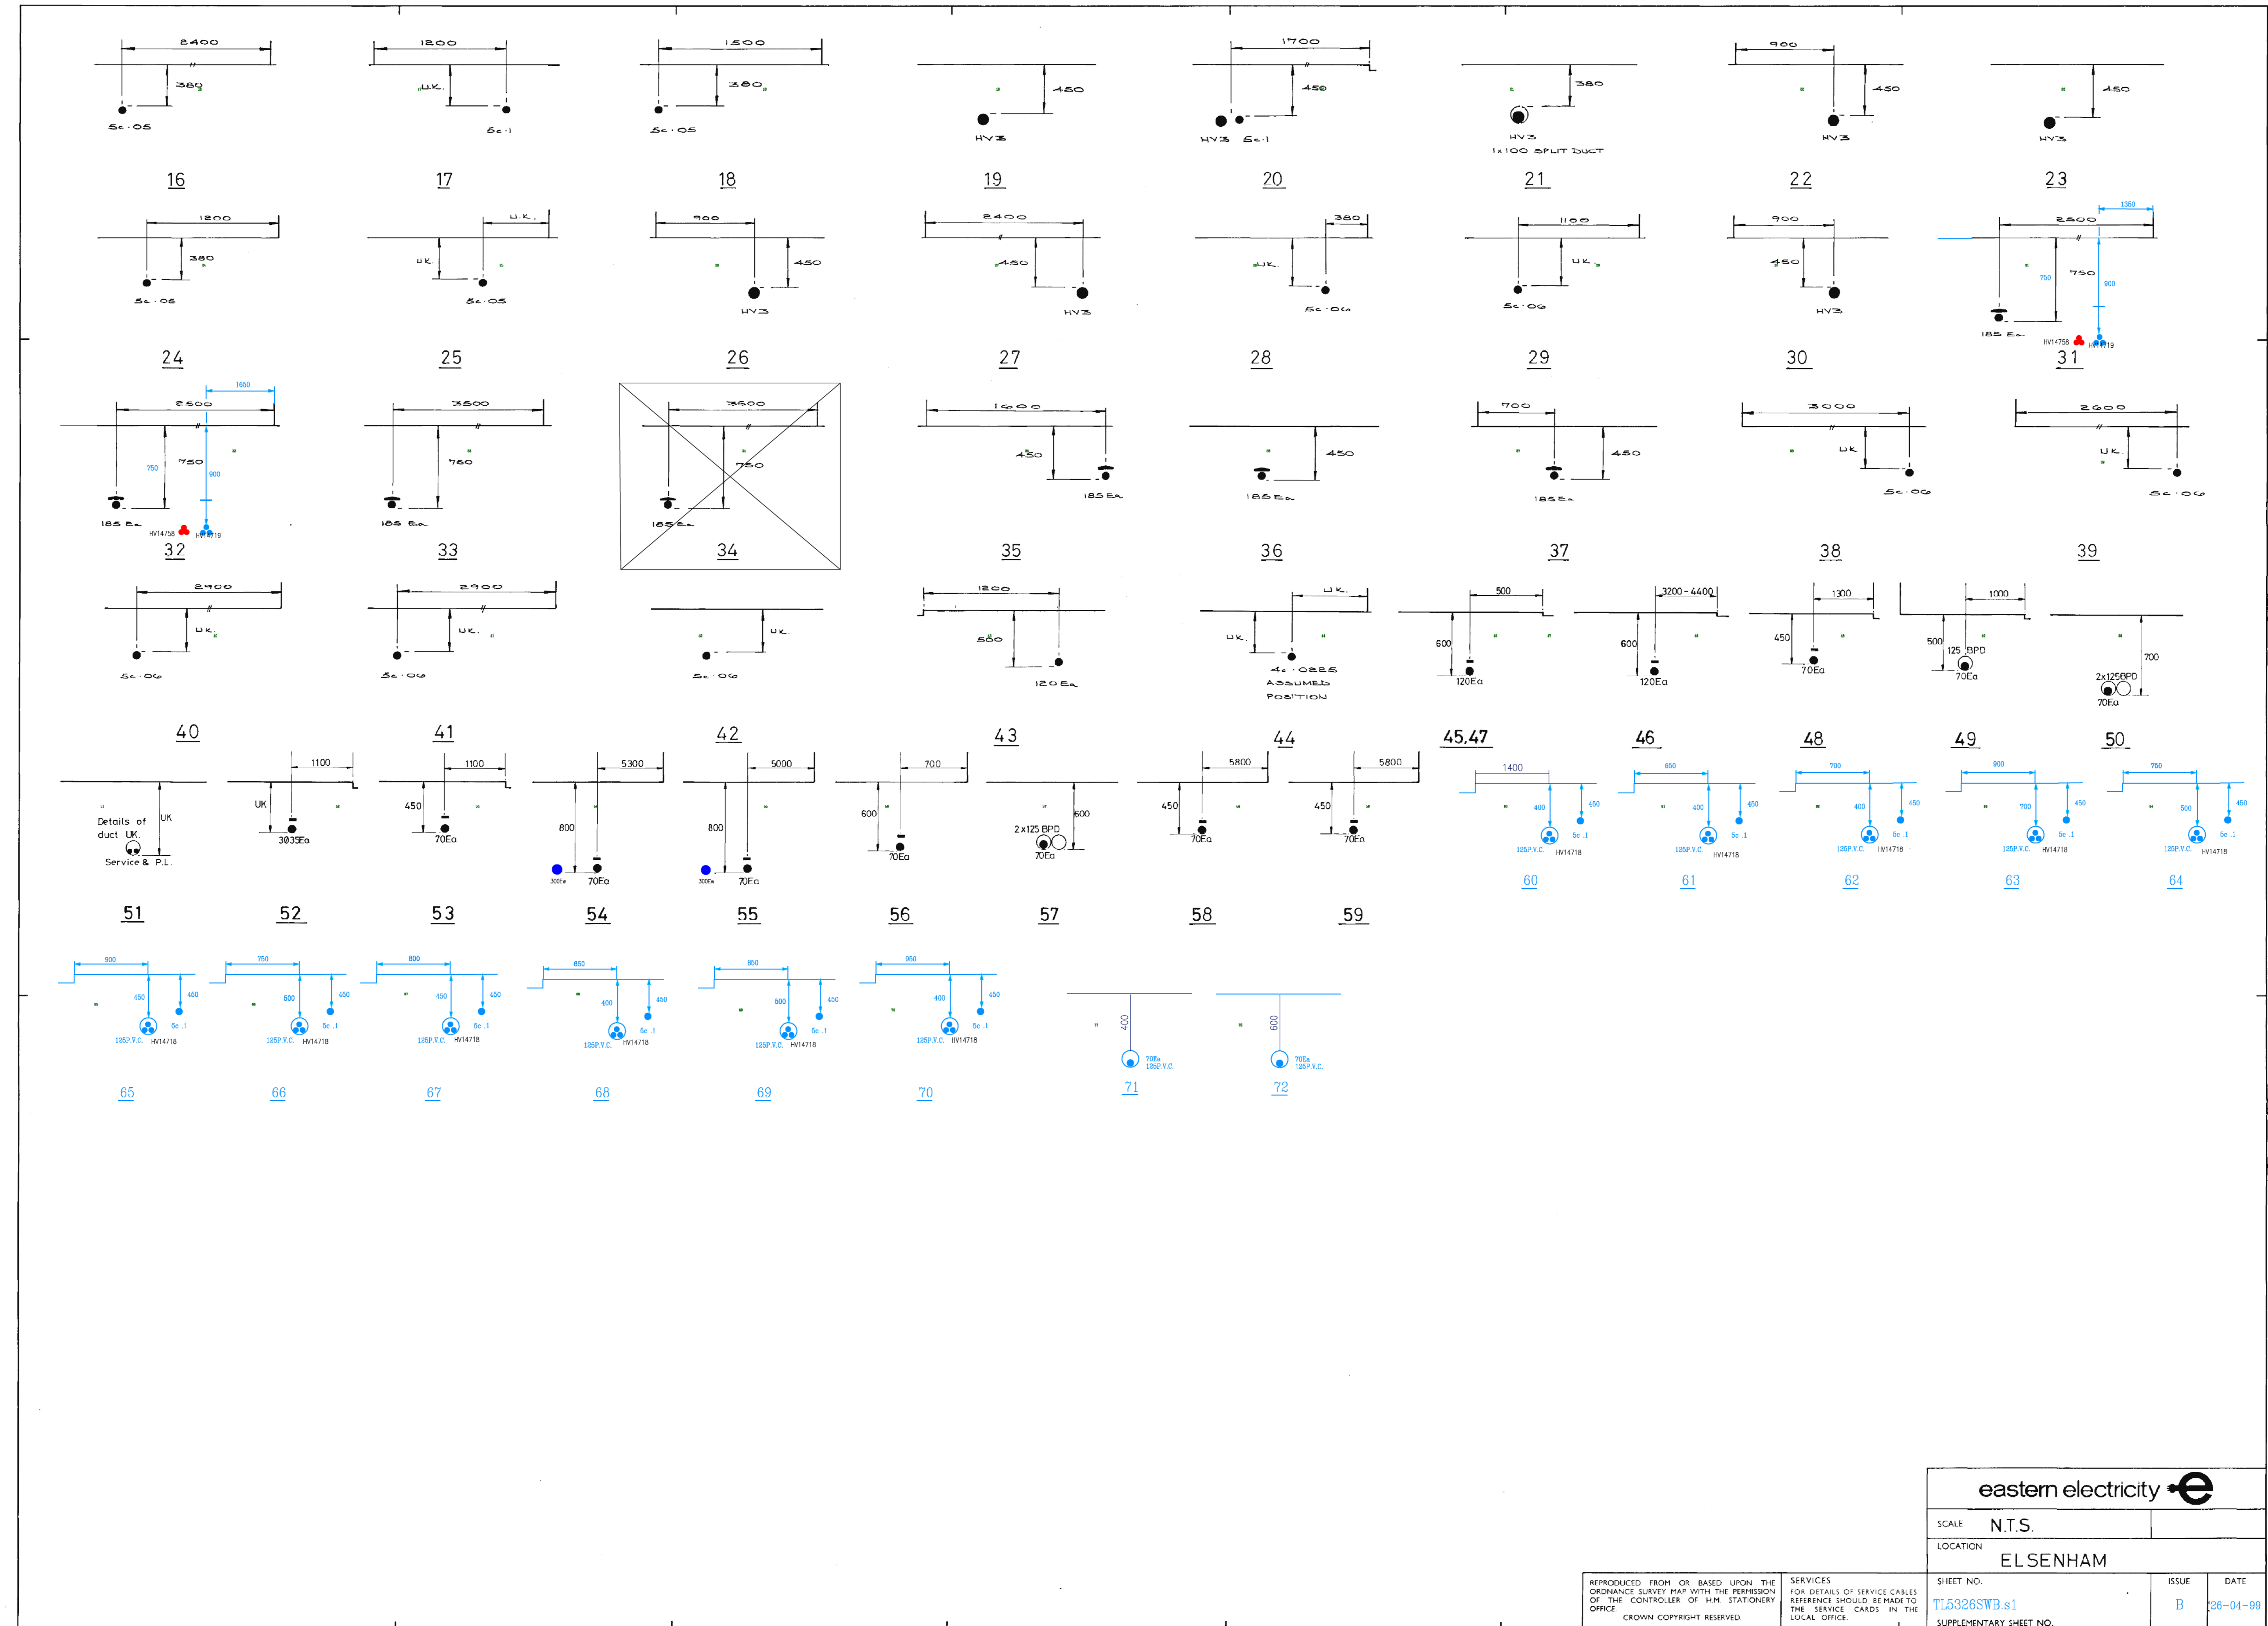

eastern electricity 	
SCALE	N.T.S.
LOCATION	ELSENHAM
SHEET NO.	TLS326SWB.s1
ISSUE	B
DATE	26-04-99

REPRODUCED FROM OR BASED UPON THE
ORDNANCE SURVEY MAP WITH THE PERMISSION
OF THE CONTROLLER OF HER MAJESTY'S
STATIONERY OFFICE
CROWN COPYRIGHT RESERVED.

SERVICES
FOR DETAILS OF SERVICE CABLES
REFERENCE SHOULD BE MADE TO
THE SERVICE CARDS IN THE
LOCAL OFFICE.

SUPPLEMENTARY SHEET NO.