



SO

TL4722NWA 1:500 LV

FOR CONTINUATION SEE SHEET TL 4722NWB

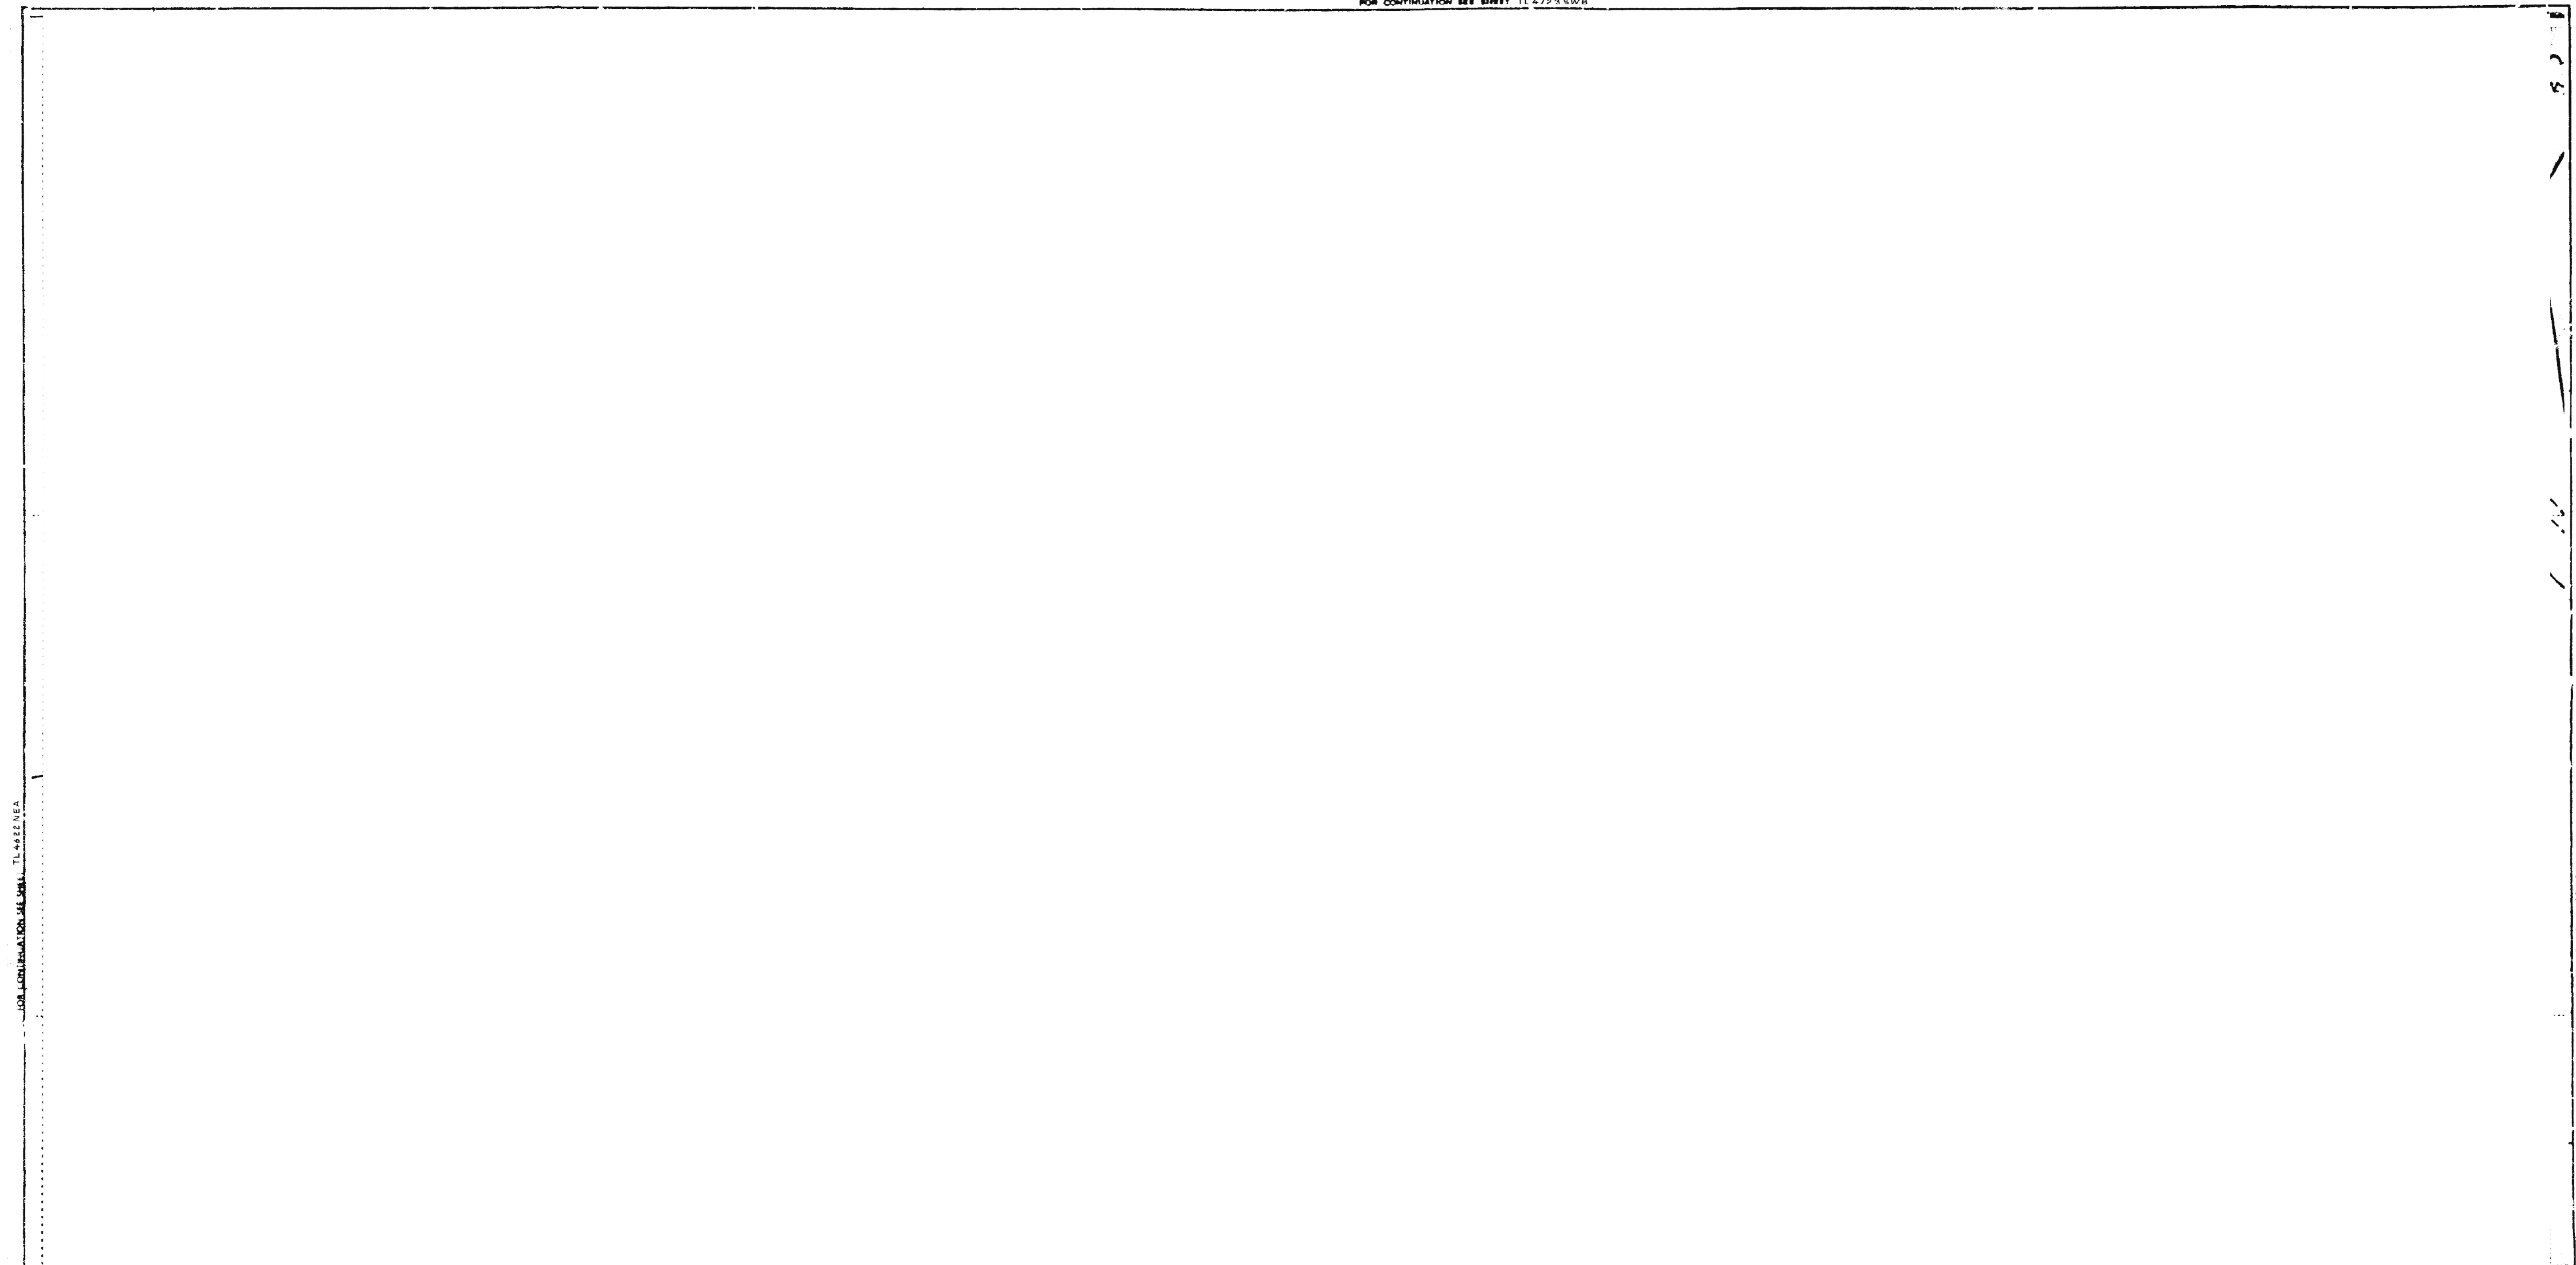

FOR CONTINUATION SEE SHEET TL 4722NWB

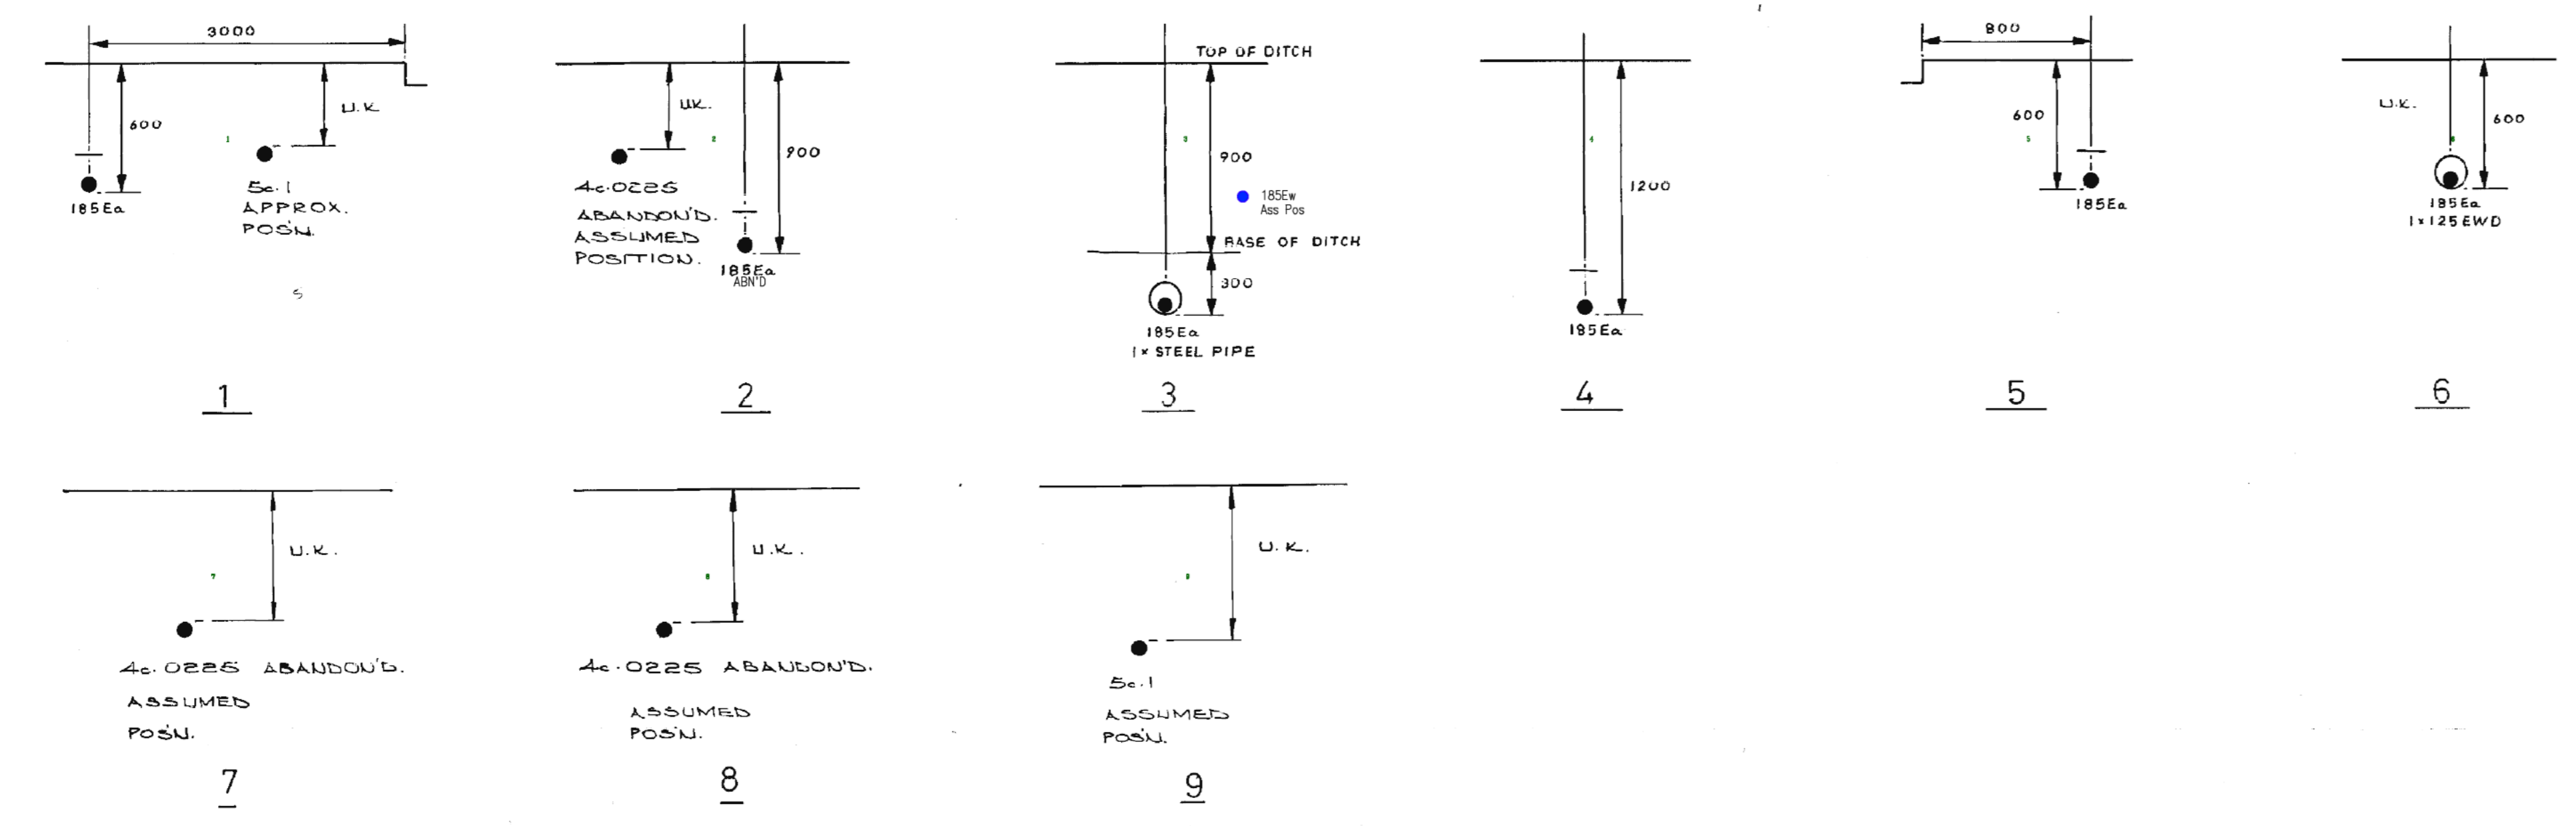

PILOT CABLES AND HIGH VOLTAGE CABLES

Serial numbers refer to this sheet only and lengths are to sheet edge

No	kV	Size	Cores	Design	Lengths		No	kV	Size	Cores	Designation	Lengths	
					meters	yards						meters	yards
							101854	11	180.00	3/4"	WICKHAM HALL - POLE 14		
					Total length							Total length	

NOTES (1) FOR FULL DETAILS OF 33 kV CABLES REFERENCE SHOULD BE MADE TO THE PRIMARY RECORDS
 (2) E DENOTES CNE CABLE, A DENOTES ALPHEX TYPE, H DENOTES C-V AL HYBRID TYPE
 (3) ALL DEPTHS SHOWN ARE AS LAID, SUBJECT TO FINAL LEVELS
 (4) U.K. = UNKNOTTED, UNKNOWN



1:500 SCALE U/G MANS
 LOCATION BISHOPS STORTFORD

SHEET NO TL 4722NWA
 SUPPLEMENTARY SHEET NO TL 4722NWA/1
 DIMENSIONS IN MILLIMETRES
 REPRODUCED FROM OR BASED UPON THE ORDINANCE SURVEY MAP WITH THE SANCTION OF THE CONTROLLER OF HER MAJESTY'S STATIONERY OFFICE. CROWN COPYRIGHT RESERVED.
 SERVICES FOR DETAILS OF SERVICE CABLE REFERENCE SHOULD BE MADE TO THE SERVICE CARDS IN THE DISTRICT OFFICE.
 ISSUE C
 DATE MAR 85

FOR CONTINUATION SEE SHEET TL 4722NWA

TL 4722NWA


S1

0

TL 4722 NWA



TL 4722 NWA/1

<small>REPRODUCED FROM OR BASED UPON THE ORDNANCE SURVEY MAP WITH THE SANCTION OF THE CONTROLLER OF HER MAJESTY'S OFFICE. CROWN COPYRIGHT RESERVED.</small>		eastern electricity 				
		SCALE				
<small>SERVICES FOR DETAILS OF CABLE SERVICE REFERENCE SHOULD BE MADE TO THE SERVICE CARDS IN THE DISTRICT OFFICE.</small>		LOCATION	BISHOPS STORTFORD			
SHEET NO.		TL 4722 NWA/1	ISSUE	A	DATE	MAR 85
SUPPLEMENTARY SHEET NO.						

