


Scheme Title : Maple Lodge STW Digester Domes
 Contract Title : Replacement Gas Bells 5-8
 Project Ref : 5353
 Contract Ref : A1
 TWUL Drg No 5353/A1/6043/EX

As built.
J. Harrison 20/7/01

CLIENT:	J. T. SCOTNEY LIMITED	J.T.S. DRG 597/076/32/1	REV 0
SITE:	THAMES WATER - MAPLE LODGE W.R.W.		
EQUIPMENT:	FOUR FLOATING, DIGESTER COVERS		
ASSIGNMENT:	165	DWG.NO. JTSLO1/5001	REVISION: '0'
RAISED BY:	SID TEMPEST	DATE: 04.02.98	AUTHORISED:
REVISIONS:	"A"	"B"	"C" "D" "E" "F"
DATES:			

TSA
 TEMPEST
 - STANSFIELD
 ASSOCIATES LTD.
 CONSULTING ENGINEERS
 PO BOX MT44 LEEDS LS17 8UP
 Telephone & Telefacsimile
 (UK) 0113 293 9507

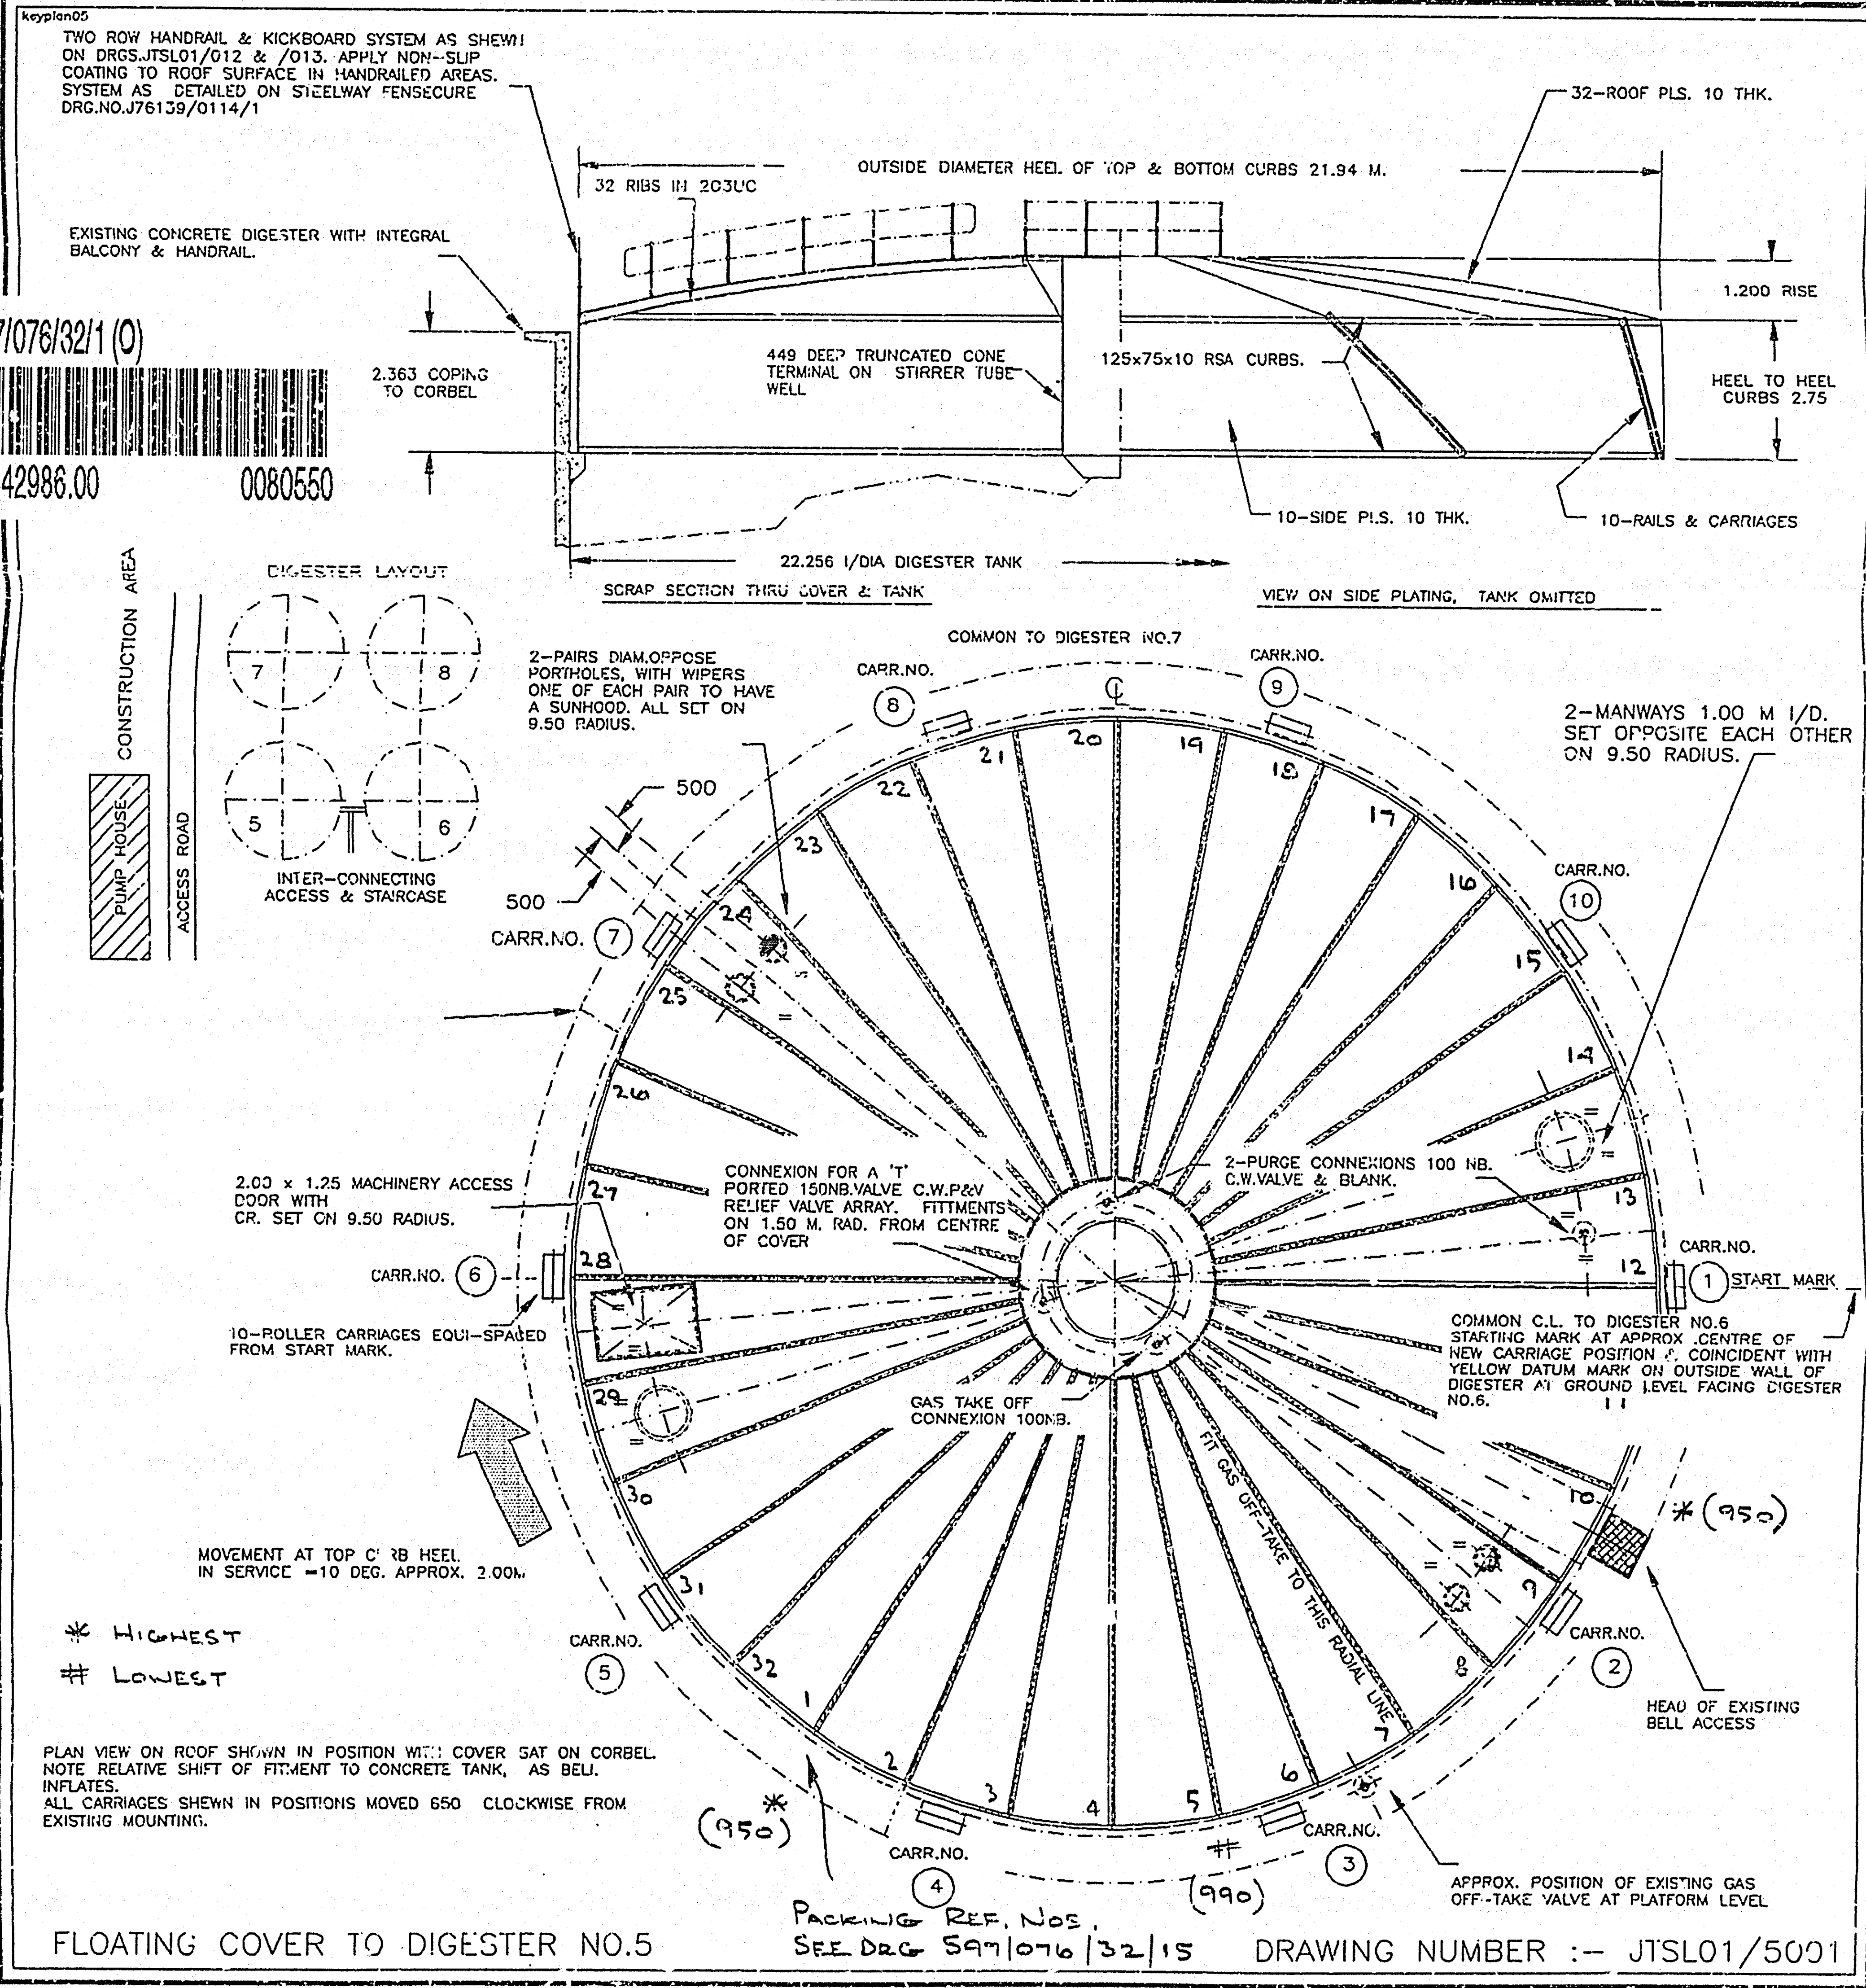

S97/076/32/1 (0)
 00442986.00 0080550