

## Annex C - Consolidated Drawing Schedule and revised drawings

## Consolidated Drawing Schedule

	Column 1	Column 2	Column 3	Column 4
	Drawing number from Planning (Addendum 2) Drawing List	Link to redacted drawings on inquiry website	Link to location of unredacted indicative drawings	Nature of Remaining Redaction
1	B1_P11_09 Proposed basement floor plan, Johnson Smirke building	CD1.03C p2	INQ11 p42	<p>No redaction to the original drawing. The Rev 01 has been labelled to identify the principle use of the space in line with INQ11 p42 for information purposes. All information has been provided before the Inquiry.</p> <p>Use information for smaller rooms (areas with no public access) is not shown, which is however irrelevant to the planning.</p> <p><u>All works to heritage features shown</u></p>
2	B1_P11_10 Proposed ground floor plan, Johnson Smirke building	CD1.03C p3	Fig 6.10.4 p91 CD11.03 INQ11 p41	<p>No redaction to the original drawing. The Rev 01 has been labelled to identify the principle use of the space in line with CD11.03 p91 Fig 6.10.4 and INQ11 p41 for information purposes. All information has been provided before the Inquiry.</p> <p>Use information for smaller rooms (areas with no public access) is not shown, which is however irrelevant to the planning.</p> <p><u>All works to heritage features shown</u></p>
3	B1_P11_11 Proposed first floor plan, Johnson Smirke building	CD1.03C p4	Fig 6.10.3 p91 CD11.03 INQ11 p42	<p>No redaction to the original drawing. The Rev 01 has been labelled to identify the principle use of the space in line with CD11.03 p91 Fig 6.10.3 and INQ11 p42 for information purposes. All information has been provided before the Inquiry.</p> <p>Use information for smaller rooms (areas with no public access) is not shown, which is however irrelevant to the planning.</p> <p><u>All works to heritage features shown</u></p>
4	B1_P11_12 Proposed second floor plan, Johnson Smirke building	CD1.03C p5	INQ11 p43	<p>No redaction to the original drawing. The Rev 01 has been labelled to identify the principle use of the space in line with INQ11 p43 for information purposes. All information has been provided before the Inquiry.</p> <p>Use information for smaller rooms (areas with no public access) is not shown, which is however irrelevant to the planning.</p> <p><u>All works to heritage features shown</u></p>
5	B1_P11_13 Proposed third floor plan, Johnson Smirke building	CD1.03C p6	INQ11 p43	<p>No redaction to the original drawing. The Rev 01 has been labelled to identify the principle use of the space in line with INQ11 p43 for information purposes. All information has been provided before the Inquiry.</p> <p>Use information for smaller rooms (areas with no public access) is not shown, which is however irrelevant to the planning.</p> <p><u>All works to heritage features shown</u></p>

6	B1_P11_14 Proposed roof plan, Johnson Smirke building	CD1.03C p7		Unnecessarily listed as 'redacted' in the drawing register. No changes.  All works to heritage features shown.
7	B2_P11_09 Proposed basement floor plan, Seaman's Registry Building	CD1.03C p18	INQ11 p52	No redaction to the original drawing. The Rev 01 has been labelled to identify the principle use of the space in line with INQ11 p52 for information purposes. All information has been provided before the Inquiry.  Use information for remaining rooms (areas with no public access) is not shown, which is however irrelevant to the planning.  <u>All works to heritage features shown</u>
8	B2_P11_10 Proposed ground floor plan, Seaman's Registry Building	CD1.03C p19	Fig 6.11.4 p93 CD11.03 Applicant PoE-Design INQ11 p53	No redaction to the original drawing. The Rev 01 has been labelled to identify the principle use of the space in line with CD11.03 p93 Fig 6.11.4 and INQ11 p53 (ground floor plan) for information purposes. All information has been provided before the Inquiry.  Use information for remaining rooms (areas with no public access) is not shown, which is however irrelevant to the planning.  <u>All works to heritage features shown</u>
9	B2_P11_11 Proposed first floor plan, Seaman's Registry Building	CD1.03C p20	Fig 6.11.3 p93 CD11.03 Applicant PoE-Design	No redaction to the original drawing. The Rev 01 has been labelled to identify the principle use of the space in line with CD11.03 p93 Fig 6.11.3 and INQ11 p53 (typical upper floor plan) for information purposes. All information has been provided before the Inquiry.  Use information for remaining rooms (areas with no public access) is not shown, which is however irrelevant to the planning.  <u>All works to heritage features shown</u>
10	B2_P11_12 Proposed second floor plan, Seaman's Registry Building	CD1.03C p21		No redaction to the original drawing. The Rev 01 has been labelled to identify the principle use of the space in line with INQ11 p53 (typical upper floor plan) for information purposes. All information has been provided before the Inquiry.  Use information for remaining rooms (areas with no public access) is not shown, which is however irrelevant to the planning.  <u>All works to heritage features shown</u>
11	B2_P11_13 Proposed third floor plan, Seaman's Registry Building	CD1.03C p22		No redaction to the original drawing. The Rev 01 has been labelled to identify the principle use of the space in line with INQ11 p53 (typical upper floor plan) for information purposes. All information has been provided before the Inquiry.  Use information for remaining rooms (areas with no public access) is not shown, which is however irrelevant to the planning.  <u>All works to heritage features shown</u>

12	B2_P11_14 Proposed fourth floor plan, Seaman's Registry Building	CD1.03C p23		<p>No redaction to the original drawing. The Rev 01 has been labelled to identify the principle use of the space for information purposes. All information has been provided before the Inquiry.</p> <p>Use information for remaining rooms (areas with no public access) is not shown, which is however irrelevant to the planning.</p> <p><u>All works to heritage features shown.</u></p>
13	B2_P11_15 Proposed roof floor plan, Seaman's Registry Building	CD1.03C p24		<p>Unnecessarily listed as 'redacted' in the drawing register. No changes.</p> <p>All works to heritage features shown.</p>
14	B3a_P11_09 Proposed basement plan, Cultural Exchange Building	CD1.03C p37	Fig 6.12.12 p99 CD11.03 Applicant PoE- Design INQ11 p60	<p>The Cultural Exchange Building layout in Rev 01 has been unredacted. The details are in line with CD11.03 p99 Fig6.12.12 and INQ11 p60. All information has been provided before the Inquiry.</p> <p>Use information for remaining rooms (areas with no public access) is not shown, which is however irrelevant to the planning.</p>
15	B3a_P11_10 Proposed upper ground floor plan, Cultural Exchange Building	CD1.03C p38	Fig 6.12.14 p99 CD11.03 Applicant PoE- Design INQ11 p61	<p>The Cultural Exchange Building layout in Rev 01 has been unredacted. The details are in line with CD11.03 p99 Fig6.12.14 and INQ11 p61. All information has been provided before the Inquiry.</p> <p>Use information for remaining rooms (areas with no public access) is not shown, which is however irrelevant to the planning.</p>
16	B3a_P11_11 Proposed first floor plan, Cultural Exchange Building	CD1.03C p39	INQ11 p62	<p>The Cultural Exchange Building layout in Rev 01 has been unredacted. The details are in line with INQ11 p62. All information has been provided before the Inquiry.</p> <p>Use information for remaining rooms (areas with no public access) is not shown, which is however irrelevant to the planning.</p>
17	B3a_P11_12 Proposed second floor plan, Cultural Exchange Building	CD1.03C p40	INQ11 p63	<p>The Cultural Exchange Building layout in Rev 01 has been unredacted. The details are in line with INQ11 p63 second floor layout. All information has been provided before the Inquiry.</p> <p>Use information for remaining rooms (areas with no public access) is not shown, which is however irrelevant to the planning.</p>
18	B3a_P11_13 Proposed third floor plan, Cultural Exchange Building	CD1.03C p41	INQ11 p63	<p>The Cultural Exchange Building layout in Rev 01 has been unredacted. The details are in line with INQ11 p63 third floor layout. All information has been provided before the Inquiry.</p> <p>Use information for remaining rooms (areas with no public access) is not shown, which is however irrelevant to the planning.</p>

19	B3a_P11_14 Proposed fourth floor plan, Cultural Exchange Building	CD1.03C p42	INQ11 p64	<p>The Cultural Exchange Building layout in Rev 01 has been unredacted. The details are in line with INQ11 p64 fourth floor layout. All information has been provided before the Inquiry.</p> <p>Use information for remaining rooms (areas with no public access) is not shown, which is however irrelevant to the planning.</p>
20	B3a_P11_15 Proposed fifth floor plan, Cultural Exchange Building	CD1.03C p43	INQ11 p64	<p>The Cultural Exchange Building layout in Rev 01 has been unredacted. The details are in line with INQ11 p64 fifth floor layout. All information has been provided before the Inquiry.</p> <p>Use information for remaining rooms (areas with no public access) is not shown, which is however irrelevant to the planning.</p>
21	B3a_P11_16 Proposed sixth floor plan, Cultural Exchange Building	CD1.03C p44		<p>The Cultural Exchange Building layout in Rev 01 has been unredacted. All information has been provided before the Inquiry.</p> <p>Use information for remaining rooms (areas with no public access) is not shown, which is however irrelevant to the planning.</p>
22	B3a_P11_17 Proposed roof plan, Cultural Exchange Building	CD1.03C p45		Unnecessarily listed as 'redacted' in the drawing register. No changes.
23	B3b_P11_08 Proposed basement plan, Embassy House, North	CD7.05 1510_A_B3b_11_08_01		<p>The Embassy House layout in Rev 02 has been unredacted. All information has been provided before the Inquiry.</p> <p>Use information for the remaining spaces (areas with no public access) is not shown, which is however irrelevant to the planning.</p>
24	B3b_P11_09 Proposed basement plan, Embassy House, South	CD7.05 1510_A_B3b_11_09_01		<p>The Embassy House layout in Rev 02 has been unredacted. All information has been provided before the Inquiry.</p> <p>Use information for the remaining spaces (areas with no public access) is not shown, which is however irrelevant to the planning.</p>
25	B3b_P11_10 Proposed ground floor plan, Embassy House, North	CD7.05 1510_A_B3b_11_10_01	Fig 6.13.6 p104 CD11.03 Applicant PoE-Design INQ11 p78	<p>The Embassy House layout in Rev 02 has been unredacted. The details are in line with CD11.03 p104 Fig 6.13.6 and INQ11 p78. All information has been provided before the Inquiry.</p> <p>Use information for the remaining spaces (areas with no public access) is not shown, which is however irrelevant to the planning.</p>
26	B3b_P11_11 Proposed ground floor plan, Embassy House, South	CD7.05 1510_A_B3b_11_11_01	Fig 6.13.6 p104 CD11.03 Applicant PoE-Design	<p>The Embassy House layout in Rev 02 has been unredacted. The details are in line with CD11.03 p104 Fig 6.13.6. All information has been provided before the Inquiry.</p> <p>Use information for the remaining spaces (areas with no public access) is not shown, which is however irrelevant to the planning.</p>

27	B3b_P11_12 Proposed first floor plan, Embassy House, North	CD7.05 1510_A_B3b_11_12_01		The Embassy House layout in Rev 02 has been unredacted. The details are in line with INQ11 p79 Embassy House typical floor plan. All information has been provided before the Inquiry.  Layouts of the units are shown in separate Unit Layout Plan.
28	B3b_P11_13 Proposed first floor plan, Embassy House, South	CD7.05 1510_A_B3b_11_13_01		The Embassy House layout in Rev 02 has been unredacted. The details are in line with INQ11 p79 Embassy House typical floor plan. All information has been provided before the Inquiry.  Layouts of the units are shown in separate Unit Layout Plan.
29	B3b_P11_14 Proposed second floor plan, Embassy House, North	CD7.05 1510_A_B3b_11_14_01		The Embassy House layout in Rev 02 has been unredacted. The details are in line with INQ11 p79 Embassy House typical floor plan. All information has been provided before the Inquiry.  Layouts of the units are shown in separate Unit Layout Plan.
30	B3b_P11_15 Proposed second floor plan, Embassy House, South	CD7.05 1510_A_B3b_11_15_01		The Embassy House layout in Rev 02 has been unredacted. The details are in line with INQ11 p79 Embassy House typical floor plan. All information has been provided before the Inquiry.  Layouts of the units are shown in separate Unit Layout Plan.
31	B3b_P11_16 Proposed third floor plan, Embassy House, North	CD7.05 1510_A_B3b_11_16_01		The Embassy House layout in Rev 02 has been unredacted. The details are in line with INQ11 p79 Embassy House typical floor plan. All information has been provided before the Inquiry.  Layouts of the units are shown in separate Unit Layout Plan.
32	B3b_P11_17 Proposed third floor plan, Embassy House, South	CD7.05 1510_A_B3b_11_17_01		The Embassy House layout in Rev 02 has been unredacted. The details are in line with INQ11 p79 Embassy House typical floor plan. All information has been provided before the Inquiry.  Layouts of the units are shown in separate Unit Layout Plan.
33	B3b_P11_18 Proposed fourth floor plan, Embassy House, North	CD7.05 1510_A_B3b_11_18_01		The Embassy House layout in Rev 02 has been unredacted. The details are in line with INQ11 p79 Embassy House typical floor plan. All information has been provided before the Inquiry.  Layouts of the units are shown in separate Unit Layout Plan.
34	B3b_P11_19 Proposed fourth floor plan, Embassy House, South	CD7.05 1510_A_B3b_11_19_01		The Embassy House layout in Rev 02 has been unredacted. The details are in line with INQ11 p79 Embassy House typical floor plan. All information has been provided before the Inquiry.  Layouts of the units are shown in separate Unit Layout Plan.

35	B3b_P11_20 Proposed fifth floor plan, Embassy House, North	CD7.05 1510_A_B3b_11_20_01		The Embassy House layout in Rev 02 has been unredacted. The details are in line with INQ11 p79 Embassy House typical floor plan. All information has been provided before the Inquiry.  Layouts of the units are shown in separate Unit Layout Plan.
36	B3b_P11_21 Proposed fifth floor plan, Embassy House, South	CD7.05 1510_A_B3b_11_21_01		The Embassy House layout in Rev 02 has been unredacted. The details are in line with INQ11 p79 Embassy House typical floor plan. All information has been provided before the Inquiry.  Layouts of the units are shown in separate Unit Layout Plan.
37	B3b_P11_22 Proposed sixth floor plan, Embassy House, North	CD7.22 1510_A_B3b_11_22	Fig 6.13.8 p105 CD11.03 Applicant PoE-Design INQ11 p80	The Embassy House layout in Rev 03 has been unredacted. The details are in line with CD11.03p105 Fig 6.13.8 and INQ11 p80. All information has been provided before the Inquiry  Layouts of the units are shown in separate Unit Layout Plan.
38	B3b_P11_23 Proposed sixth floor plan, Embassy House, South	CD7.22 1510_A_B3b_11_23	Fig 6.13.8 p105 CD11.03 Applicant PoE-Design INQ11 p80	The Embassy House layout in Rev 03 has been unredacted. The details are in line with CD11.03p105 Fig 6.13.8 and INQ11 p80. All information has been provided before the Inquiry  Layouts of the units are shown in separate Unit Layout Plan.
39	B3b_P11_24 Proposed seventh floor plan, Embassy House, North	CD7.22 1510_A_B3b_11_24		The Embassy House layout in Rev 03 has been unredacted. All information has been provided before the Inquiry
40	B3b_P11_25 Proposed seventh floor plan, Embassy House, South	CD7.22 1510_A_B3b_11_25		The Embassy House layout in Rev 03 has been unredacted. All information has been provided before the Inquiry
41	B3b_P11_26 Proposed roof floor plan, Embassy House, North	CD7.22 1510_A_B3b_11_26	Fig 6.13.7 p105 CD11.03 Applicant PoE-Design INQ11 p80	The Embassy House layout in Rev 03 has been unredacted. The details are in line with CD11.03p105 Fig 6.13.7 and INQ11 p80. All information has been provided before the Inquiry.
42	B3b_P11_27 Proposed roof floor plan, Embassy House, South	CD7.22 1510_A_B3b_11_27	Fig 6.13.7 p105 CD11.03 Applicant PoE-Design INQ11 p80	The Embassy House layout in Rev 03 has been unredacted. The details are in line with CD11.03p105 Fig 6.13.7 and INQ11 p80. All information has been provided before the Inquiry.
43	B3b_P21_11 Proposed unit flat layouts, Embassy House	CD7.22 1510_A_B3b_21_11_Unit layouts		Unnecessarily listed as 'redacted' in the drawing register. No changes.
44	B3b_P21_12 Proposed unit flat layouts, Embassy House	CD7.22 1510_A_B3b_21_12_Unit layouts		Unnecessarily listed as 'redacted' in the drawing register. No changes.


45	B4_11_05 Location plan, Proposed scheme	CD1.03C p86		Unnecessarily listed as 'redacted' in the drawing register. No changes.
46	B4_11_08 Site plan, Proposed scheme	CD1.03C p87		Unnecessarily listed as 'redacted' in the drawing register. No changes.
47	B4_11_09 Proposed basement plan, Masterplan	CD7.05 1510_A_B4_11_09_01		The Proposed basement master plan in Rev 02 has been unredacted. All information has been provided before the Inquiry.
48	B4_11_10 Proposed ground floor plan, Masterplan	CD7.05 1510_A_B4_11_10_01		The Proposed ground floor master plan in Rev 02 has been unredacted. All information has been provided before the Inquiry.
49	B4_11_11 Proposed roof plan, Masterplan	CD7.22 1510_A_B4_11_11		Unnecessarily listed as 'redacted' in the drawing register. No changes.
50	B4_11_12 Proposed paving plan, Masterplan	CD7.22 1510_A_B4_11_12_01		The Proposed paving master plan in Rev 02 has been unredacted. All information has been provided before the Inquiry
51	B4_11_19 Proposed works on Cartwright Street, Masterplan	CD1.03C p92		Unnecessarily listed as 'redacted' in the drawing register. No changes.
52	B4_P11_21 Proposed ground floor plan, Masterplan, Entrance pavilion	CD1.03C p107		<p>No redaction to the original drawing. The Rev 01 has been labelled to identify the security check room. All information has been provided before the Inquiry.</p> <p>Use information for smaller rooms (areas with no public access) is not shown, which is however irrelevant to the planning.</p> <p><u>All works to heritage features shown.</u></p>

## Revised Drawings Schedule

- 1 1510\_A\_B1-\_P11\_09 Proposed basement floor plan - Johnson Smirke building Rev 01
- 2 1510\_A\_B1-\_P11\_10 Proposed ground floor plan - Johnson Smirke building Rev 01
- 3 1510\_A\_B1-\_P11\_11 Proposed first floor plan - Johnson Smirke building Rev 01
- 4 1510\_A\_B1-\_P11\_12 Proposed second floor plan - Johnson Smirke building Rev 01
- 5 1510\_A\_B1-\_P11\_13 Proposed third floor plan - Johnson Smirke building Rev 01
- 6 1510\_A\_B2-\_P11\_09 Proposed basement plan - Seaman's Registry building Rev 01
- 7 1510\_A\_B2-\_P11\_10 Proposed ground floor plan - Seaman's Registry building Rev 01
- 8 1510\_A\_B2-\_P11\_11 Proposed first floor plan - Seaman's Registry building Rev 01
- 9 1510\_A\_B2-\_P11\_12 Proposed second floor plan - Seaman's Registry building Rev 01
- 10 1510\_A\_B2-\_P11\_13 Proposed third floor plan - Seaman's Registry building Rev 01
- 11 1510\_A\_B2-\_P11\_14 Proposed fourth floor plan - Seaman's Registry building Rev 01
- 12 1510\_A\_B3A\_11\_09 Proposed Basement Plan - Cultural Exchange Building Rev 01
- 13 1510\_A\_B3A\_11\_10 Proposed Ground Floor Plan - Cultural Exchange Building Rev 01
- 14 1510\_A\_B3A\_11\_11 Proposed First Floor Plan - Cultural Exchange Building Rev 01
- 15 1510\_A\_B3A\_11\_12 Proposed Second Floor Plan - Cultural Exchange Building Rev 01
- 16 1510\_A\_B3A\_11\_13 Proposed Third Floor Plan - Cultural Exchange Building Rev 01
- 17 1510\_A\_B3A\_11\_14 Proposed Fourth Floor Plan - Cultural Exchange Building Rev 01
- 18 1510\_A\_B3A\_11\_15 Proposed Fifth Floor Plan - Cultural Exchange Building Rev 01
- 19 1510\_A\_B3A\_11\_16 Proposed Sixth Floor Plan - Cultural Exchange Building Rev 01
- 20 1510\_A\_B3b\_11\_08 Proposed Basement Plan - Embassy House North - Sheet 1 of 2 Rev 02
- 21 1510\_A\_B3b\_11\_09 Proposed Basement Plan - Embassy House South - Sheet 2 of 2 Rev 02
- 22 1510\_A\_B3b\_11\_10 Proposed Ground Floor Plan - Embassy House North - Sheet 1 of 2 Rev 02
- 23 1510\_A\_B3b\_11\_11 Proposed Ground Floor Plan - Embassy House South - Sheet 2 of 2 Rev 02
- 24 1510\_A\_B3b\_11\_12 Proposed First Floor Plan - Embassy House North - Sheet 1 of 2 Rev 02
- 25 1510\_A\_B3b\_11\_13 Proposed First Floor Plan - Embassy House South - Sheet 2 of 2 Rev 02
- 26 1510\_A\_B3b\_11\_14 Proposed Second Floor Plan - Embassy House North - Sheet 1 of 2 Rev 02
- 27 1510\_A\_B3b\_11\_15 Proposed Second Floor Plan - Embassy House South - Sheet 2 of 2 Rev 02
- 28 1510\_A\_B3b\_11\_16 Proposed Third Floor Plan - Embassy House North - Sheet 1 of 2 Rev 02
- 29 1510\_A\_B3b\_11\_17 Proposed Third Floor Plan - Embassy House South - Sheet 2 of 2 Rev 02
- 30 1510\_A\_B3b\_11\_18 Proposed Fourth Floor Plan - Embassy House North - Sheet 1 of 2 Rev 02
- 31 1510\_A\_B3b\_11\_19 Proposed Fourth Floor Plan - Embassy House South - Sheet 2 of 2 Rev 02
- 32 1510\_A\_B3b\_11\_20 Proposed Fifth Floor Plan - Embassy House North - Sheet 1 of 2 Rev 02
- 33 1510\_A\_B3b\_11\_21 Proposed Fifth Floor Plan - Embassy House South - Sheet 2 of 2 Rev 02
- 34 1510\_A\_B3b\_11\_22 Proposed Sixth Floor Plan - Embassy House North - Sheet 1 of 2 Rev 03
- 35 1510\_A\_B3b\_11\_23 Proposed Sixth Floor Plan - Embassy House South - Sheet 2 of 2 Rev 03
- 36 1510\_A\_B3b\_11\_24 Proposed Seventh Floor Plan - Embassy House North - Sheet 1 of 2 Rev 03
- 37 1510\_A\_B3b\_11\_25 Proposed Seventh Floor Plan - Embassy House South - Sheet 2 of 2 Rev 03
- 38 1510\_A\_B3b\_11\_26 Proposed Roof Floor Plan - Embassy House North - Sheet 1 of 2 Rev 03
- 39 1510\_A\_B3b\_11\_27 Proposed Roof Floor Plan - Embassy House South - Sheet 2 of 2 Rev 03
- 40 1510\_A\_B4-\_11\_09 Proposed Basement Plan – Masterplan Rev 02
- 41 1510\_A\_B4-\_11\_10 Proposed Ground Floor Plan – Masterplan Rev 02
- 42 1510\_A\_B4-\_11\_12 Proposed Paving Plan – Masterplan Rev 02
- 43 1510\_A\_B4-\_P11\_21 Proposed Ground Floor Plan - Masterplan - Entrance Pavilion Rev 01

## Revised Drawings



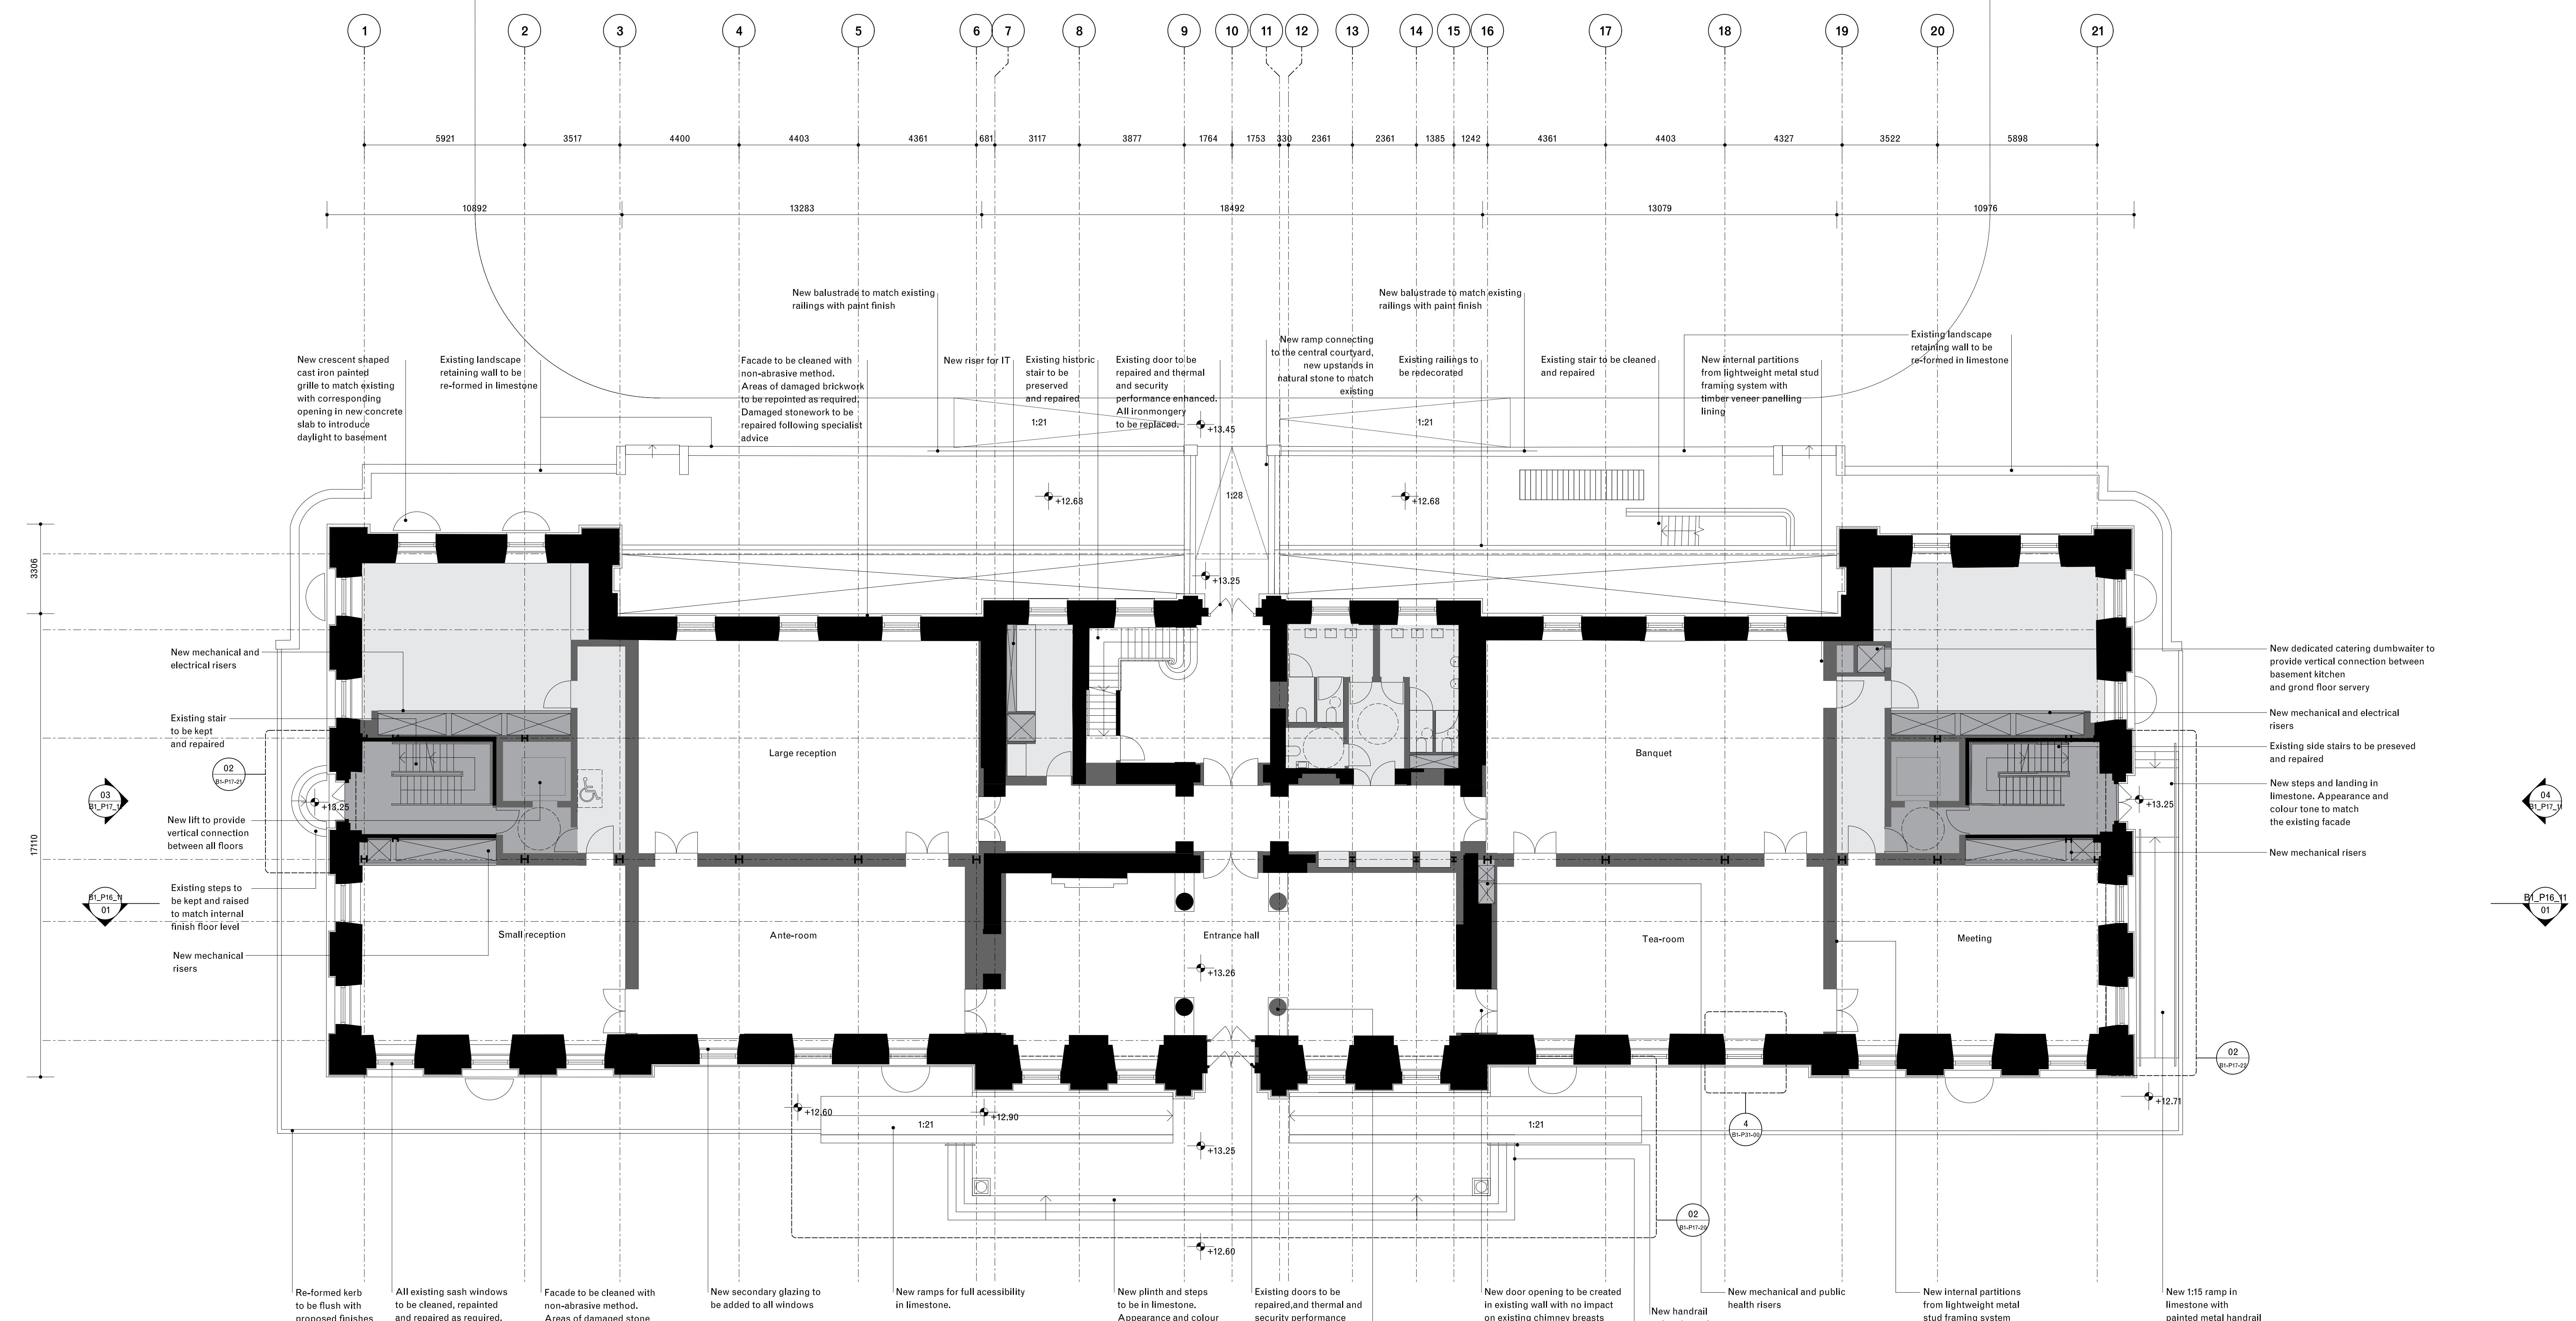

© David Chipperfield Architects Ltd.  
London EC1V 9DZ  
T +44 20 7629 8800  
www.davidchipperfield.com

Project Royal Mint Court  
Client Chinese Embassy in the UK

Planning Application and Listed Building Consent  
(Addendum)

Drawing name Proposed ground floor plan  
Johnson Smirke building  
Drawing number B1-P11\_10

Date 16/05/2024  
Scale 1:100 / A0  
Drawn / Checked B1 / OU  
Approved B1  
CAD Reference 1510\_A\_B1\_P11\_10.dgn

Revision 01  
Planning

16/05/2024

1:100 / A0

Drawn / Checked B1 / OU


Approved B1

CAD Reference 1510\_A\_B1\_P11\_10.dgn


01 Proposed ground floor plan, Johnson Smirke building  
Scale 1:100


01  
B1\_P11\_10

01  
B1\_P11\_10

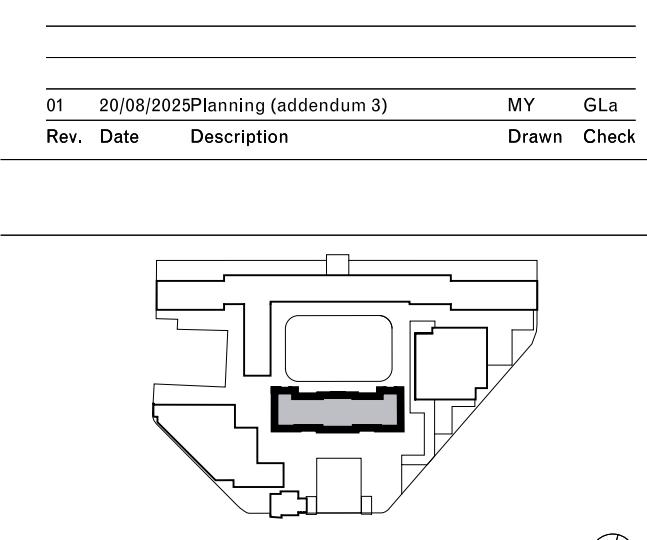

David Chipperfield Architects

 

 

01 Proposed second floor plan, Johnson Smirke building  
Scale 1:100

1 Proposed second floor plan, Johnson Smirke bu

Scale

01  
B1 P17 10

01  
P16\_10

C/O Fora, 9 Dallington Street  
London EC1V 0LN  
T +44 20 7620 4800  
[www.davidchipperfield.com](http://www.davidchipperfield.com)

---

Project	Project
<b>Royal Mint Court</b>	15

---

Client

## Chinese Embassy in the UK


# Planning Application and Listed Building Control (Addendum)


**Proposed second floor plan  
Johnson Smirke building**

---

Date **16/05/2024**  
Scale / Format **1:100 / A0**  
Drawn / Checked **ISP / GL a / OII**

Approved By: **BB**  
CAD Reference: 1510\_A\_B1\_-P11\_12.dgn

 

 

Existing

Proposed

General notes:


Do not scale from drawings.  
 Errors to be reported immediately to the Architect.  
 To be read in conjunction with all relevant Architects', Services and Structural Engineers' drawings.  
 All existing site, tree and building information has been compiled from different sources.  
 All dimensions to be checked on site.

01 20/08/2025 Planning (addendum 3) MY GLa

Rev. Date Description Drawn Check

C/O Fora, 9 Dallington Street  
London EC1V 0LN  
T +44 20 7620 4800  
www.davidchipperfield.com

---

 

© David Chipperfield Architects

## (Addendum)



Proposed ground floor plan B2- P11  
Seaman's Registry building

## Seaman's Registry building

---

Scale / Format **1:100 / A0**

Scale / Format **1:100 / A0**  
Drawn / Checked **CC, Dlt / GLa / OU**  
Approved **BB**

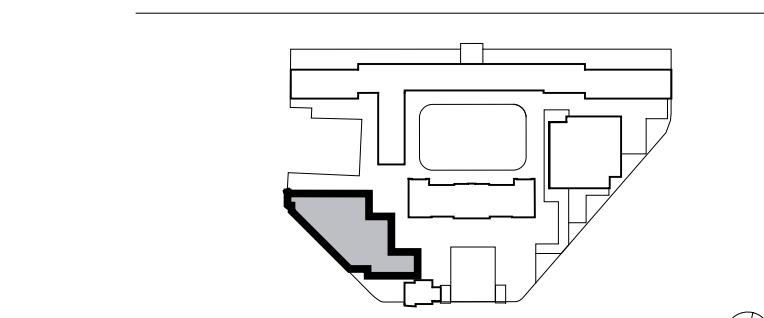 

David Chipperfield Architects

CIO Fora, 9 Dallington Street  
London EC2M 7DZ  
T +44 20 7629 8800  
www.davidchipperfield.com

Project: Royal Mint Court

Project number: 1510

Client: Chinese Embassy in the UK

Planning Application and Listed Building Consent  
(Addendum)


Drawing name: Proposed first floor plan  
Seaman's Registry building

Drawing number: B2\_P11\_11

Date: 16/05/2024  
Scale / Format: 1:100 / A0  
Drawn / Checked: Ctr. / GLs / OU  
Approved: B2  
CAD Reference: 1510\_A\_B2\_P11\_1.dgn

Revision: 01

Planning

 

---


**General notes:**


- Do not scale from drawings.
- Errors to be reported immediately to the Architect.
- To be read in conjunction with all relevant Architects', Services and Structural Engineers' drawings.
- All existing site, tree and building information has been compiled from different sources.
- All dimensions to be checked on site.

The image shows an architectural floor plan of a building. A large, irregularly shaped room in the lower-left quadrant is filled with a dark gray color, indicating a specific area of interest. The rest of the building's layout is shown in white lines, featuring multiple rooms, a central rectangular atrium, and a staircase. In the bottom right corner, there is a north arrow consisting of a circle with a crosshair. Below the plan, three callout numbers are present: '1' on the far left, '2' in the center, and '5' on the right side.

# David Chipperfield Architects

Project	Project number	
<b>Royal Mint Court</b>	<b>1510</b>	
<hr/>		
Client		
<b>Chinese Embassy in the UK</b>		
<hr/>		
© David Chipperfield Architects Ltd.		
<b>Planning Application and Listed Building Consent (Addendum)</b>		
Drawing name	Drawing number	
<b>Proposed second floor plan Seaman's Registry building</b> <b>B2-_P11_12</b>		
<hr/>		
Date	<b>16/05/2024</b>	Revision
Scale / Format	<b>1:100 / A0</b>	<b>01</b>
Drawn / Checked	<b>CC, DlT / GLa / OU</b>	Planning

 

 


General notes:

- Do not scale from drawings.
- Errors to be reported immediately to the Architect.
- To be read in conjunction with all relevant Architects', Services and Structural Engineers' drawings.
- All existing site, tree and building information has been compiled from different sources.
- All dimensions to be checked on site.

01	20/08/2025	Planning (addendum 3)	MY	GLa
Rev.	Date	Description	Drawn	Check

---

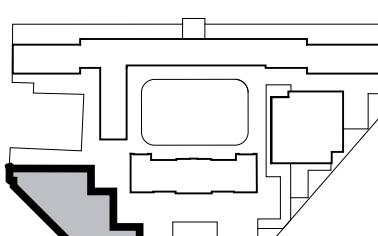

The image shows an architectural floor plan of a building. The plan consists of various rooms and a central atrium. A large, irregularly shaped area in the bottom-left corner is filled with a dark grey color, while the rest of the building's outline and internal rooms are shown in white. The plan is oriented with the top edge representing the front of the building.


---

# David Chipperfield Architects

---

Project	Project number
<b>Royal Mint Court</b>	<b>1510</b>
Client	<b>Chinese Embassy in the UK</b>

© David Chipperfield Architects Ltd.

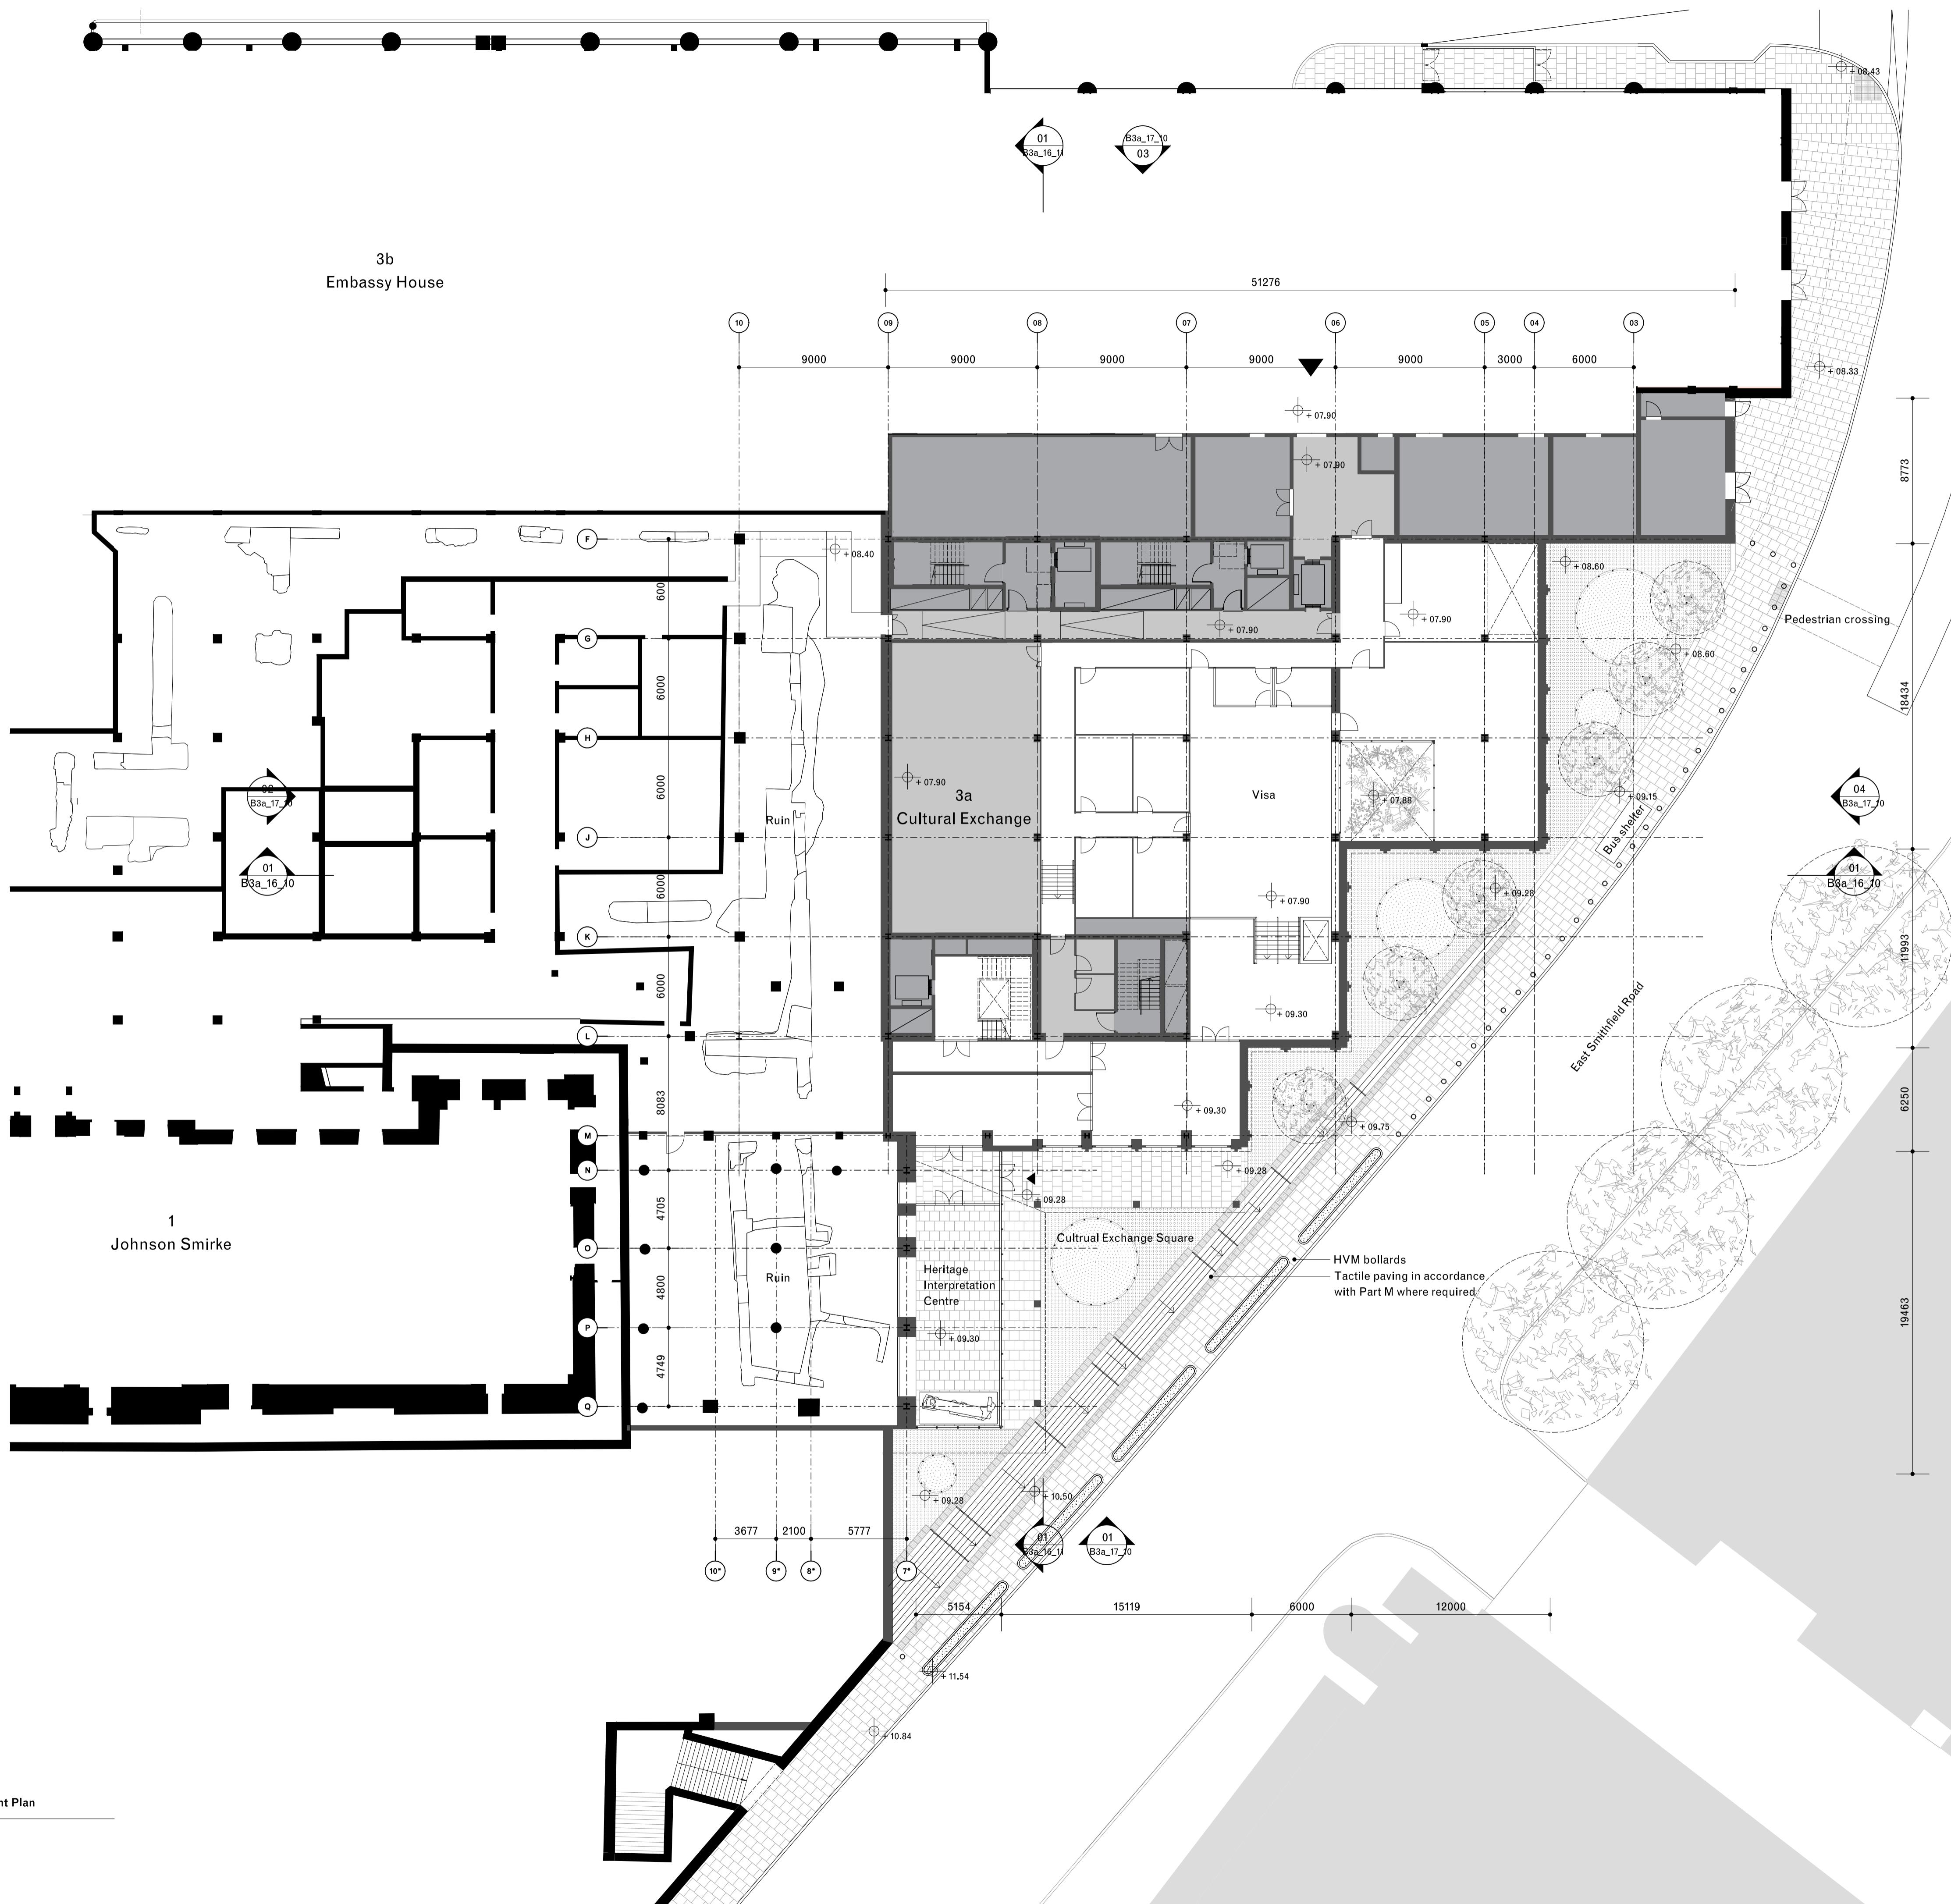

**General notes:**

- Do not scale from drawings.
- Errors to be reported immediately to the Architect.
- To be read in conjunction with all relevant Architects', Services and Structural Engineers' drawings.
- All existing site, tree and building information has been compiled from different sources.
- All dimensions to be checked on site.

---

01 20/08/2025Planning (addendum 3) MY GLa

C/O Fora, 9 Dallington Street  
London EC1V 0LN  
T +44 20 7620 4800  
[www.davidchipperfield.com](http://www.davidchipperfield.com)

Project Project number

---

Client

## Planning (addendum)

Drawing name Drawing number  
**Proposed basement plan** **DC-11-00**


Cultural Exchange building


Date 16/05/2024 Revision  
Scale / Format 1:200 / A1 01

**Approved** **BB**  
**CAD Reference** **1510\_A\_B3A\_11\_09.dgn**

01 Proposed Basement Plan  
Scale 1:200

3b  
Embassy House

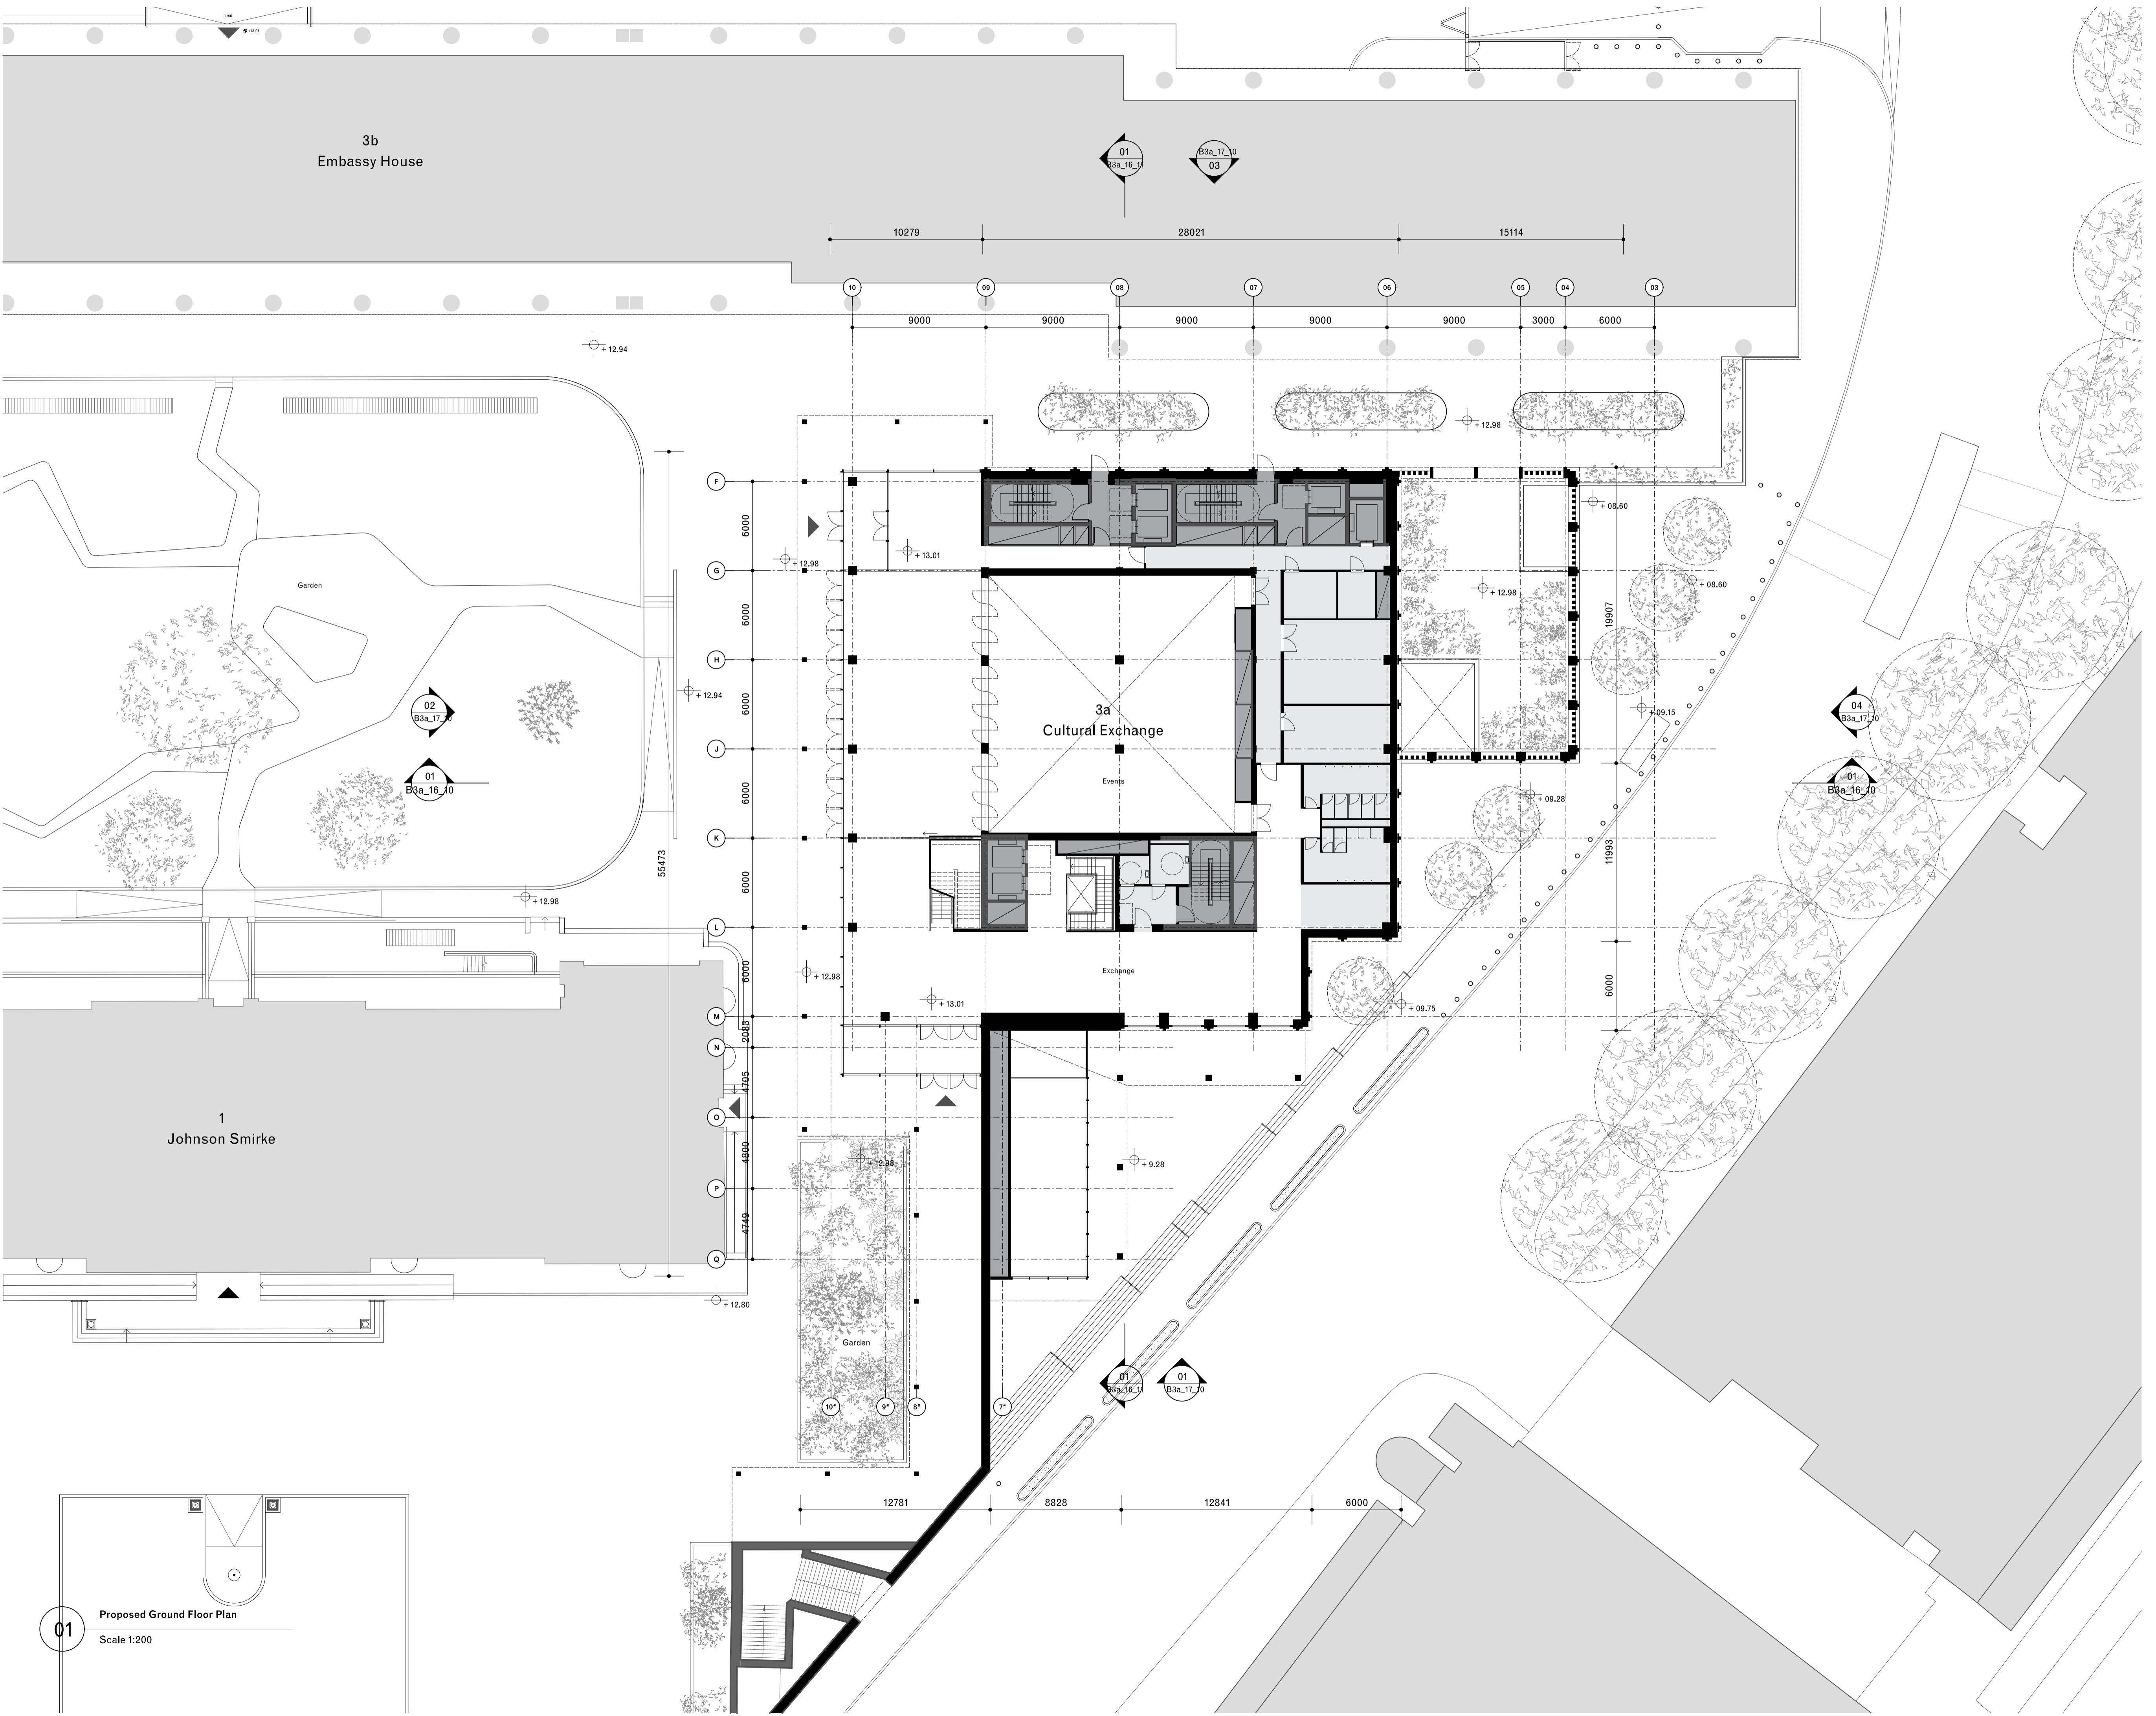

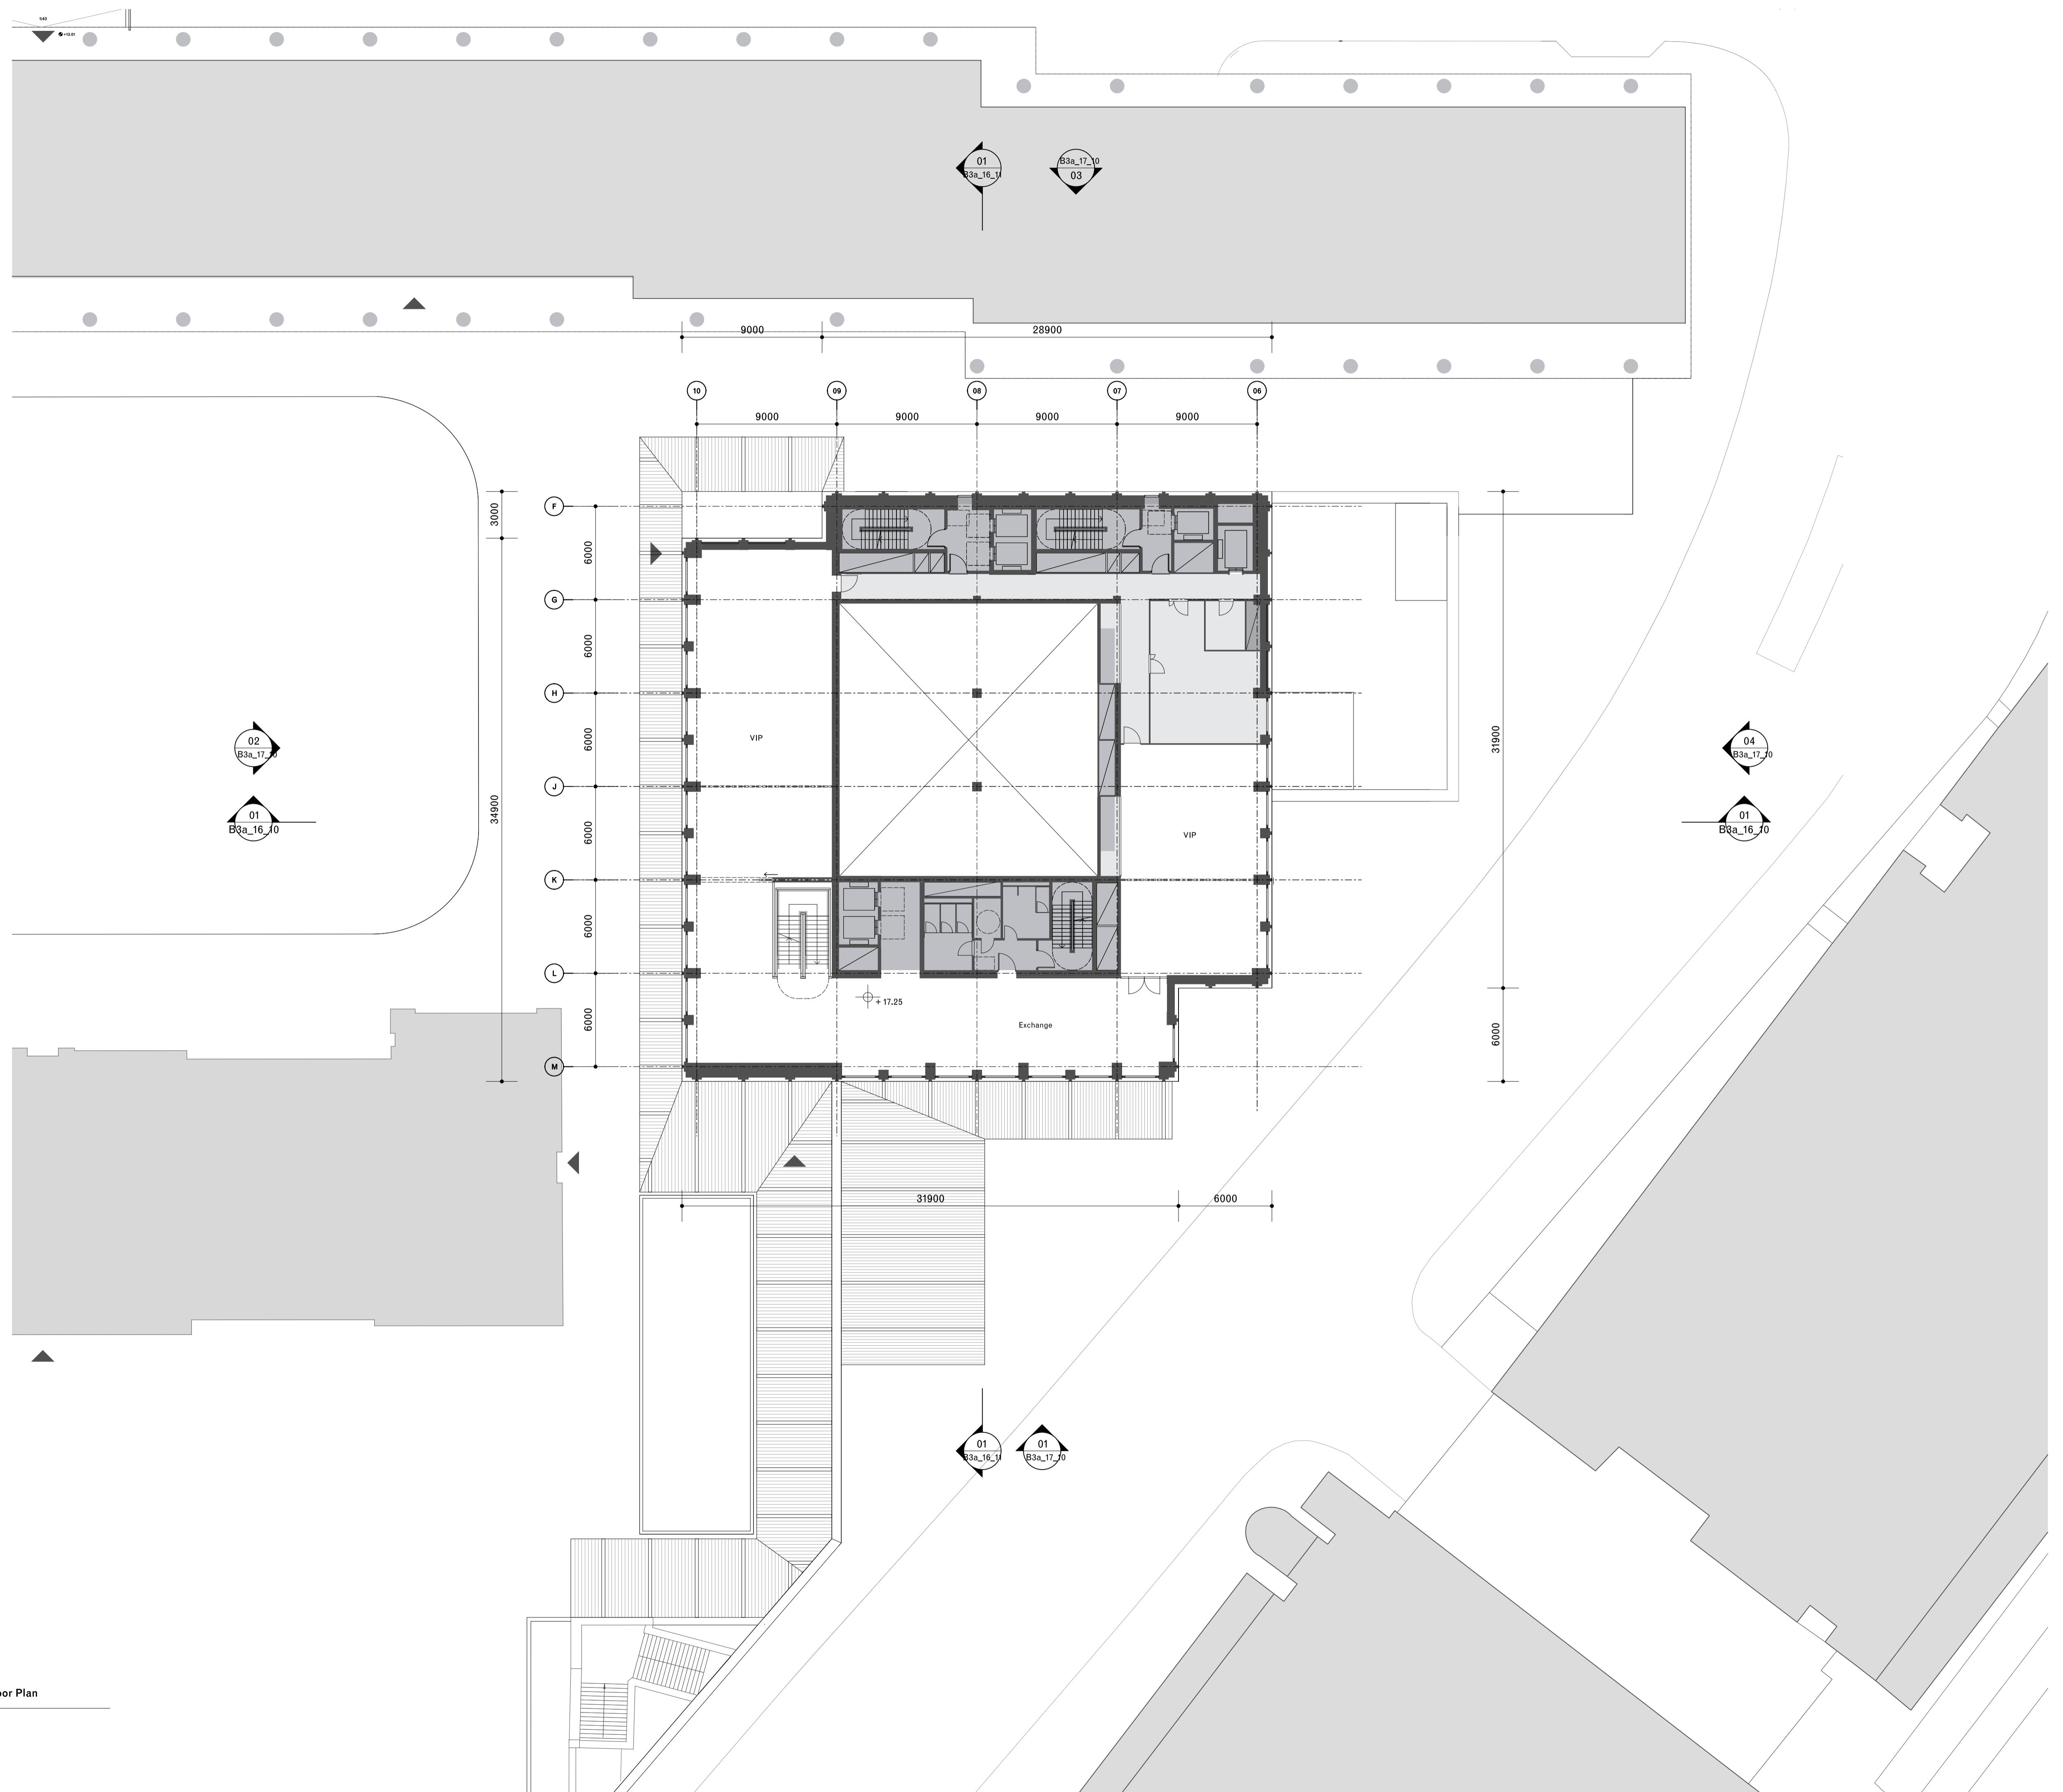

General notes:

- Do not scale from drawings.
- Errors to be reported immediately to the Architect.
- To be read in conjunction with all relevant Architects', Services and Structural Engineers' drawings.
- All existing site, tree and building information has been compiled from different sources.
- All dimensions to be checked on site.

Existing  
Proposed

01 20/08/2025Planning (addendum 3) MY GLa



David Chipperfield Architects

C/O Fora, 9 Dallington Street  
London EC1V 0LN  
T +44 20 7620 4800  
[www.davidchipperfield.com](http://www.davidchipperfield.com)

Project	Project number
Royal Mint Court	1510

---

## Client

# Chinese Embassy in the UK

© David Chipperfield Architects Ltd.

## Planning (addendum)


Proposed first floor plan  
Cultural Exchange building

---

Date 16/05/2024 Revision  
Scale / Format 1:200 / A1 01

Approved **BB**  
CAD Reference 1510\_A\_B3A\_11\_11.dgn

**01** Proposed First Floor Plan

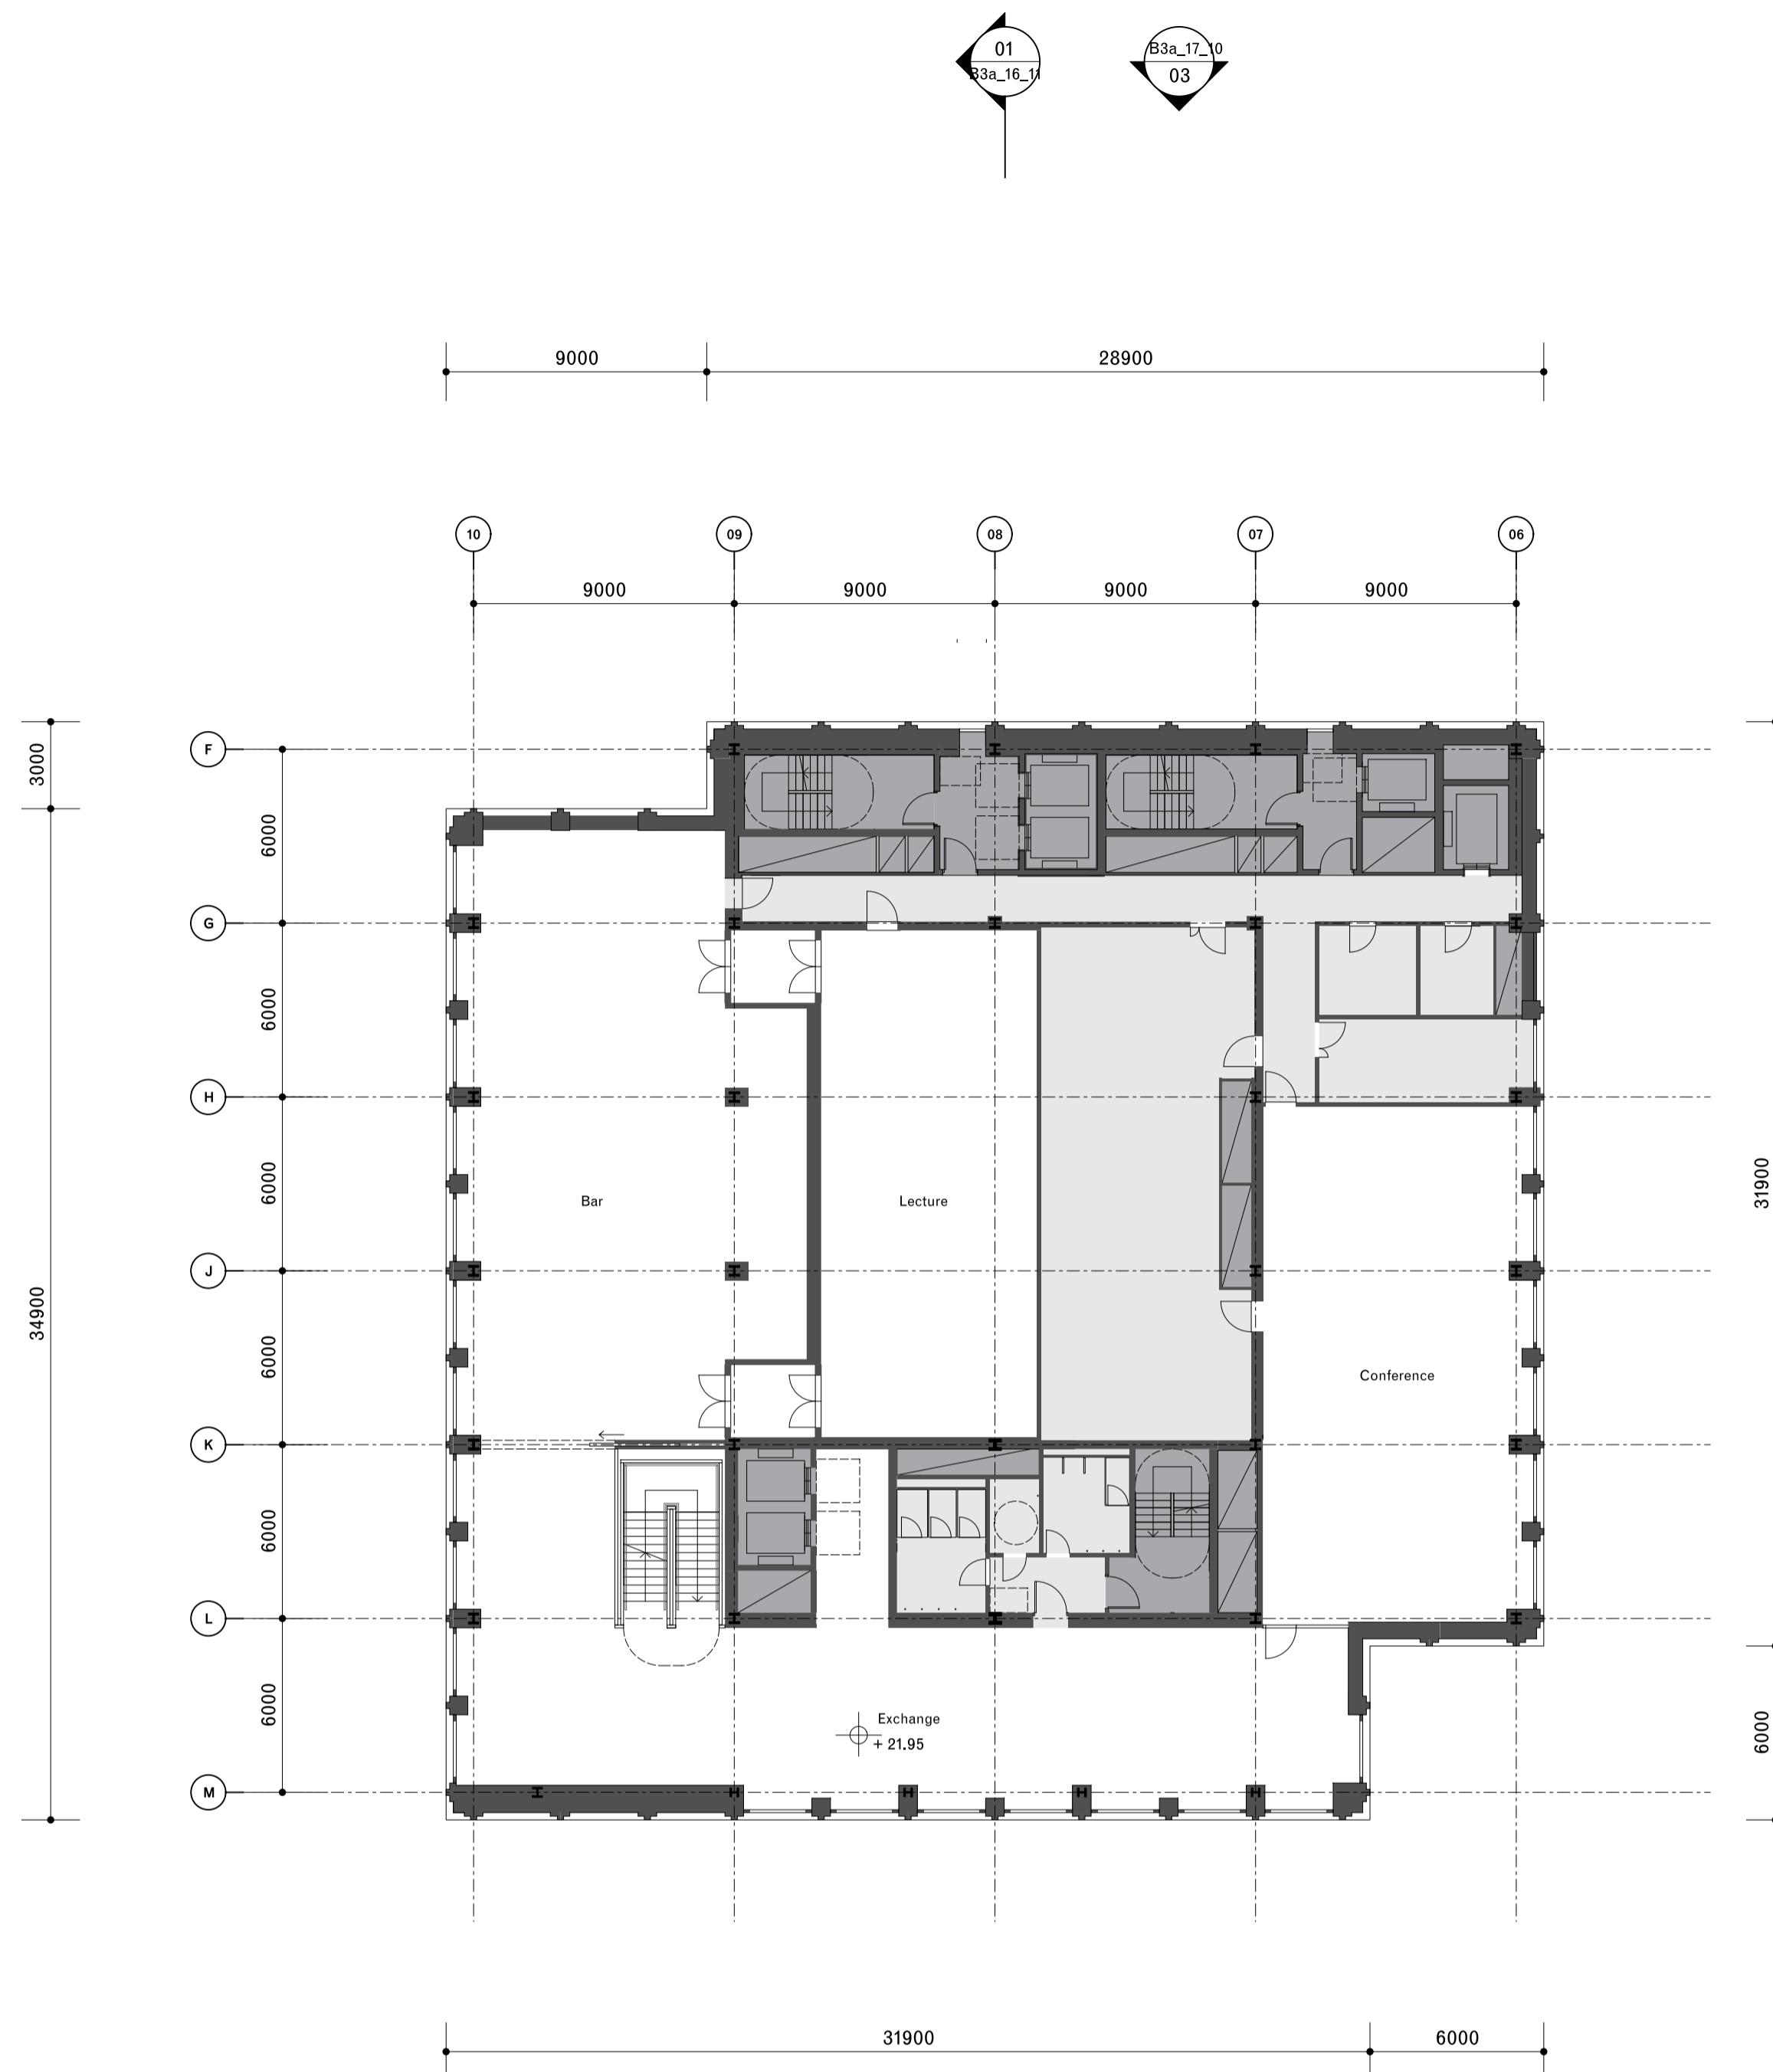


01 Proposed Second floor Plan  
Scale 1:200

General notes:  
Do not scale from drawings.  
Errors to be reported immediately to the Architect.  
To be read in conjunction with all relevant Architects',  
Services and Structural Engineers' drawings.  
All existing site, tree and building information has been compiled  
from different sources.  
All dimensions to be checked on site.

■ Existing  
■ Proposed

01 20/08/2025 Planning (addendum 3) MY GLa  
Rev. Date Description Drawn Check

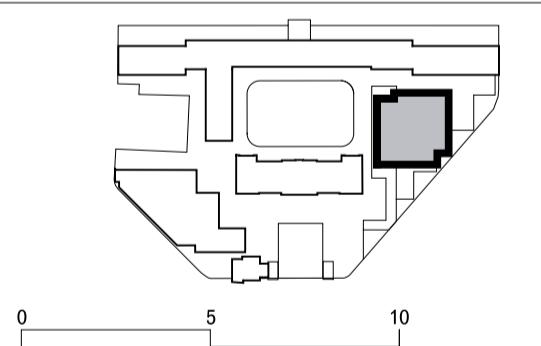

David Chipperfield Architects

C/O Fora, 9 Dillington Street  
London EC1V 8LN  
T +44 20 7829 4800  
www.davidchipperfield.com

Project Royal Mint Court  
Project number 1510





Client Chinese Embassy in the UK


© David Chipperfield Architects Ltd.

Planning (addendum)

Drawing name Proposed second floor plan  
Drawing number B3a\_11\_12

Date 16/05/2024  
Scale / Format 1:200 / A1  
Drawn / Checked JPa / GLa / OU  
Approved BB  
CAD Reference 1510\_A\_B3A\_11\_12.dgn

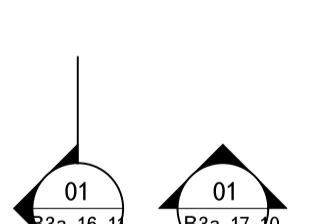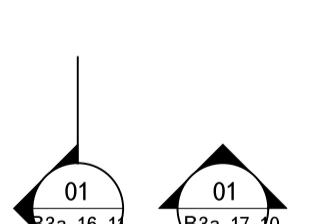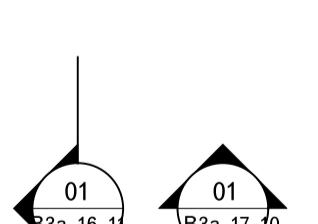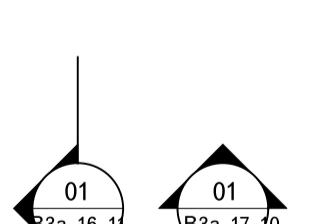

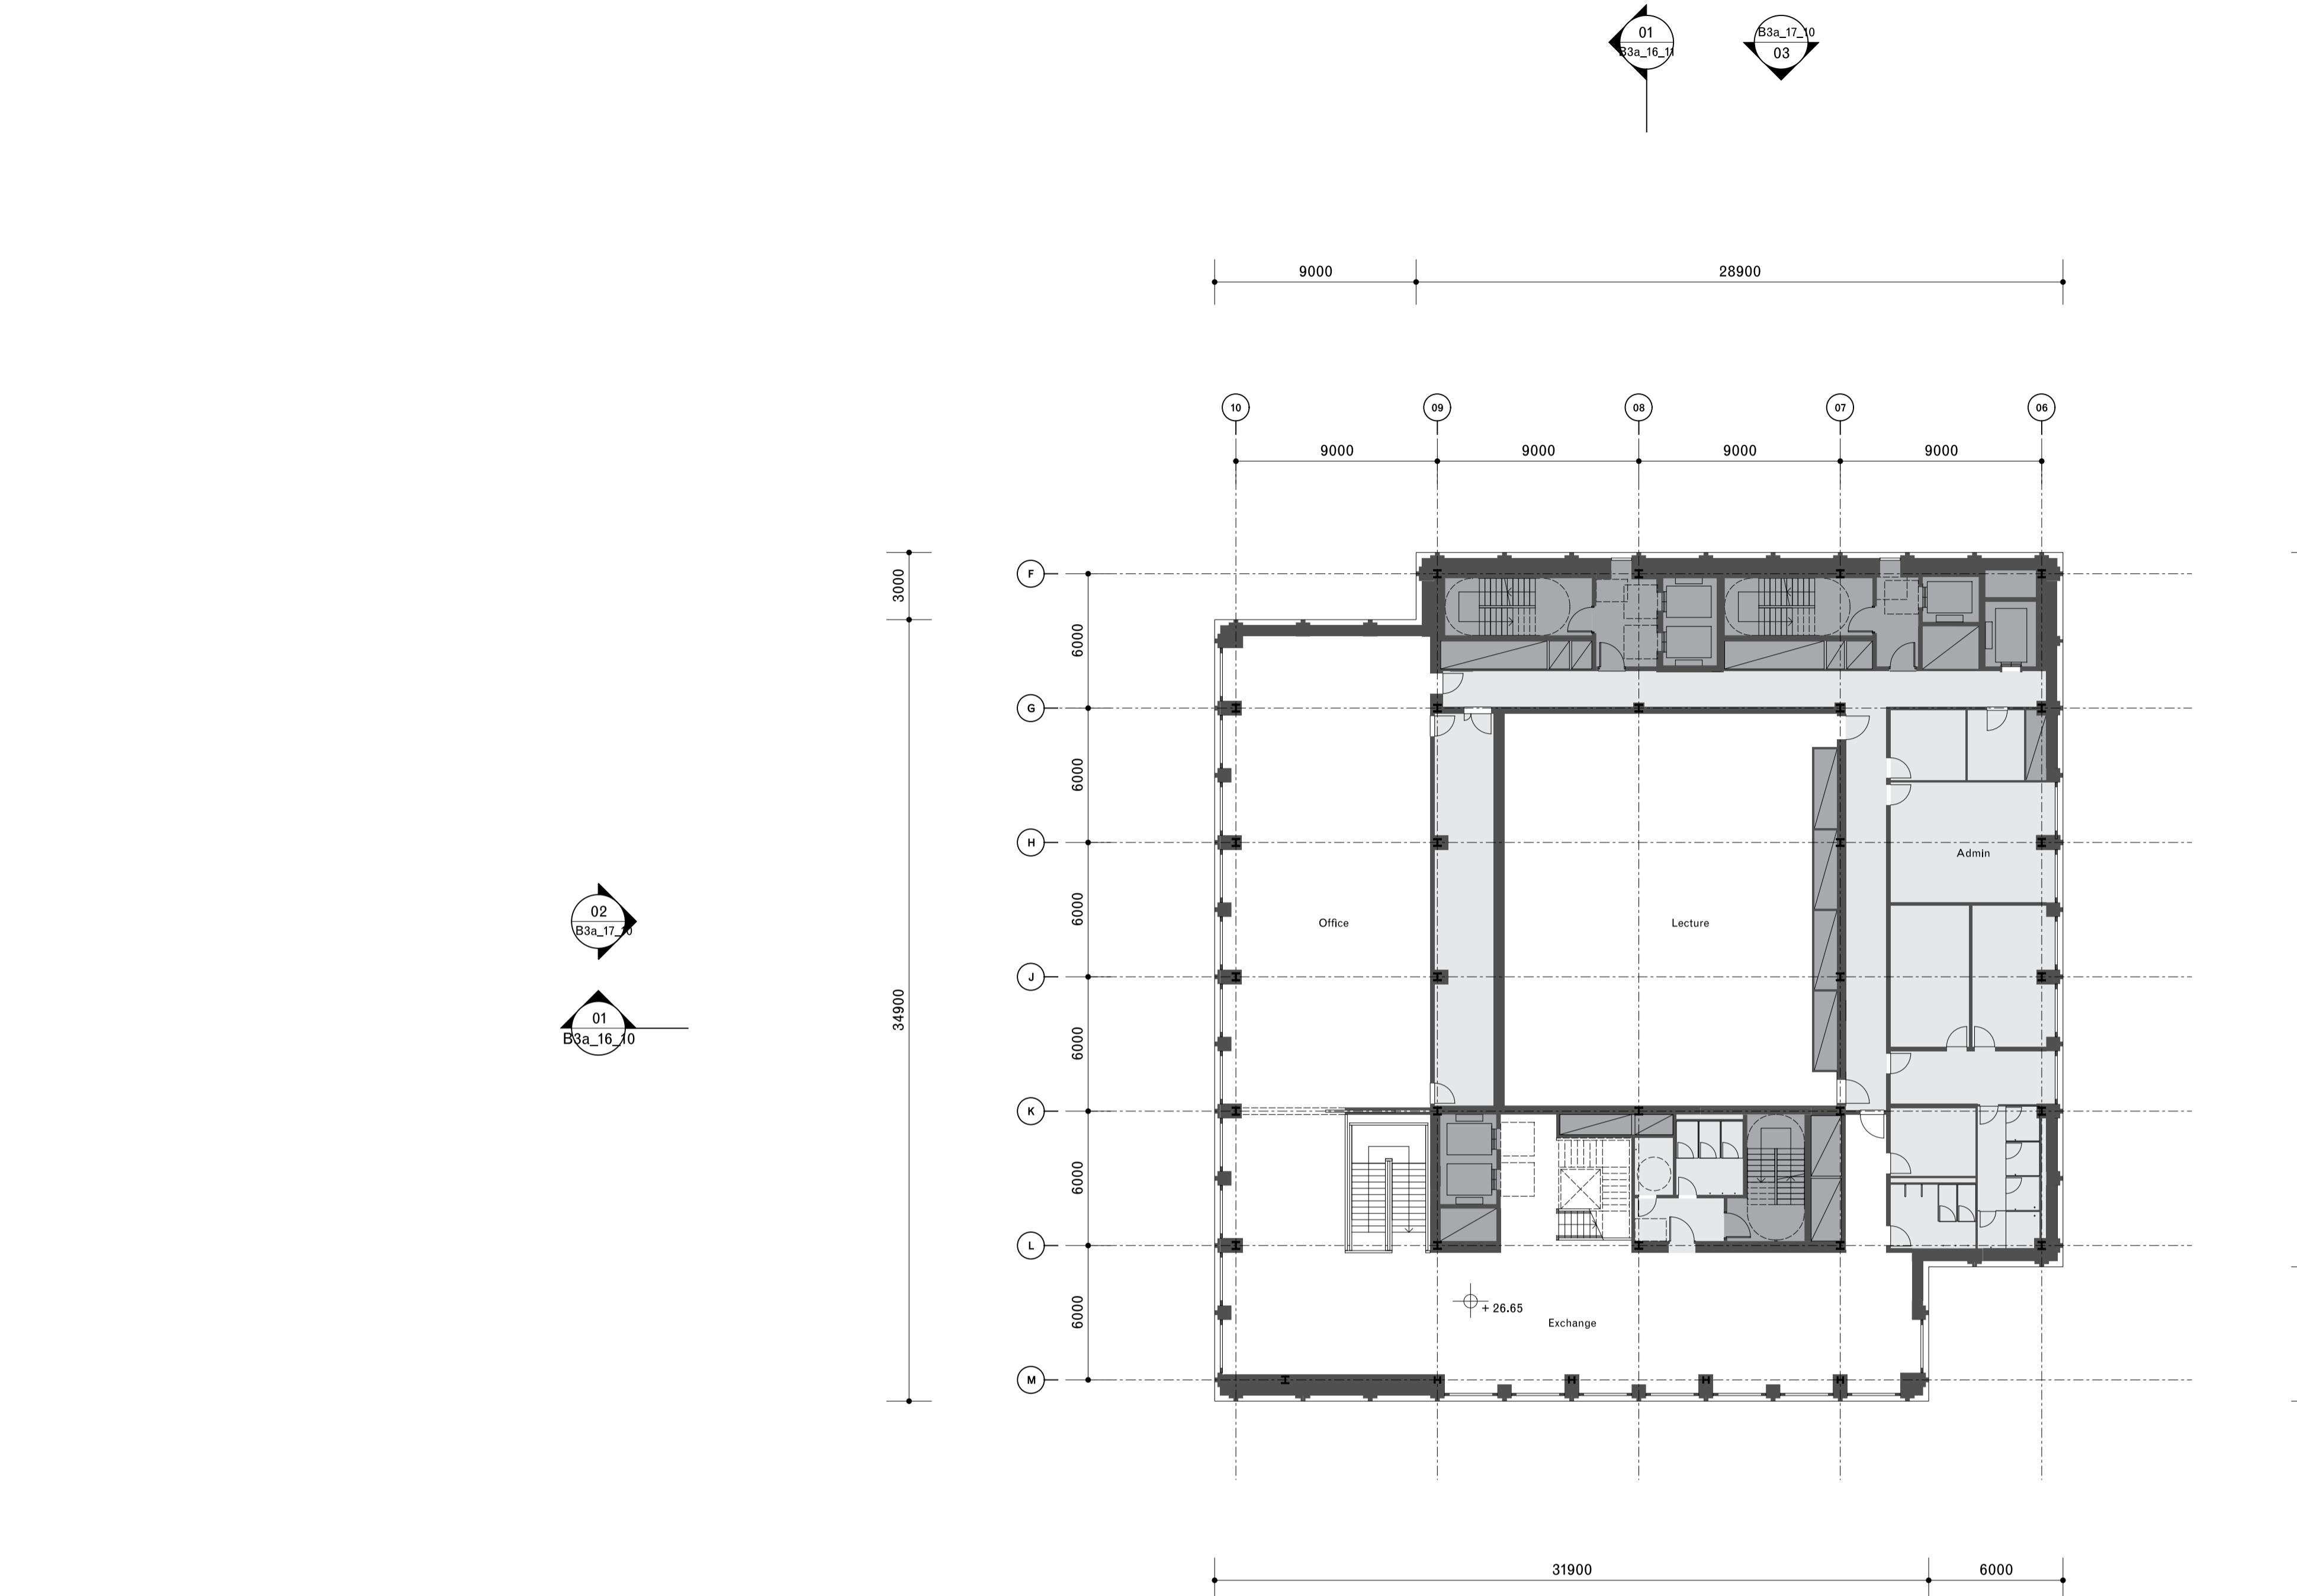


01 Proposed Third Floor Plan  
Scale 1:200

General notes:  
Do not scale from drawings.  
Errors to be reported immediately to the Architect.  
To be read in conjunction with all relevant Architects',  
Services and Structural Engineers' drawings.  
All existing site, tree and building information has been compiled  
from different sources.  
All dimensions to be checked on site.

■ Existing  
■ Proposed

01 20/08/2025 Planning (addendum 3) MY GLa  
Rev. Date Description Drawn Check

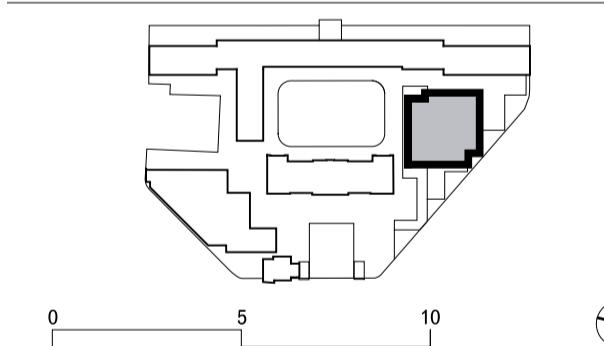

David Chipperfield Architects

C/O Fora, 9 Dillington Street  
London EC1V 8LN  
T +44 20 7829 4800  
www.davidchipperfield.com

Project Royal Mint Court  
Project number 1510






Client Chinese Embassy in the UK


© David Chipperfield Architects Ltd.

Planning (addendum)

Drawing name Proposed third floor plan  
Cultural Exchange building B3a\_11\_13

Date	16/05/2024	Revision	01
Scale / Format	1:200 / A1		Planning
Drawn / Checked	JPa / GLa		
Approved	BB		
CAD Reference	1510_A_B3A_11_13.dgn		

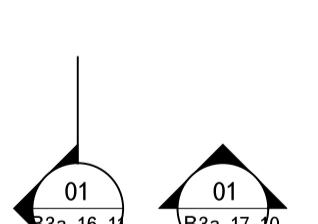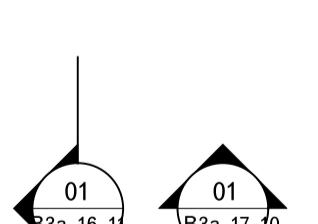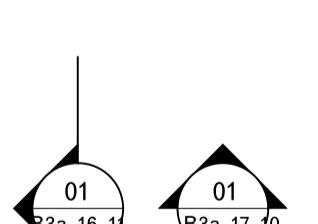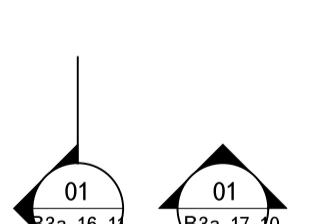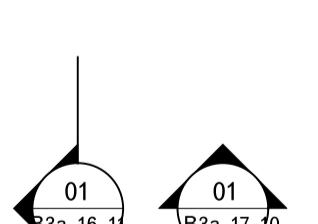


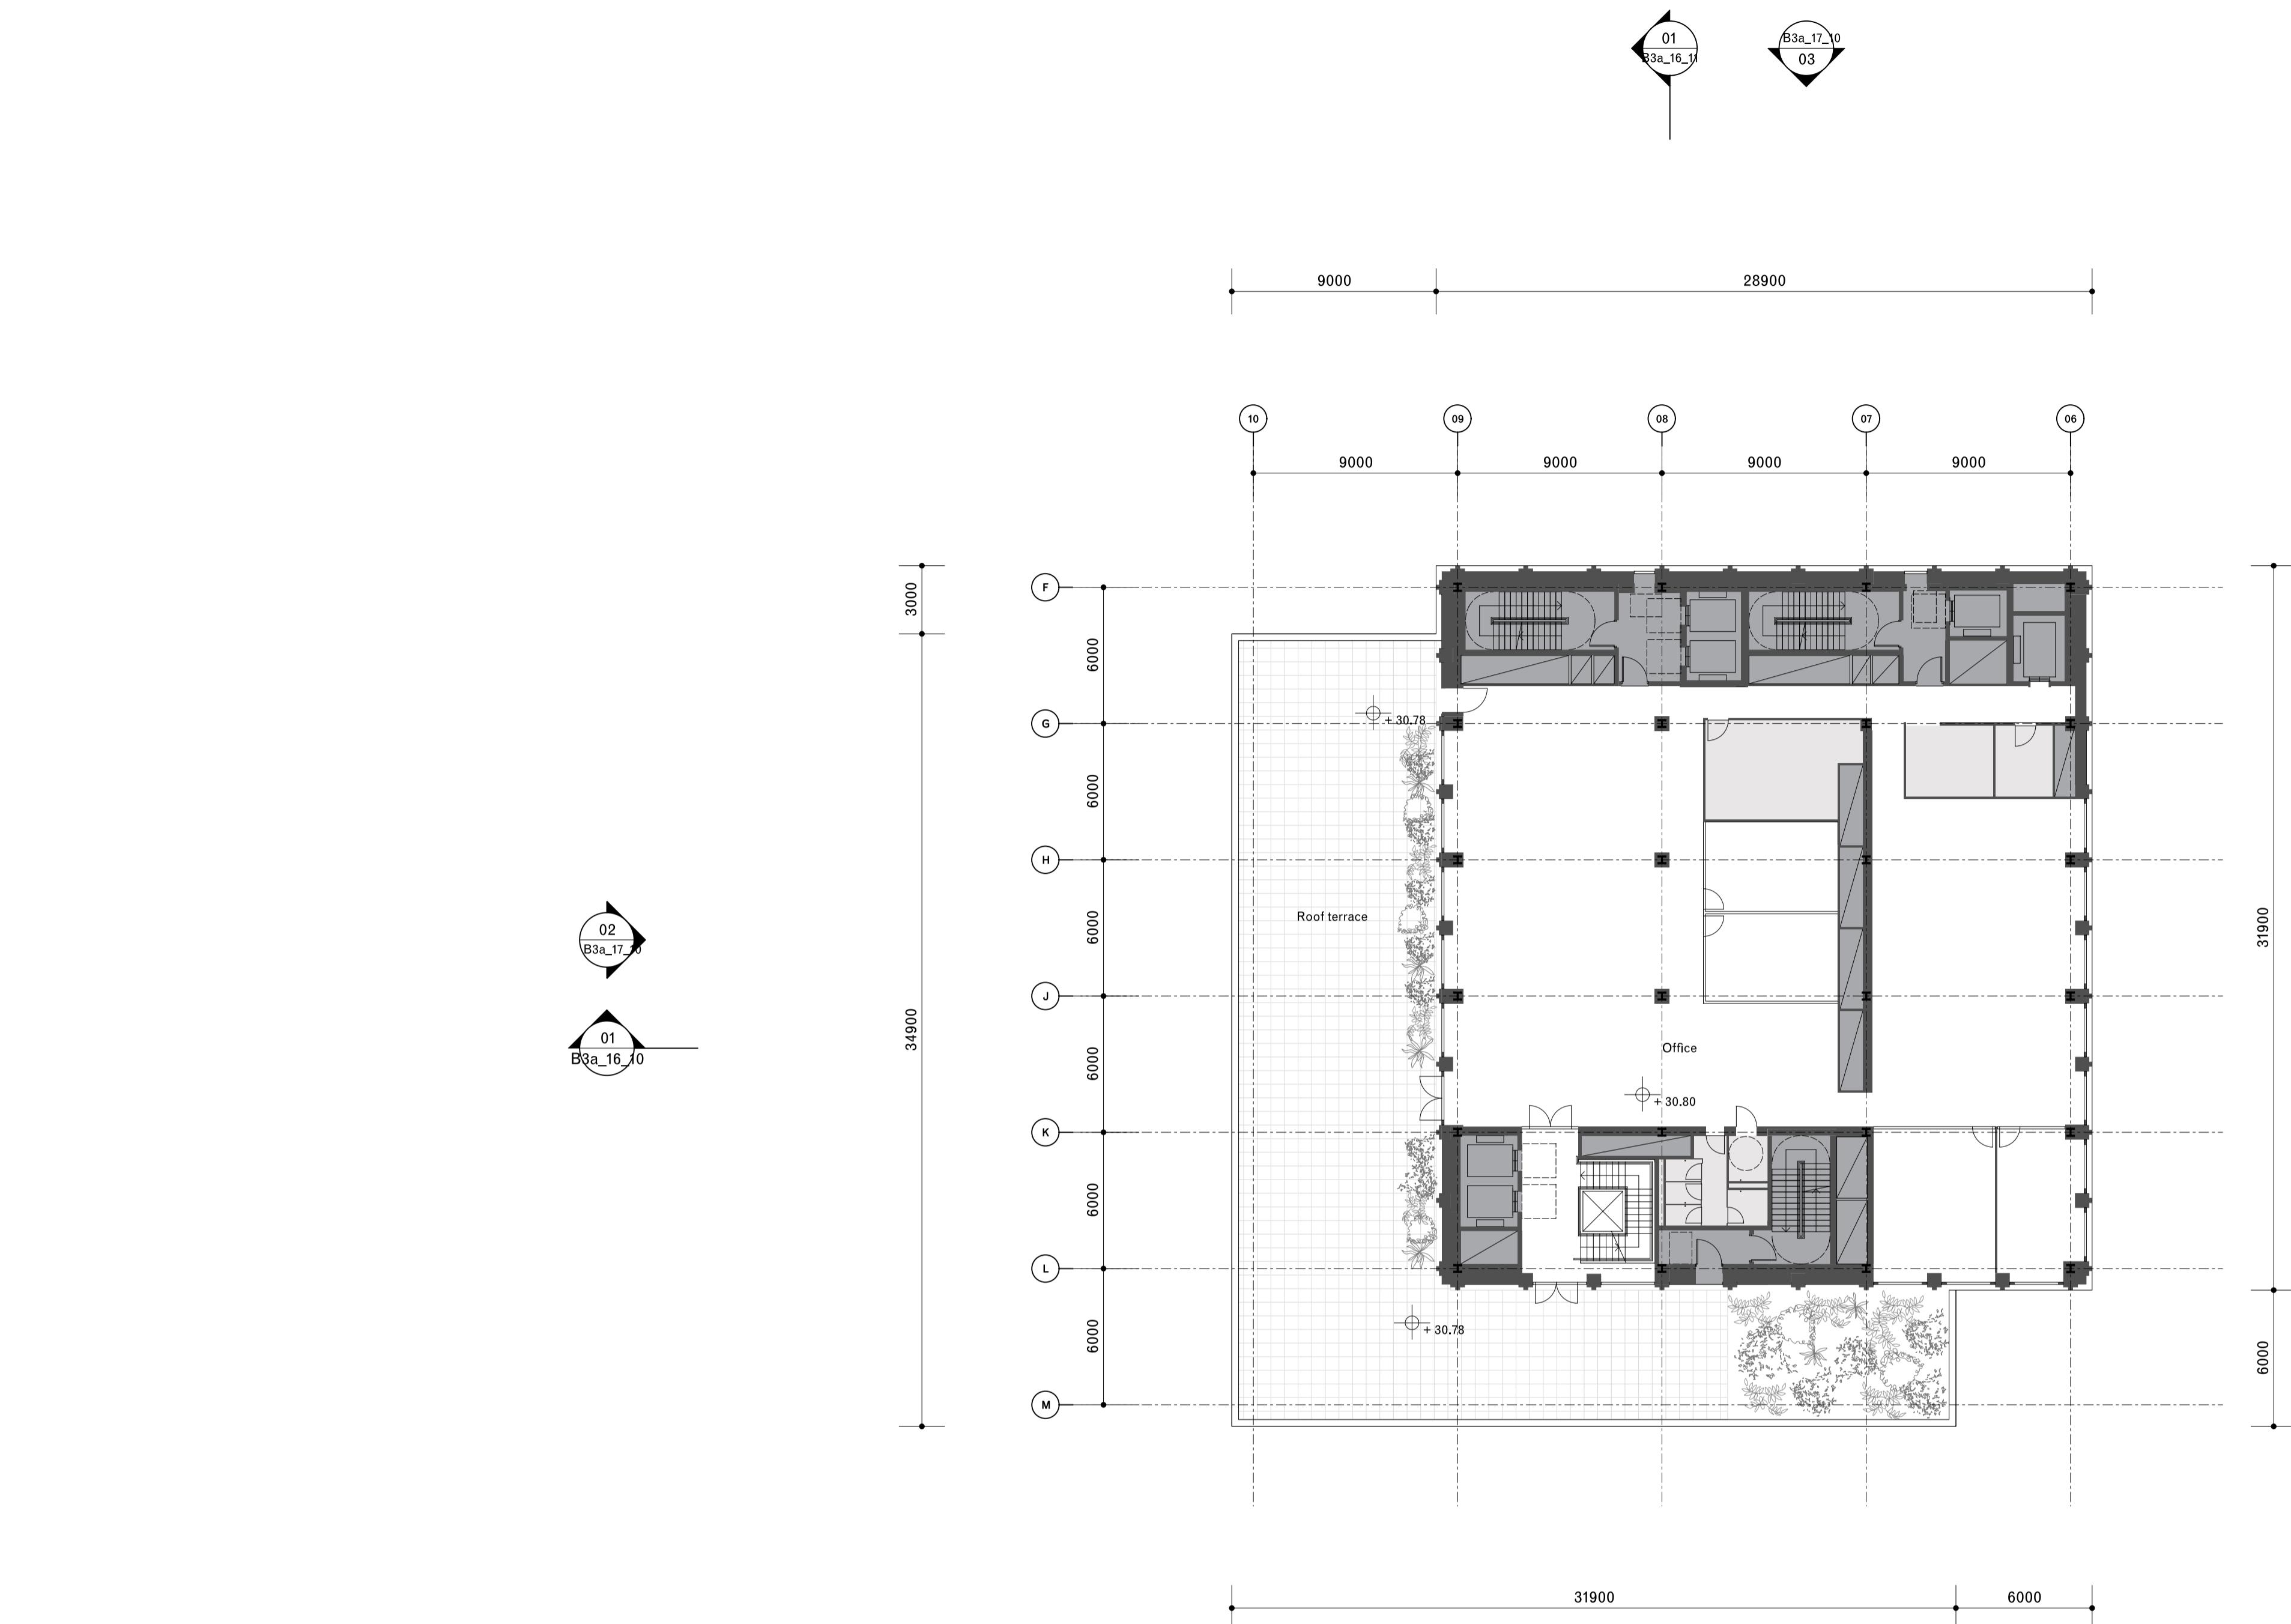

General notes:  
 Do not scale from drawings.  
 Errors to be reported immediately to the Architect.  
 To be read in conjunction with all relevant Architects',  
 Services and Structural Engineers' drawings.  
 All existing site, tree and building information has been compiled  
 from different sources.  
 All dimensions to be checked on site.

■ Existing  
 ■ Proposed

01 20/08/2025 Planning (addendum 3) MY GLa  
 Rev. Date Description Drawn Check

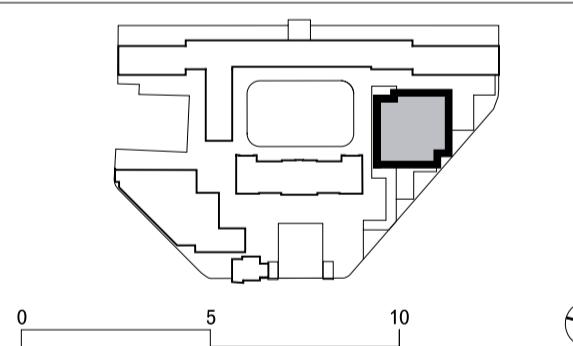

David Chipperfield Architects

C/O Fora, 9 Dillington Street  
 London EC1V 8LN  
 T +44 20 7829 4800  
 www.davidchipperfield.com

Project Royal Mint Court  
 Project number 1510

Client Chinese Embassy in the UK

Planning (addendum)  
 Drawing name Proposed fourth floor plan  
 Cultural Exchange building B3a\_11\_14  
 Date 16/05/2024 Revision 01  
 Scale / Format 1:200 / A1  
 Drawn / Checked JPa / GLa / OU  
 Approved BB Planning  
 CAD Reference 1510\_A\_B3A\_11\_14.dgn


01  
 Proposed Forth Floor Plan  
 Scale 1:200

01  
 B3a\_16\_10  
 01  
 B3a\_17\_10




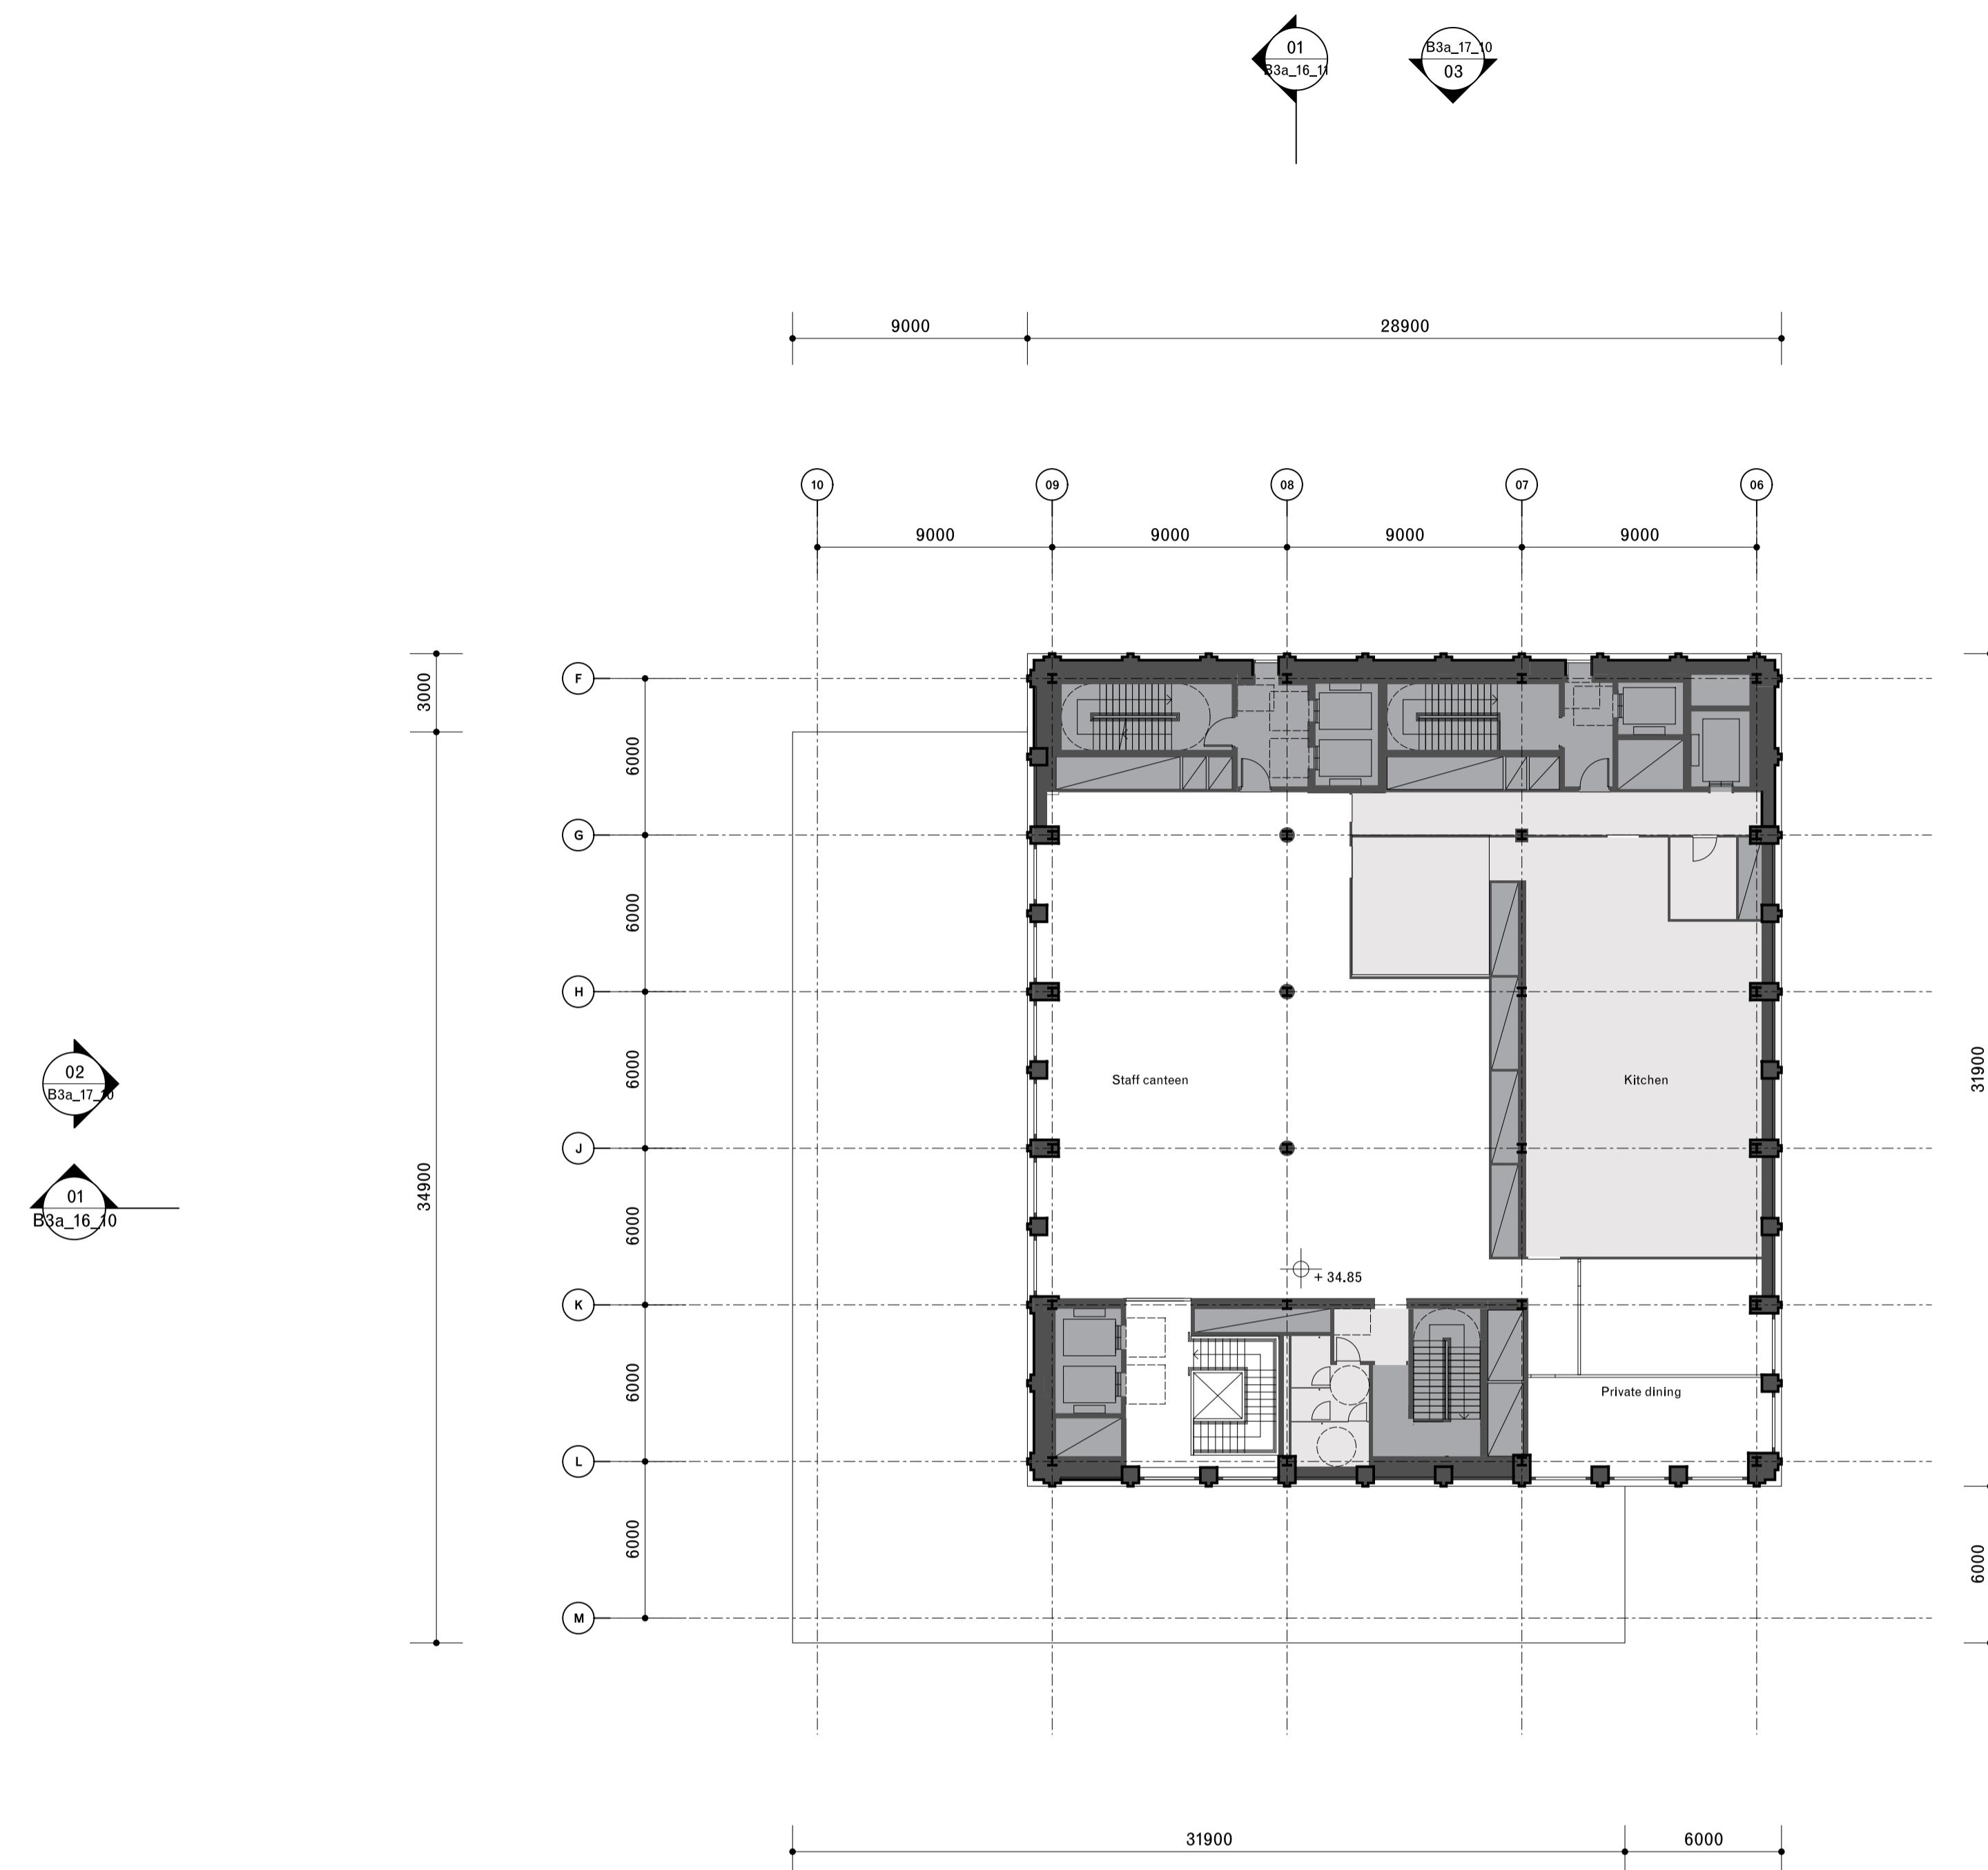


01  
Proposed Fifth Floor Plan  
Scale 1:200

General notes:  
Do not scale from drawings.  
Errors to be reported immediately to the Architect.  
To be read in conjunction with all relevant Architects',  
Services and Structural Engineers' drawings.  
All existing site, tree and building information has been compiled  
from different sources.  
All dimensions to be checked on site.

■ Existing  
■ Proposed

01 20/08/2025 Planning (addendum 3) MY GLa  
Rev. Date Description Drawn Check

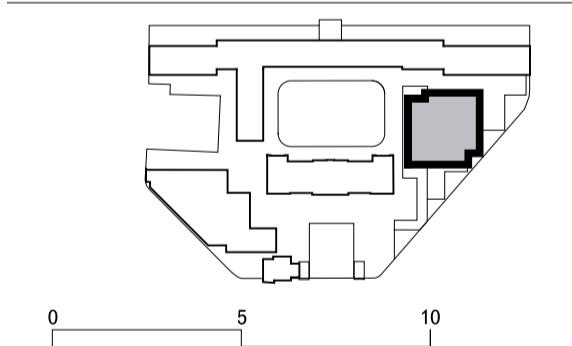

David Chipperfield Architects

C/O Fora, 9 Dillington Street  
London EC1V 8LW  
T +44 20 7829 4800  
www.davidchipperfield.com

Project Royal Mint Court  
Project number 1510


Client Chinese Embassy in the UK

© David Chipperfield Architects Ltd.

Planning (addendum)

Drawing name Proposed fifth floor plan  
Cultural Exchange building B3a\_11\_15

Date	16/05/2024	Revision	01
Scale / Format	1:200 / A1	Drawn / Checked	JPa / GLa / OU
Approved	BB	CAD Reference	1510_A_B3A_11_15.dgn

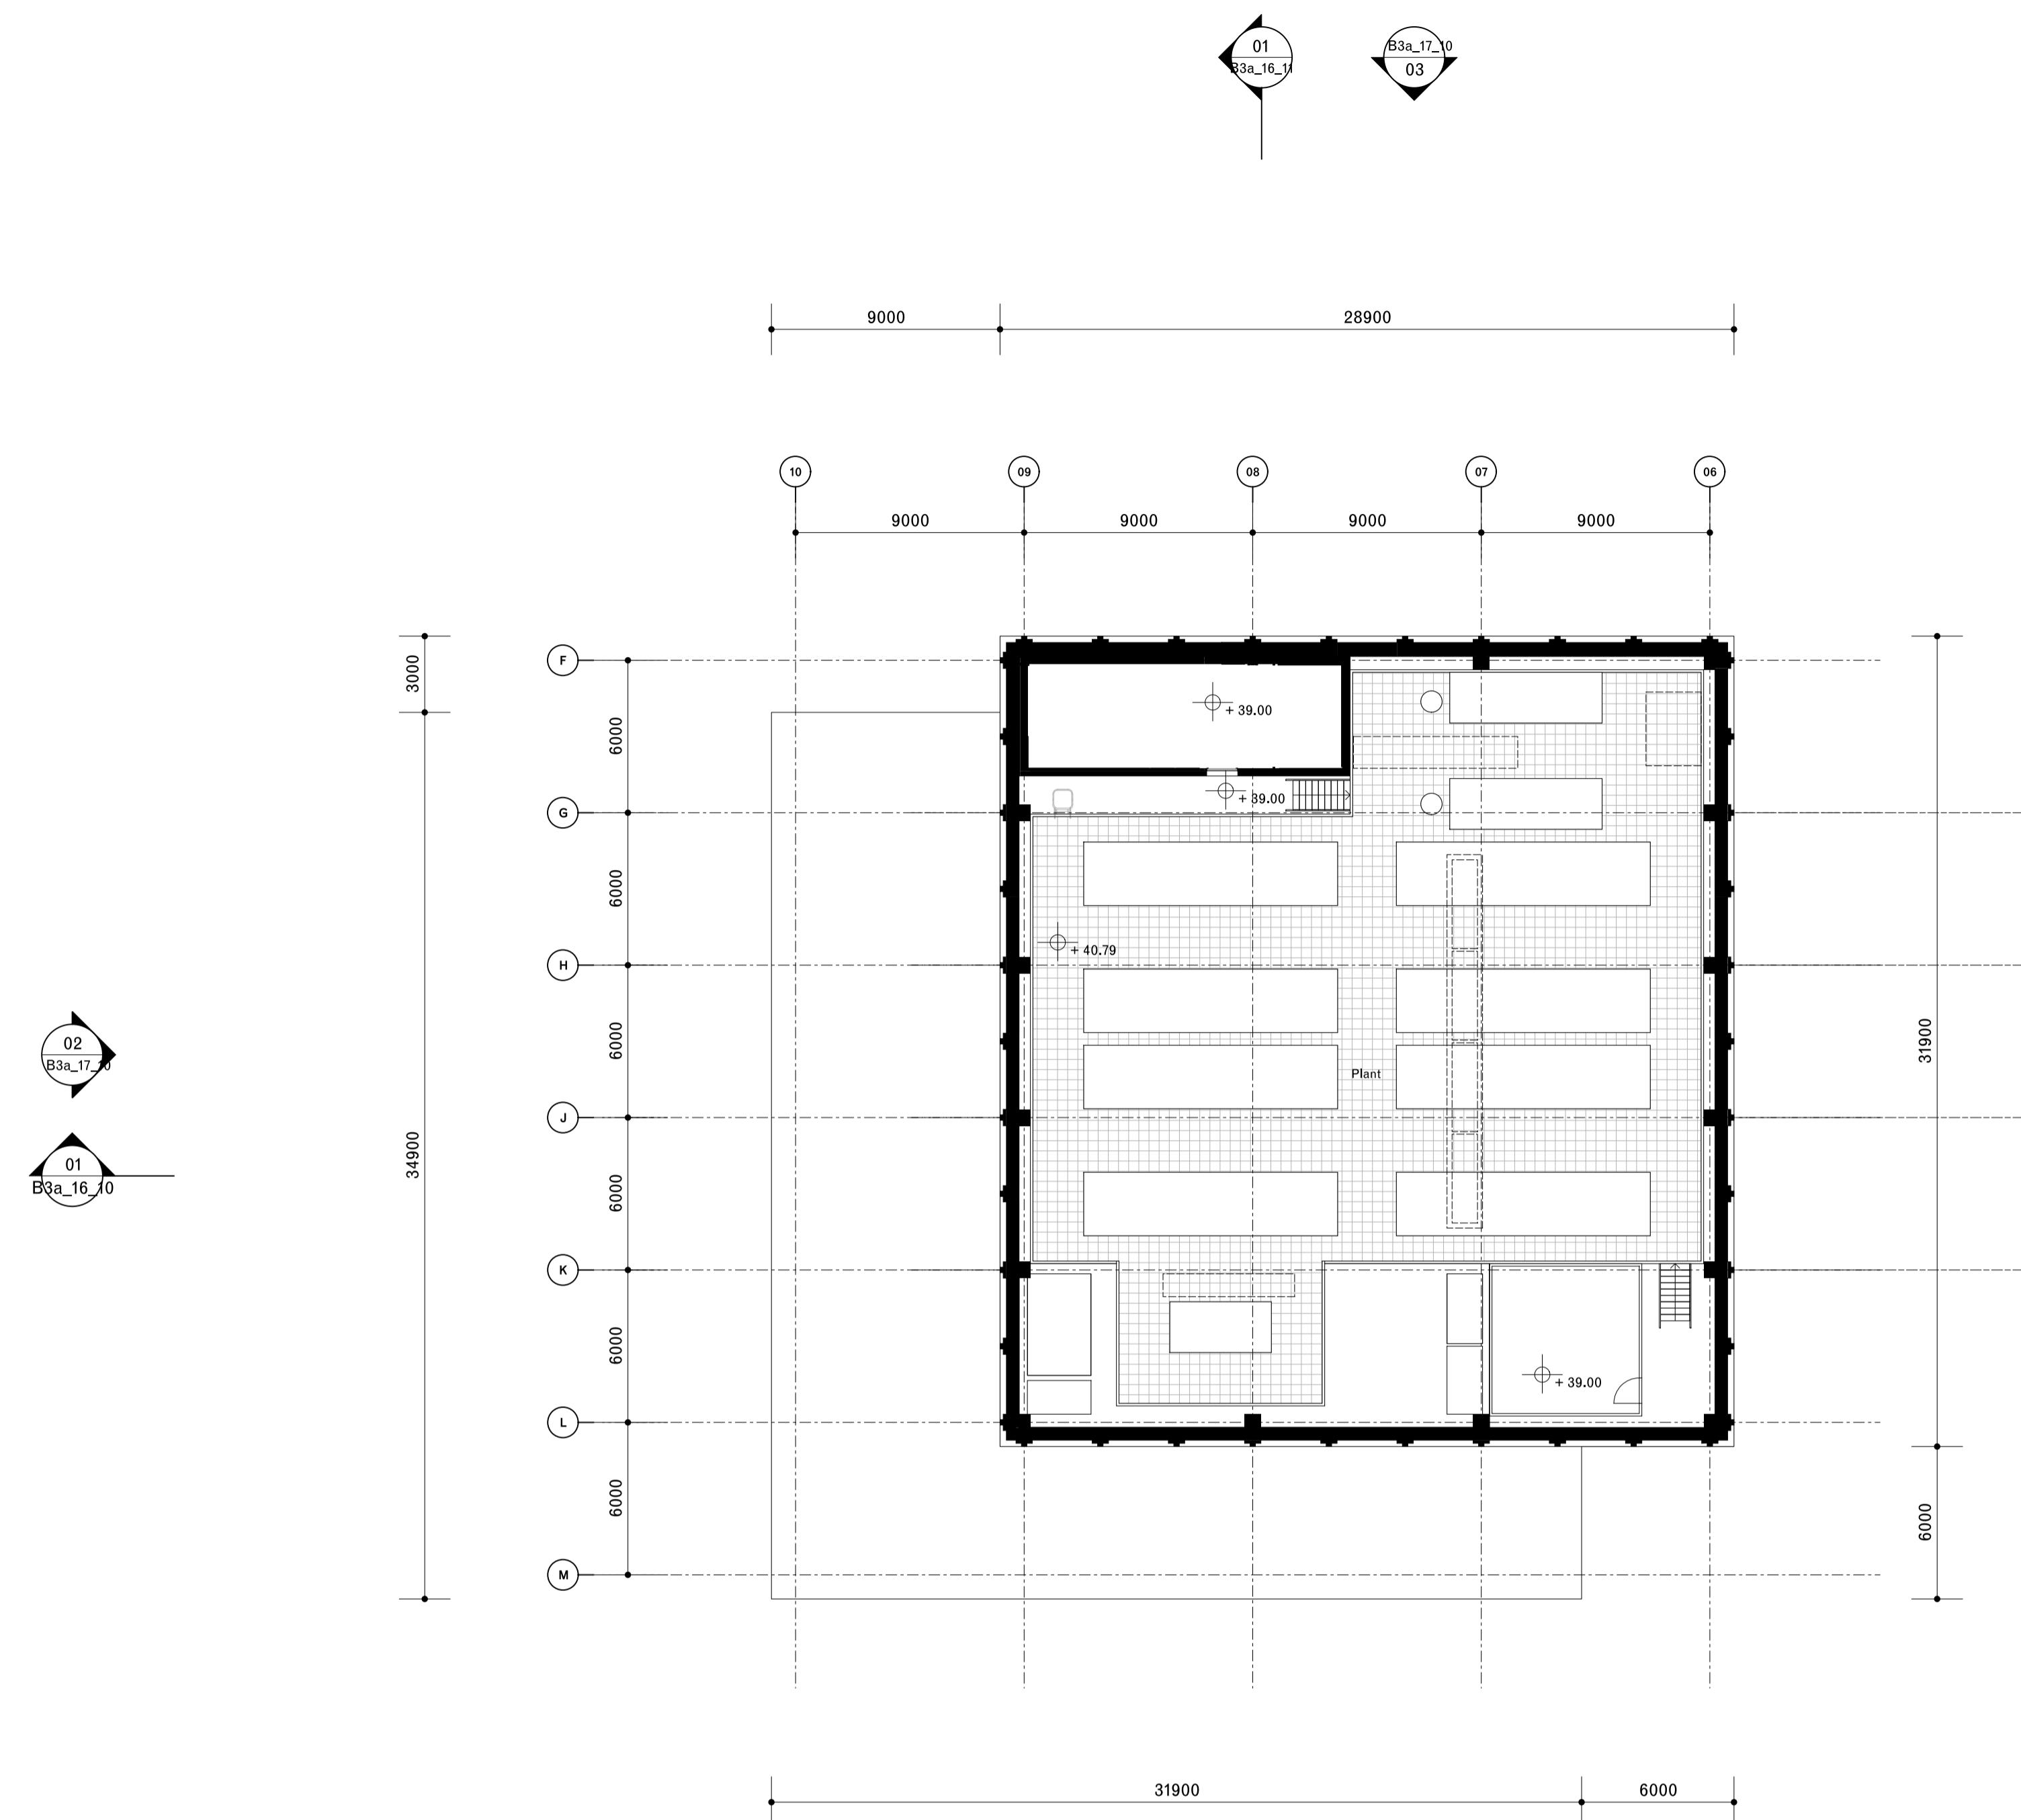

---

David Chipperfield Architects

C/O Fora, 9 Dallington Street  
London EC1V 0LN  
T +44 20 7620 4800  
[www.davidchipperfield.com](http://www.davidchipperfield.com)

---

## Client

© David Chipperfield Architects

erfield Architects Ltd.

---

---

Drawing number

## Proposed sixth floor plan Cultural Exchange building

11\_16

---

Date 16/05/2024 Revision

Revision

Drawn / Checked **JPa / GLa / OU** Planning  
Approved **BB**


## Planning

---

CAD Reference 1510\_A\_B3A\_11\_16.dgn

---

# Proposed Roof Plan

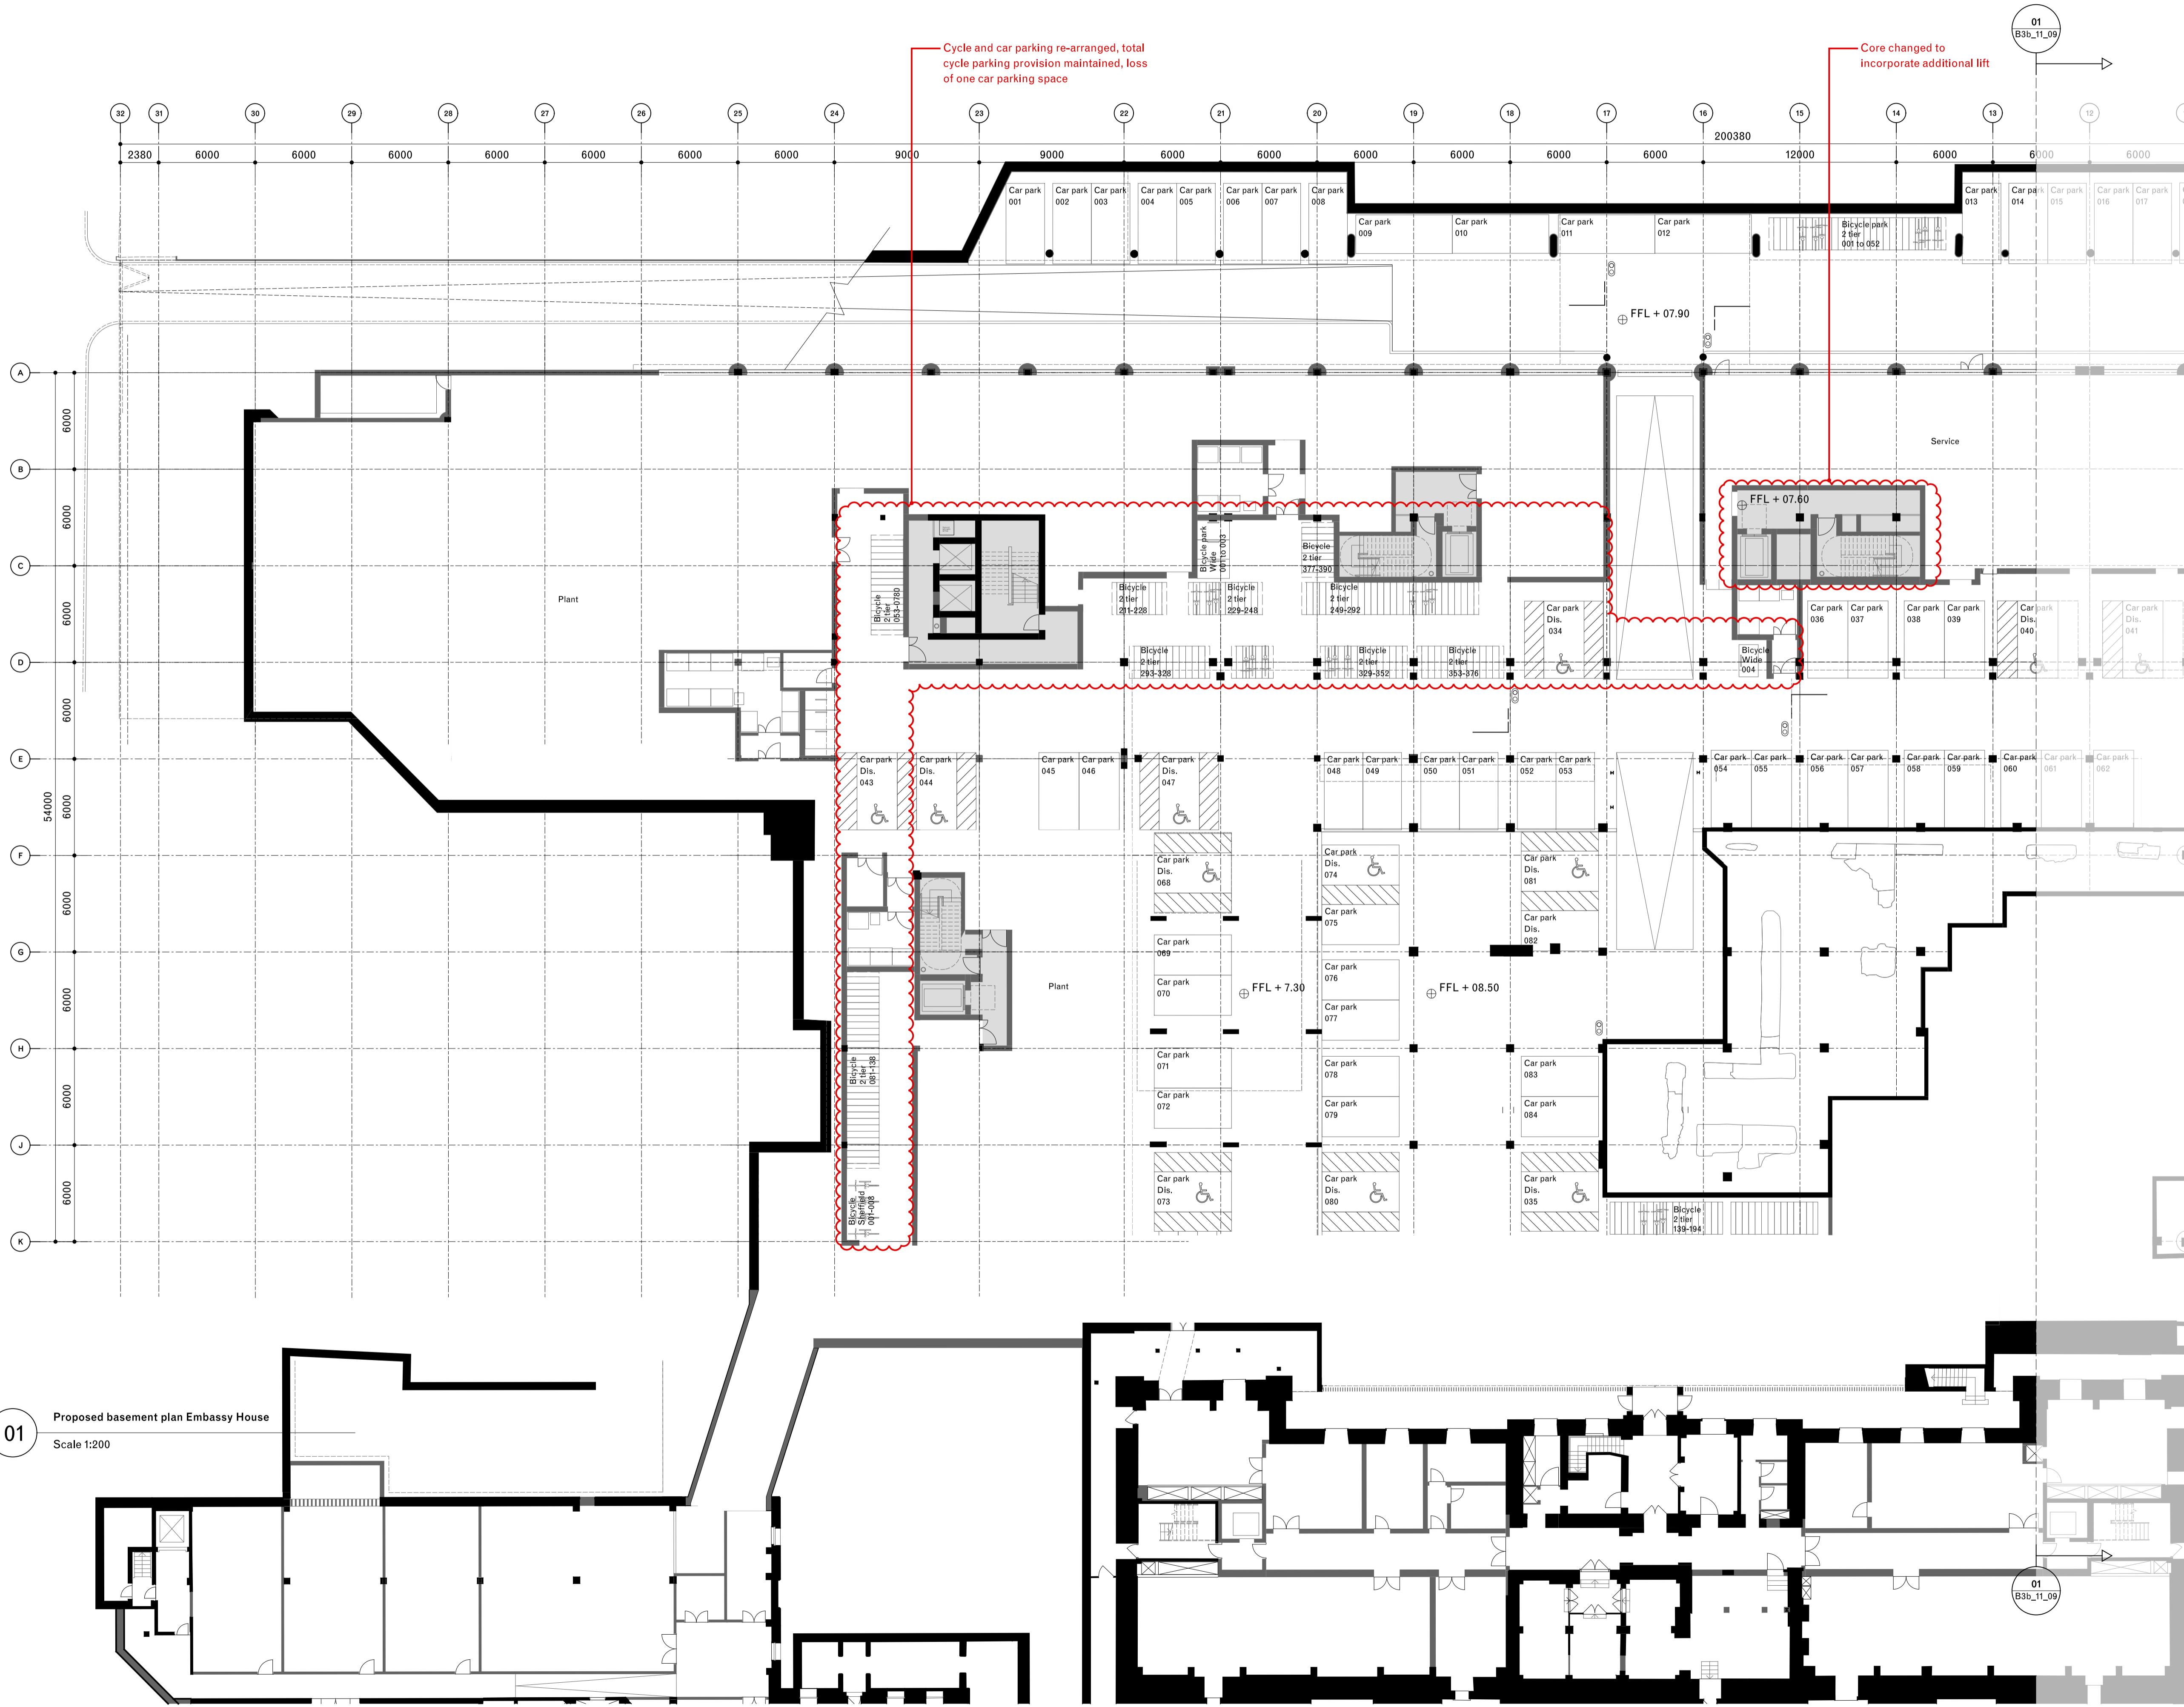

**Note:**  
Red line shows amendments made to the original 2021 application to ensure compliance with updated legislation, including the Building Safety Act 2022 and BS9991:2024, as presented at the Planning Inquiry.

**General notes:**

- Do not scale from drawings.
- Errors to be reported immediately to the Architect.
- To be read in conjunction with all relevant Architects', Services and Structural Engineers' drawings.
- All existing site, tree and building information has been compiled from different sources.
- All dimensions to be checked on site.

02	20/08/2025	Planning (addendum 3)	MY	GLa
01	15/11/2024	Planning (addendum)	YZ	GLa
Rev.	Date	Description	Drawn	Checked

David Chipperfield Architects

C/O Fora, 9 Dallington Street  
London EC1V 0LN  
T +44 20 7620 4800  
[www.davidchipperfield.com](http://www.davidchipperfield.com)

Project	Project number
<b>Royal Mint Court</b>	<b>1510</b>

---

Client


## Planning (addendum)

Drawing name Drawing number

Embassy House  
North, sheet 1 of 2

Date 16/05/2024 Revision  
Scale / Format 1:200 / A1 02

Approved **BB**  
CAD Reference 1510\_A\_B3b\_11\_08.dgn

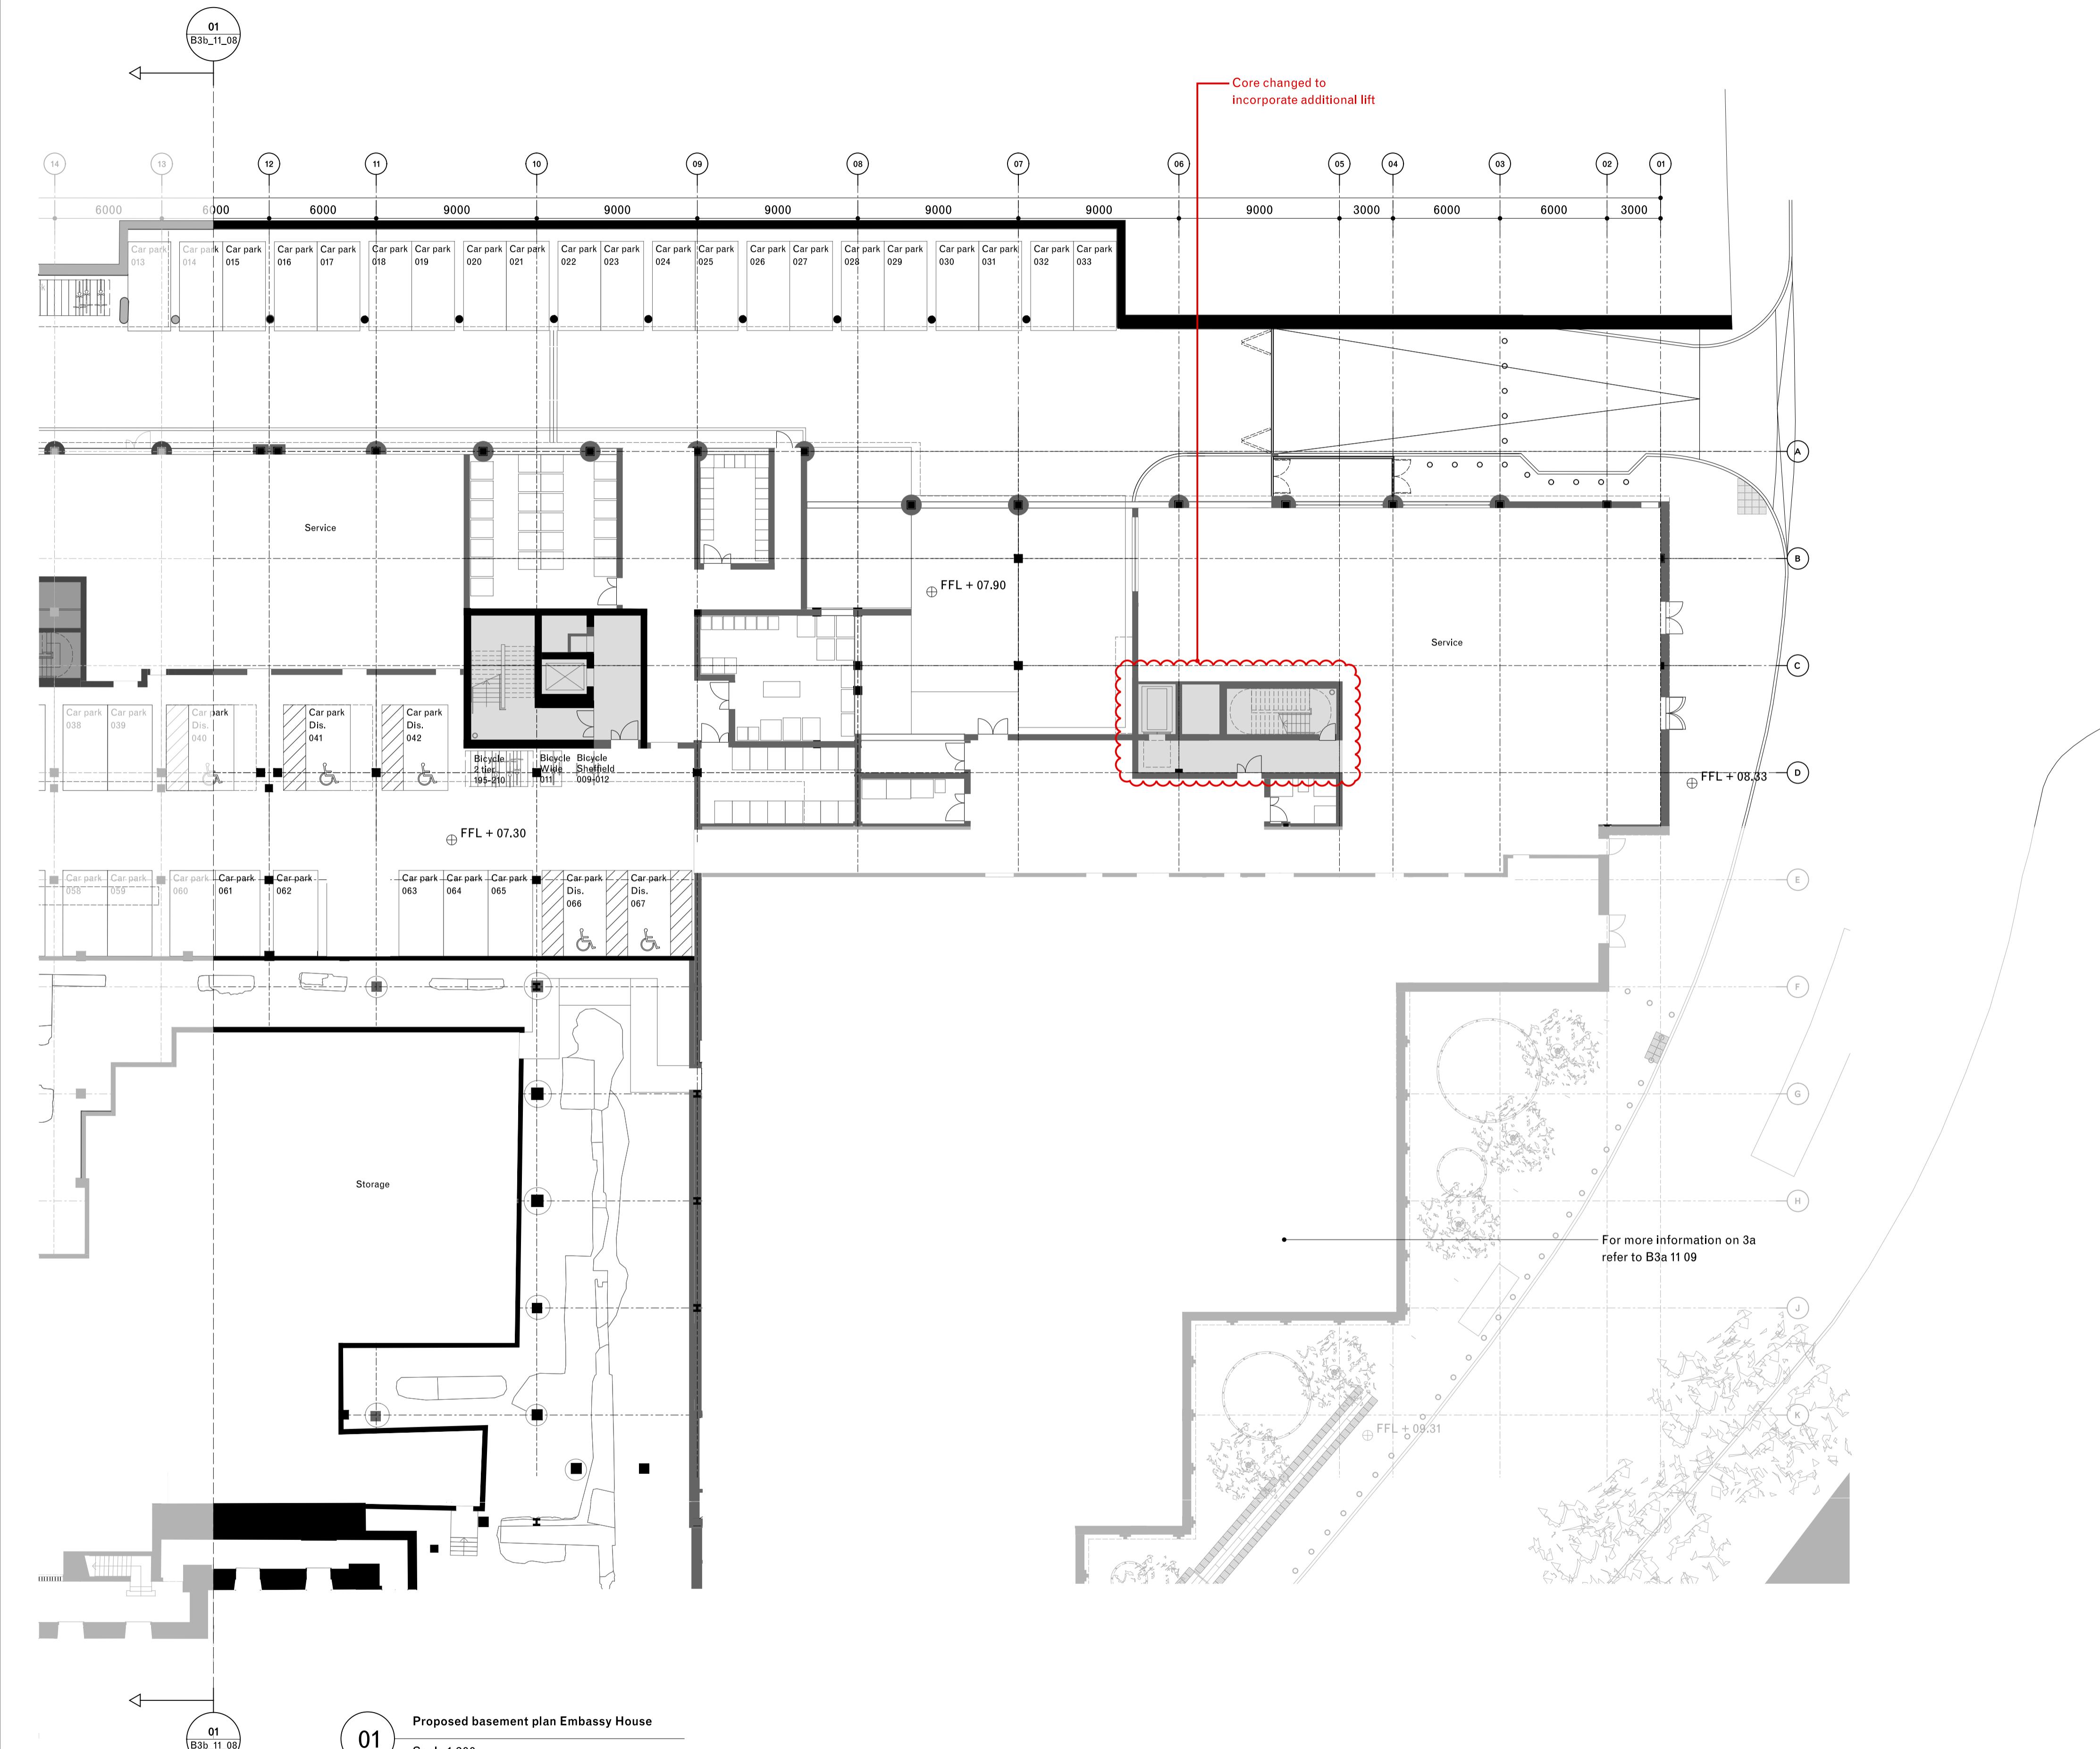


Note:  
Red line shows amendments made to the original 2021 application to ensure compliance with updated legislation, including the Building Safety Act 2022 and BS9991:2024, as presented at the Planning Inquiry.

General notes:  
Do not scale from drawings.  
Errors to be reported immediately to the Architect.  
To be read in conjunction with all relevant Architects',  
Services and Structural Engineers' drawings.  
All existing site, tree and building information has been compiled  
from different sources.  
All dimensions to be checked on site.

Existing Proposed

02 20/08/2025 Planning (addendum 3) MY GLA  
01 15/11/2024 Planning (addendum) YZ GLA  
Rev. Date Description Drawn Check

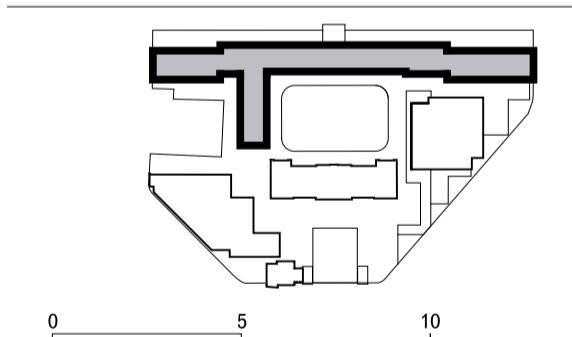

David Chipperfield Architects

C/O Fora, 9 Dillington Street  
London EC1W 8LY  
T +44 20 7829 4800  
www.davidchipperfield.com

Project Royal Mint Court  
Project number 1510

Client Chinese Embassy in the UK


Planning (addendum)  
Drawing name Proposed basement plan  
Drawing number Embassy House

South, sheet 2 of 2

Date 16/05/2024  
Scale / Format 1:200 / A1  
Drawn / Checked RPI / OU, GLA  
Approved BB  
CAD Reference 1510\_A\_B3b\_11\_09.dgn

02


Planning

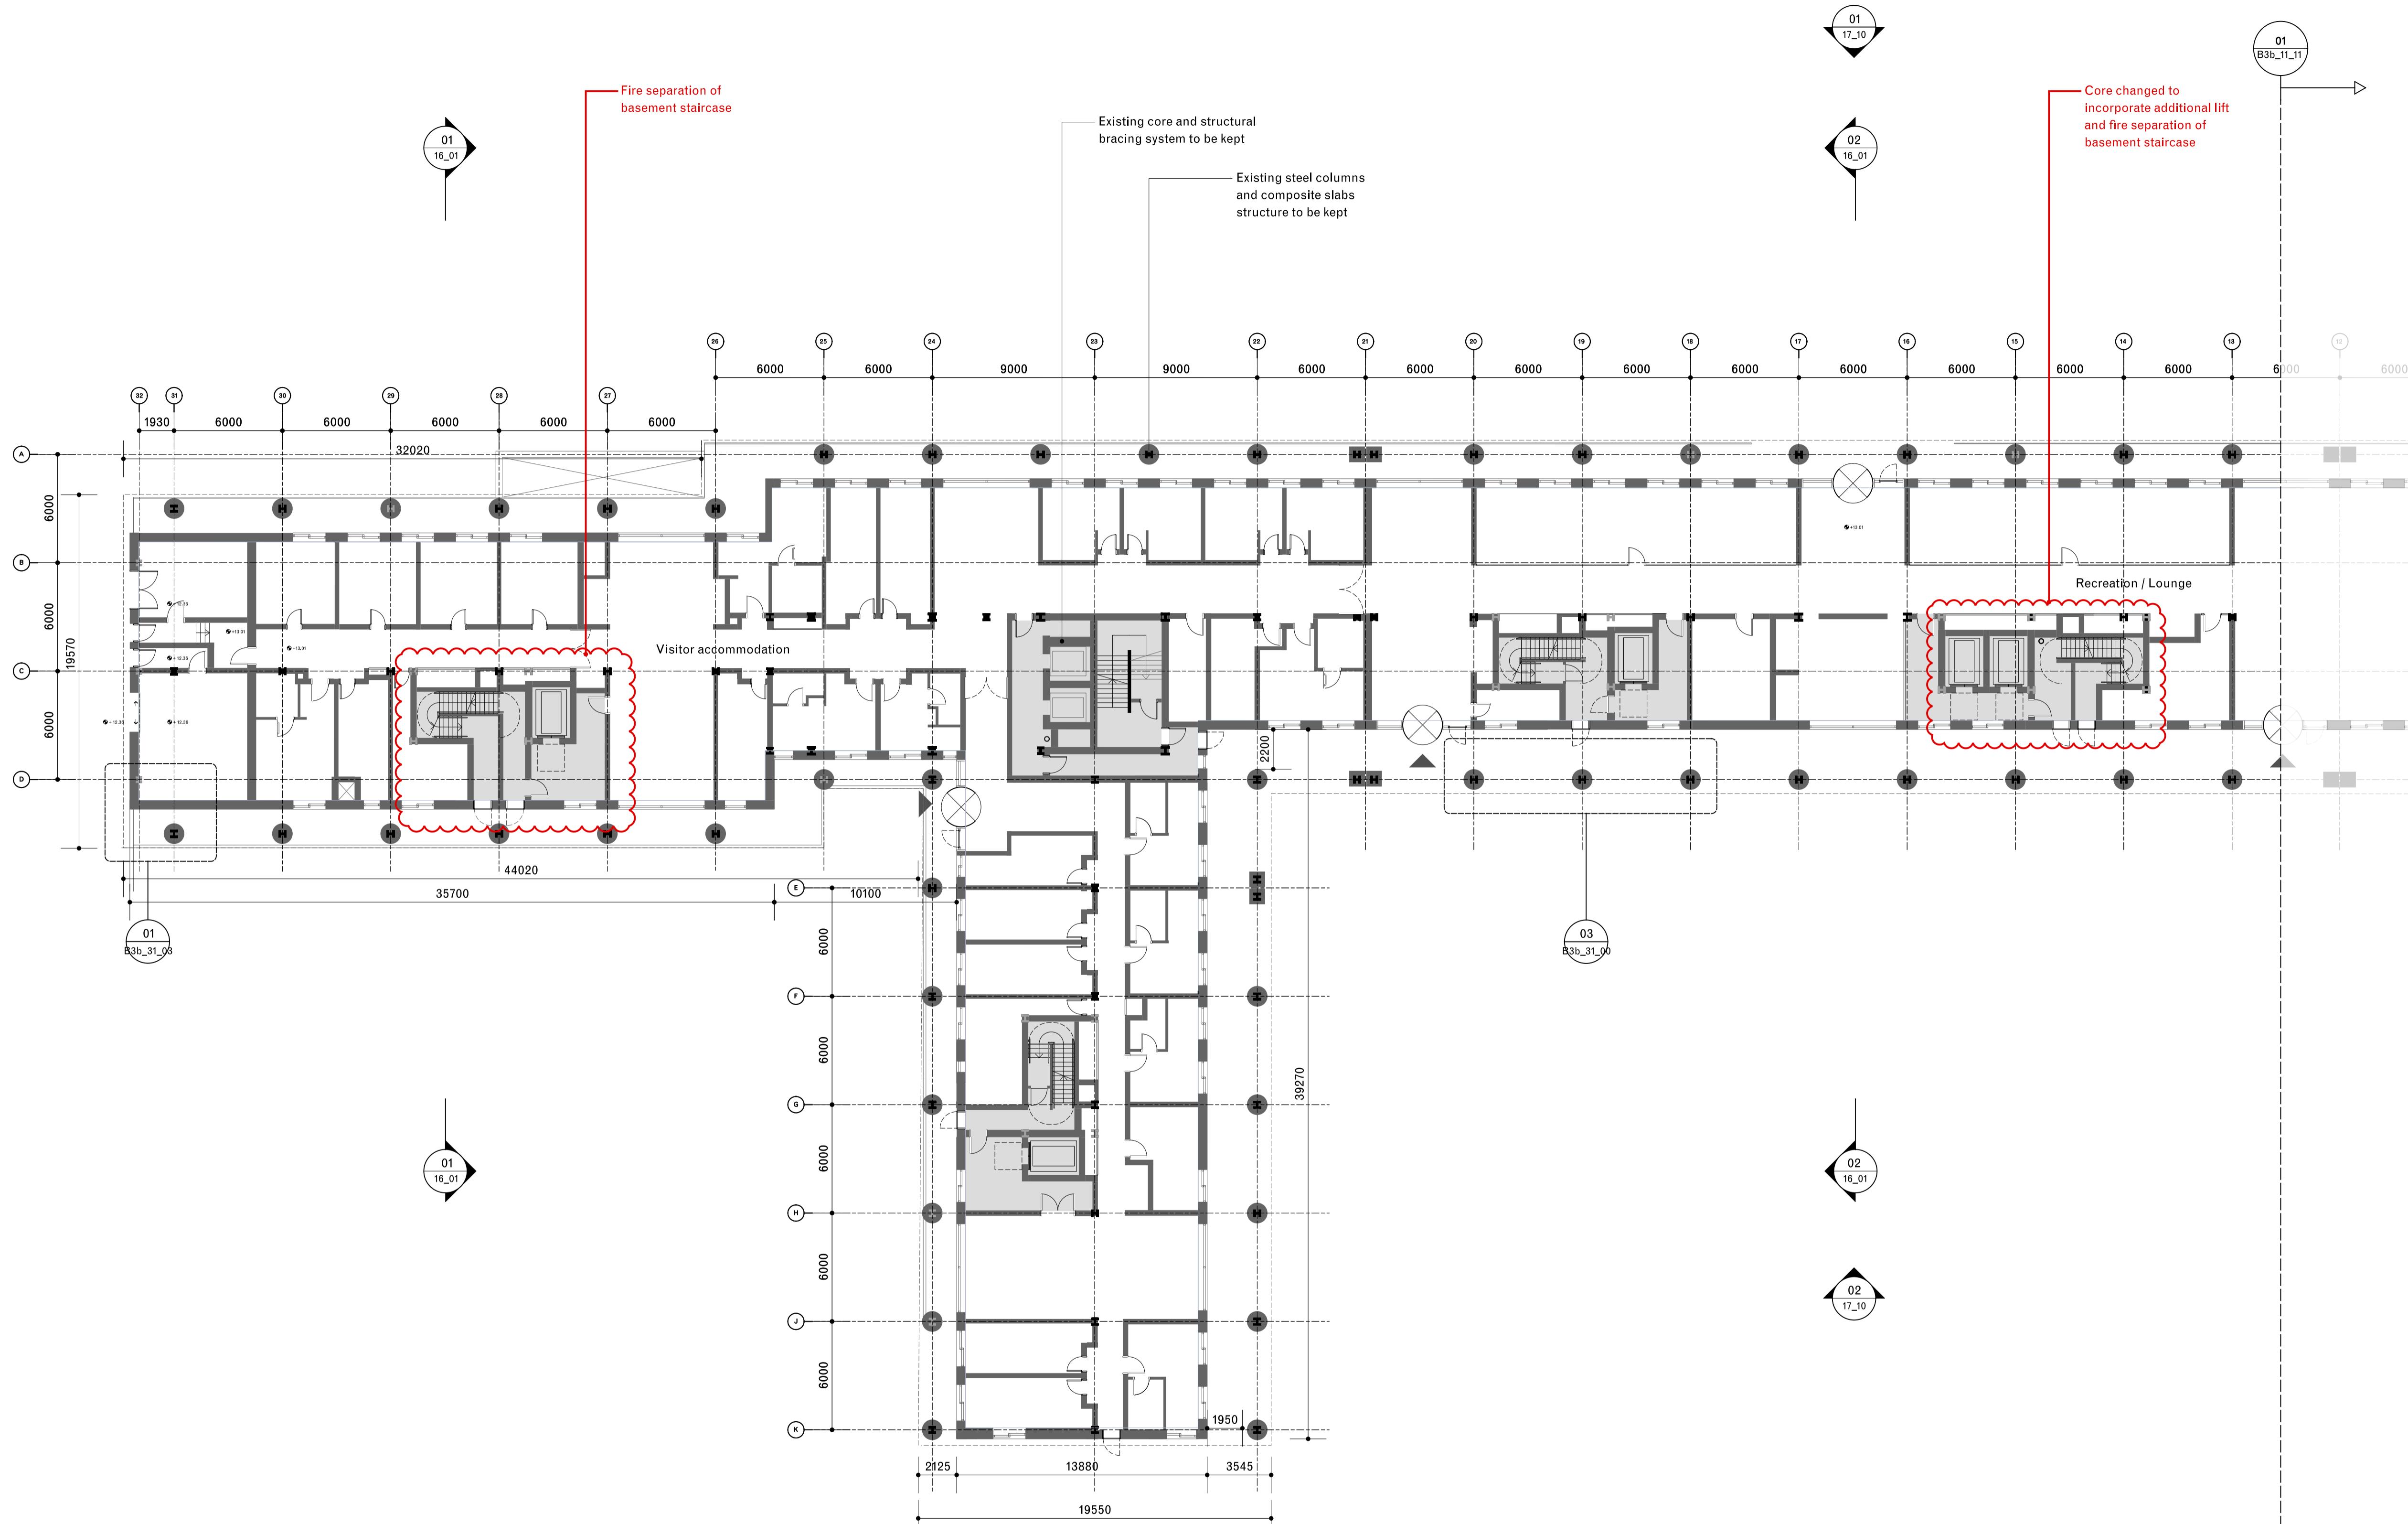

Note:  
Red line shows amendments made to the original 2021 application to ensure compliance with updated legislation, including the Building Safety Act 2022 and BS9991:2024, as presented at the Planning Inquiry.

General notes:  
Do not scale from drawings.  
Errors to be reported immediately to the Architect.  
To be read in conjunction with all relevant Architects', Services and Structural Engineers' drawings.  
All existing site, tree and building information has been compiled from different sources.  
All dimensions to be checked on site.

02 20/08/2025 Planning (addendum 3) MY GLa  
01 15/11/2024 Planning (addendum) YZ GLa  
Rev. Date Description Drawn Check

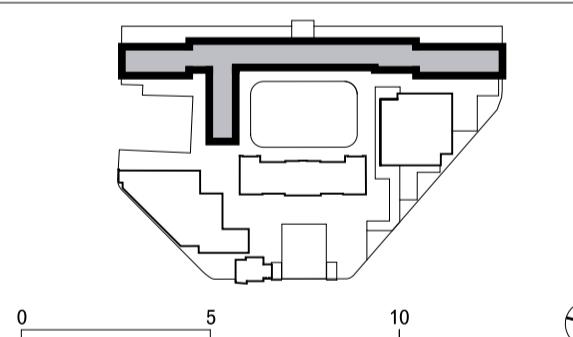

David Chipperfield Architects

C/O Fora, 9 Dillington Street  
London EC1V 8LW  
T +44 20 7829 4800  
www.davidchipperfield.com

Project Royal Mint Court  
Project number 1510

Client Chinese Embassy in the UK

Planning (addendum)

Drawing name Proposed ground floor plan  
Drawing number B3b\_11\_10

Date 16/05/2024  
Scale / Format 1:200 / A1  
Drawn / Checked BB  
Approved  
CAD Reference 1510\_A\_B3b\_1\_10.dgn

Revision 02  
Planning




**Note:**  
Red line shows amendments made to the original 2021 application to ensure compliance with updated legislation, including the Building Safety Act 2022 and BS9991:2024, as presented at the Planning Inquiry.

General notes:

- Do not scale from drawings.
- Errors to be reported immediately to the Architect.
- To be read in conjunction with all relevant Architects', Services and Structural Engineers' drawings.
- All existing site, tree and building information has been compiled from different sources.
- All dimensions to be checked on site.

The legend consists of four entries: 'Existing' with a black square, 'Proposed' with a grey square, 'Retained column' with a black square containing a white 'H', and 'New column' with a grey square containing a white 'H'.

02	20/08/2025	Planning (addendum 3)	MY	GLa
01	15/11/2024	Planning (addendum)	YZ	GLa

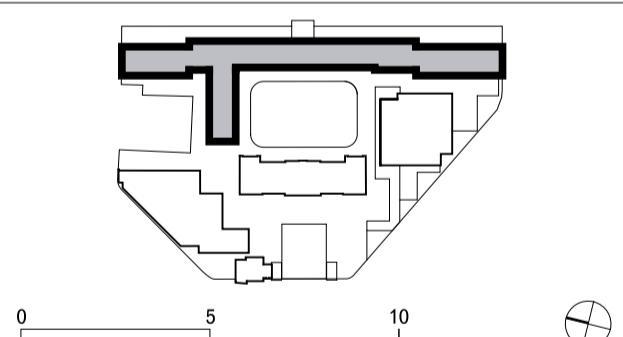

David Chipperfield Architects

C/O Fora, 9 Dallington Street  
London EC1V 0LN  
T +44 20 7620 4800  
[www.davidchipperfield.com](http://www.davidchipperfield.com)

# Project P **Royal Mint Court**

---


Client

# Planning (addendum)

Drawing name	Drawing number
<b>Proposed ground floor plan Embassy House South, sheet 2 of 2</b>	<b>B3b_11_</b>

---

Date	16/05/2024	Revision
Scale / Format	1:200 / A1	02
Drawn / Checked	THN / GLa	Planning
Approved	BB	
CAD Reference	1510_A_B3b_11_11.dgn	

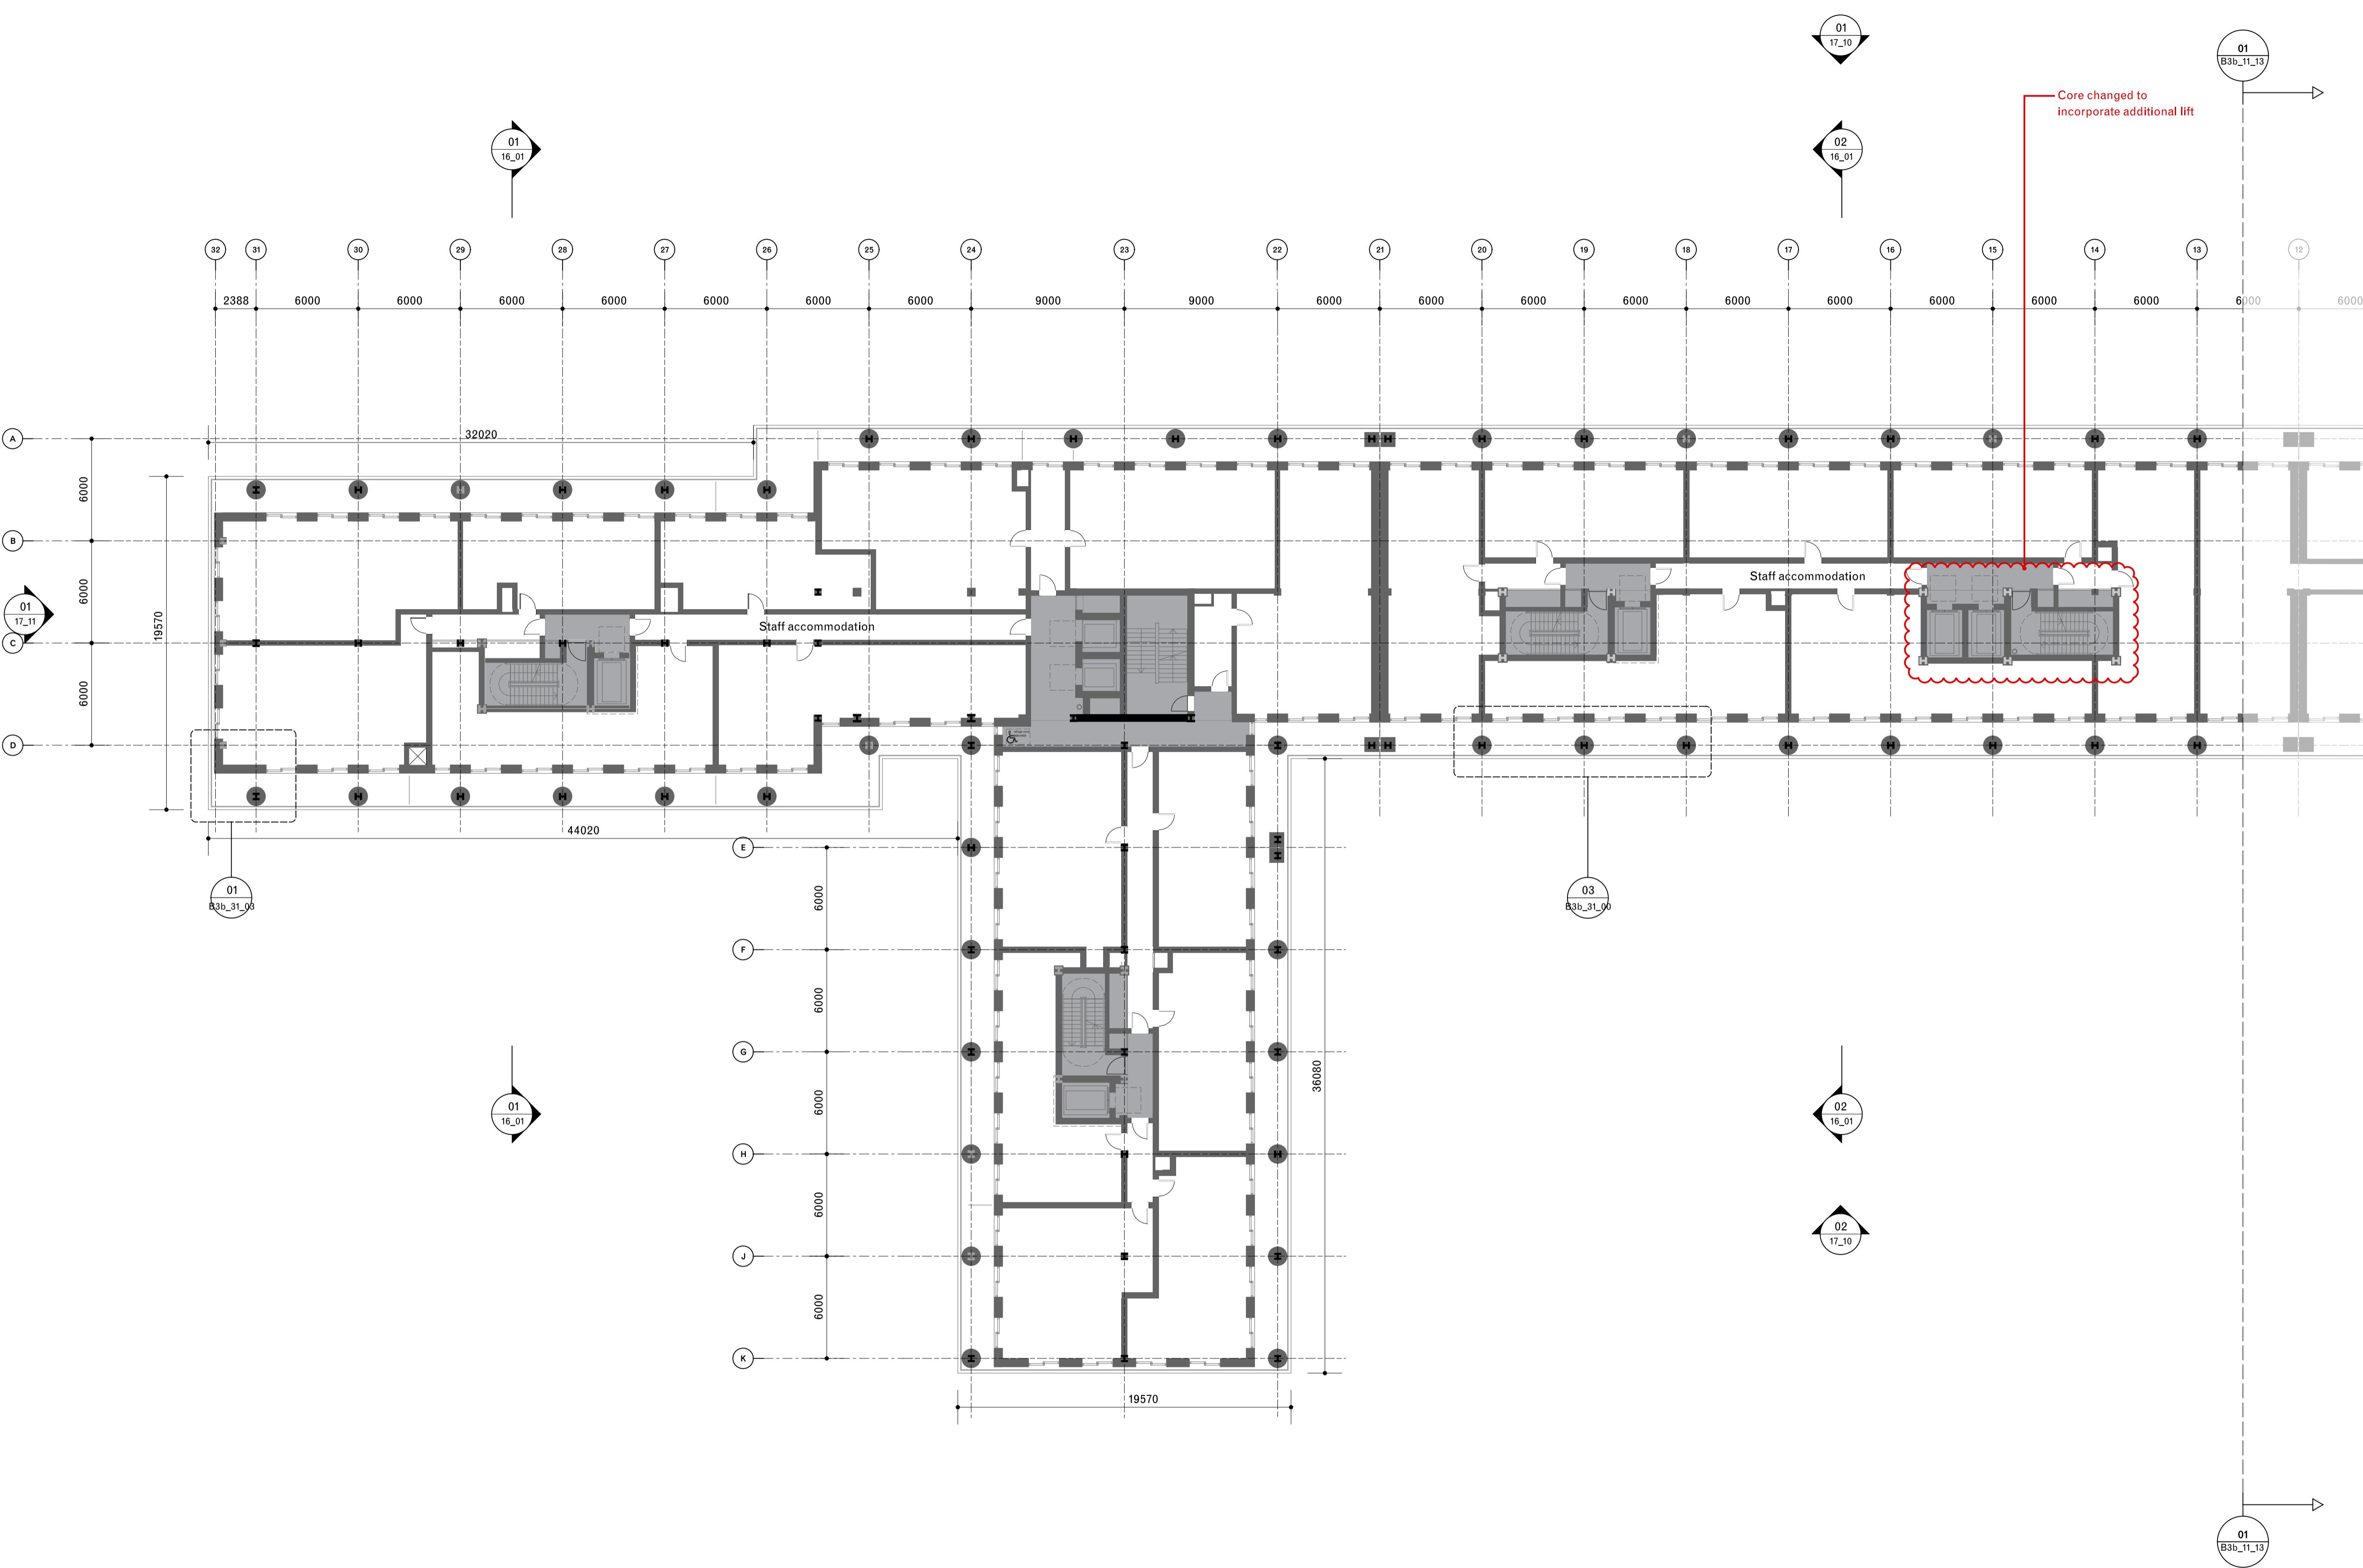


Note:  
Red line shows amendments made to the original 2021 application to ensure compliance with updated legislation, including the Building Safety Act 2022 and BS9991:2024, as presented at the Planning Inquiry.

General notes:  
Do not scale from drawings.  
Errors to be reported immediately to the Architect.  
To be read in conjunction with all relevant Architects', Services and Structural Engineers' drawings.  
All existing site, tree and building information has been compiled from different sources.  
All dimensions to be checked on site.

■ Existing  
■ Proposed  
■ Retained column  
■ New column

02 20/08/2025 Planning (addendum 3) MY GLa  
01 15/11/2024 Planning (addendum) YZ GLa  
Rev. Date Description Drawn Check

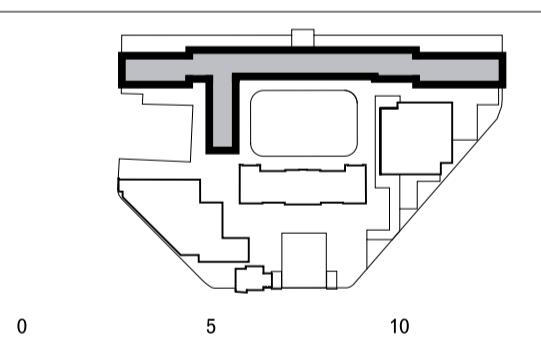

David Chipperfield Architects

C/O Fora, 9 Dillington Street  
London EC1V 8LW  
T +44 20 7829 4800  
www.davidchipperfield.com


Project Royal Mint Court  
Project number 1510

Client Chinese Embassy in the UK

Planning (addendum)  
Drawing name Proposed first floor plan  
Drawing number B3b\_11\_12  
Approved  
CAD Reference 1510\_A\_B3b\_1\_12.dgn

16/05/2024  
1:200 / A1  
THN / OU, GLa  
BB  
Planning  
02

Date Scale / Format Drawn / Checked Approved CAD Reference

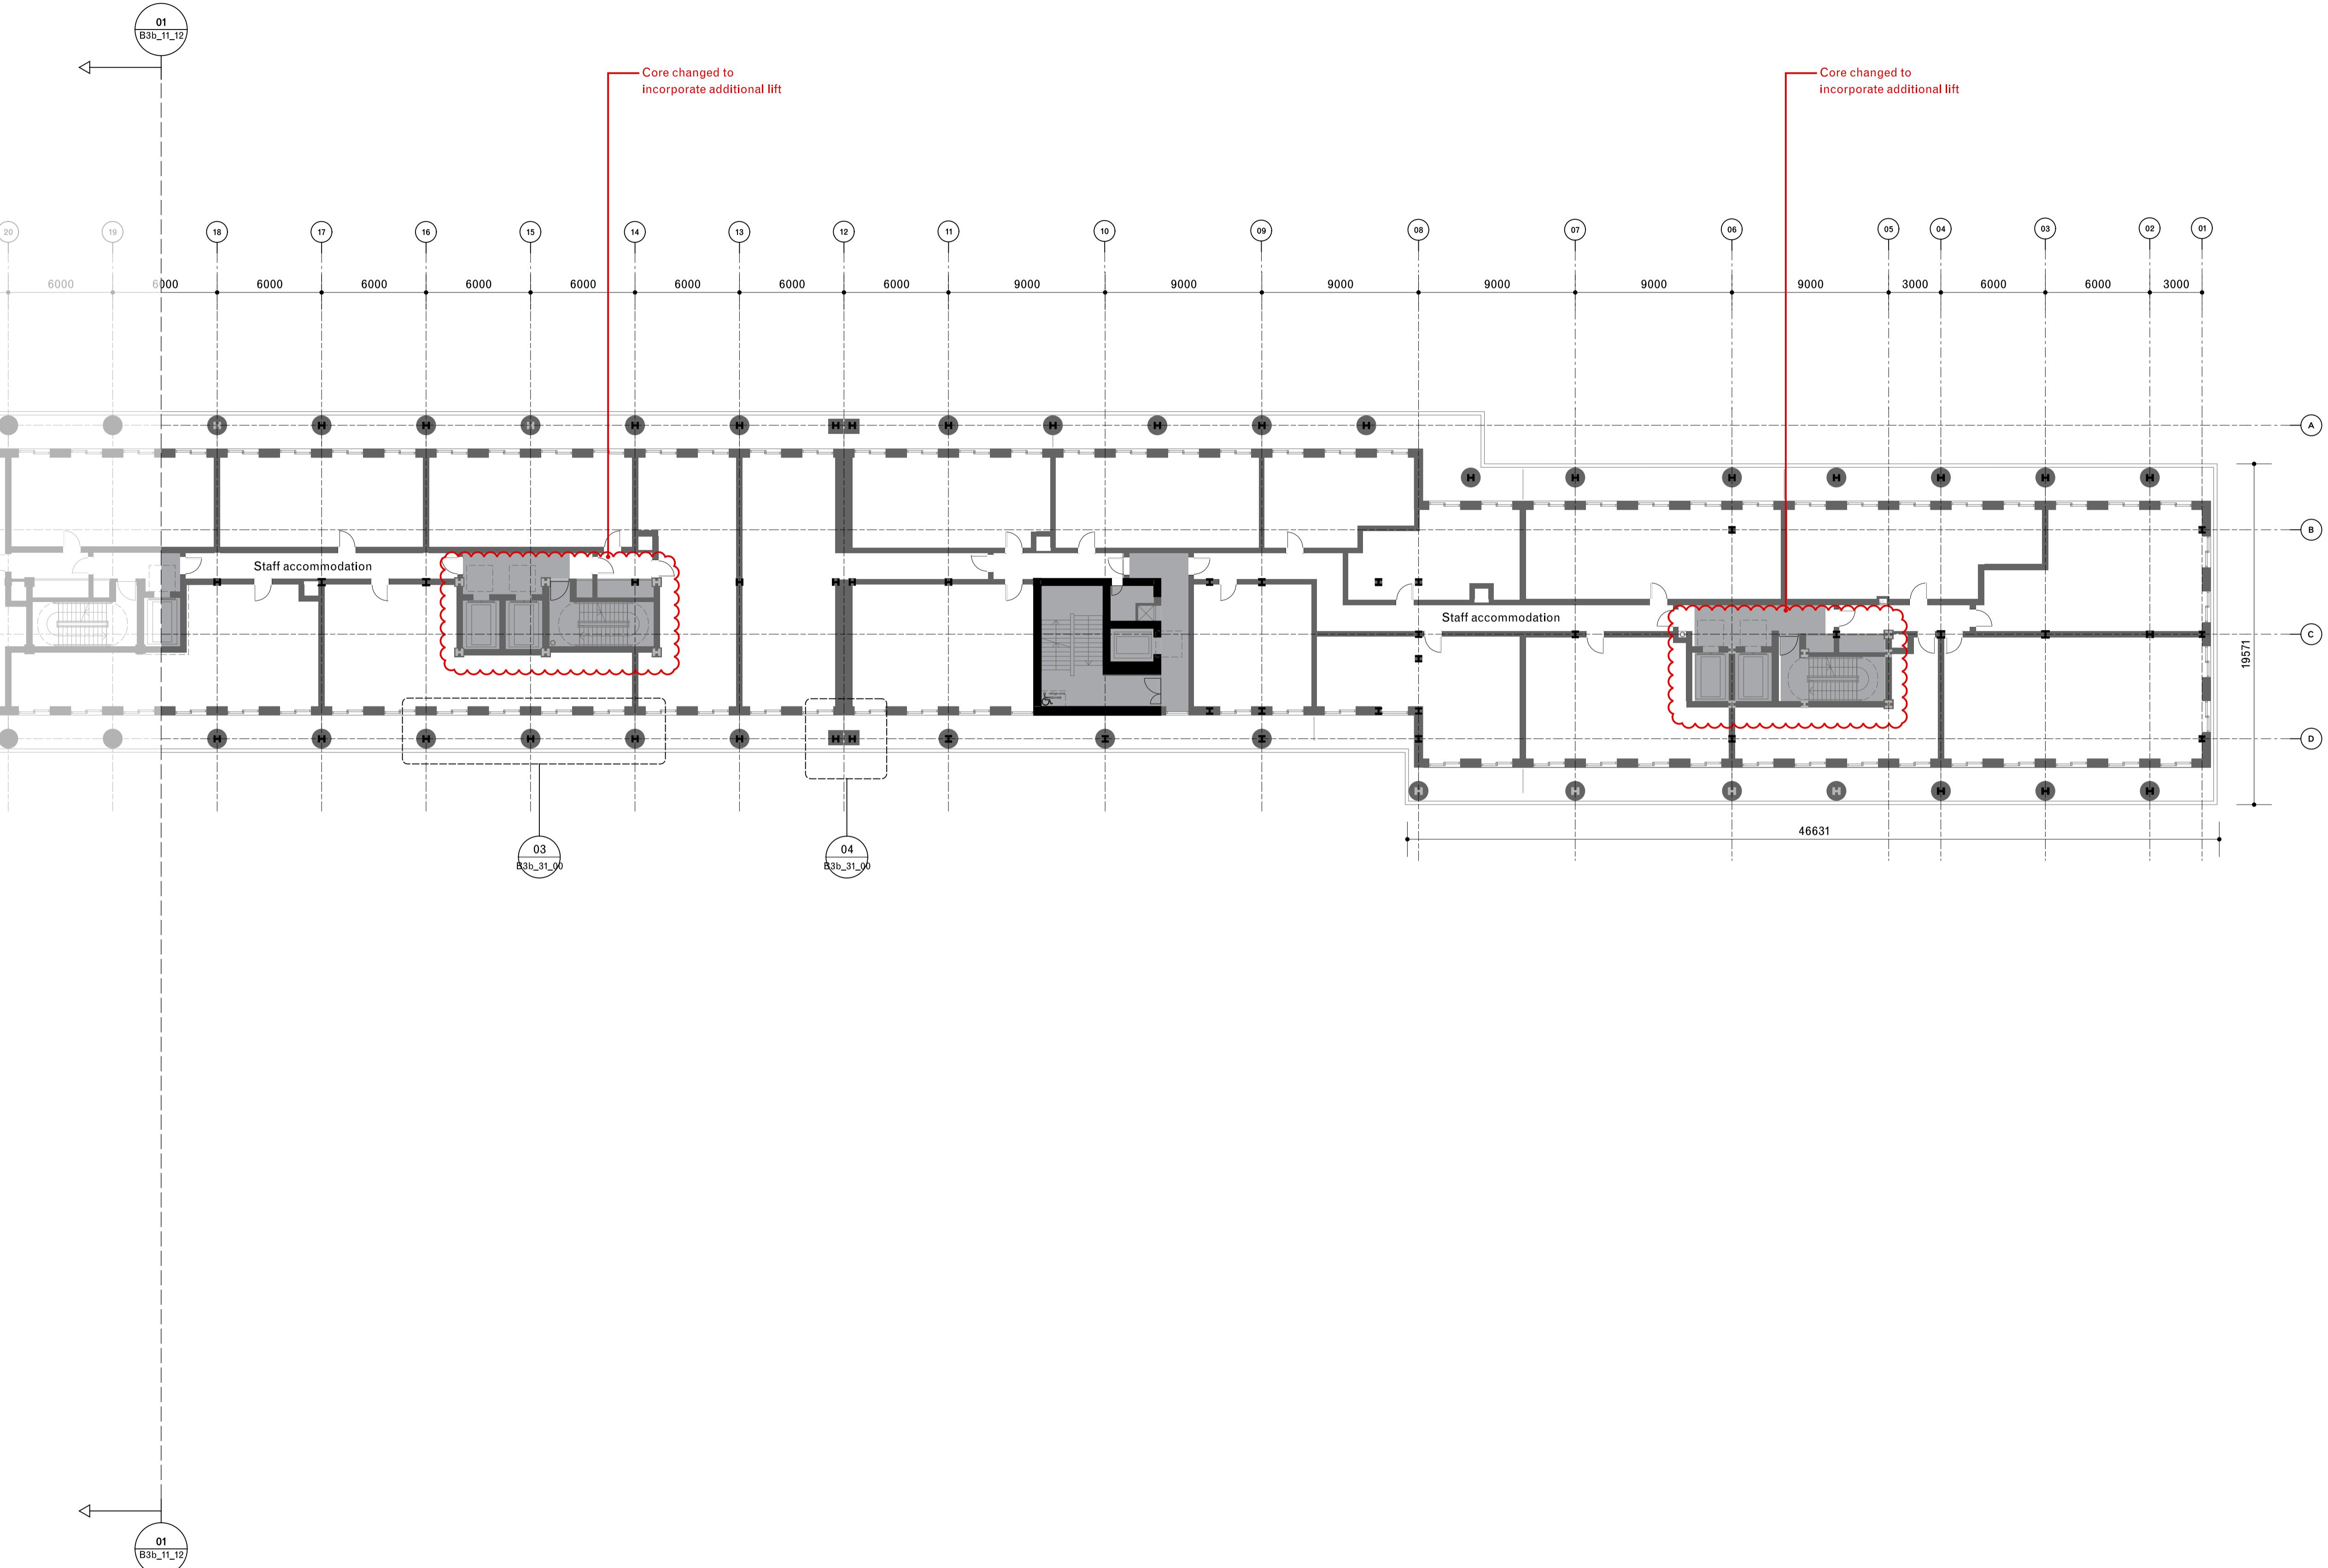

01 Proposed First Floor Plan, South Scale 1:200

© David Chipperfield Architects Ltd.

## Chinese Embassy in the UK

**Project number:**

---




© David Chipperfield Architects

Worfield Architects Ltd.

## Planning (addendum)

ii)


sed first floor plan  
sy House  
sheet 2 of 2

3b\_11\_13

16/05/2024  
1:200 / A1  
THN / OU, GLa  
BB  
1510\_A\_B3b\_11\_13.dgn

## Revision 02 Planning



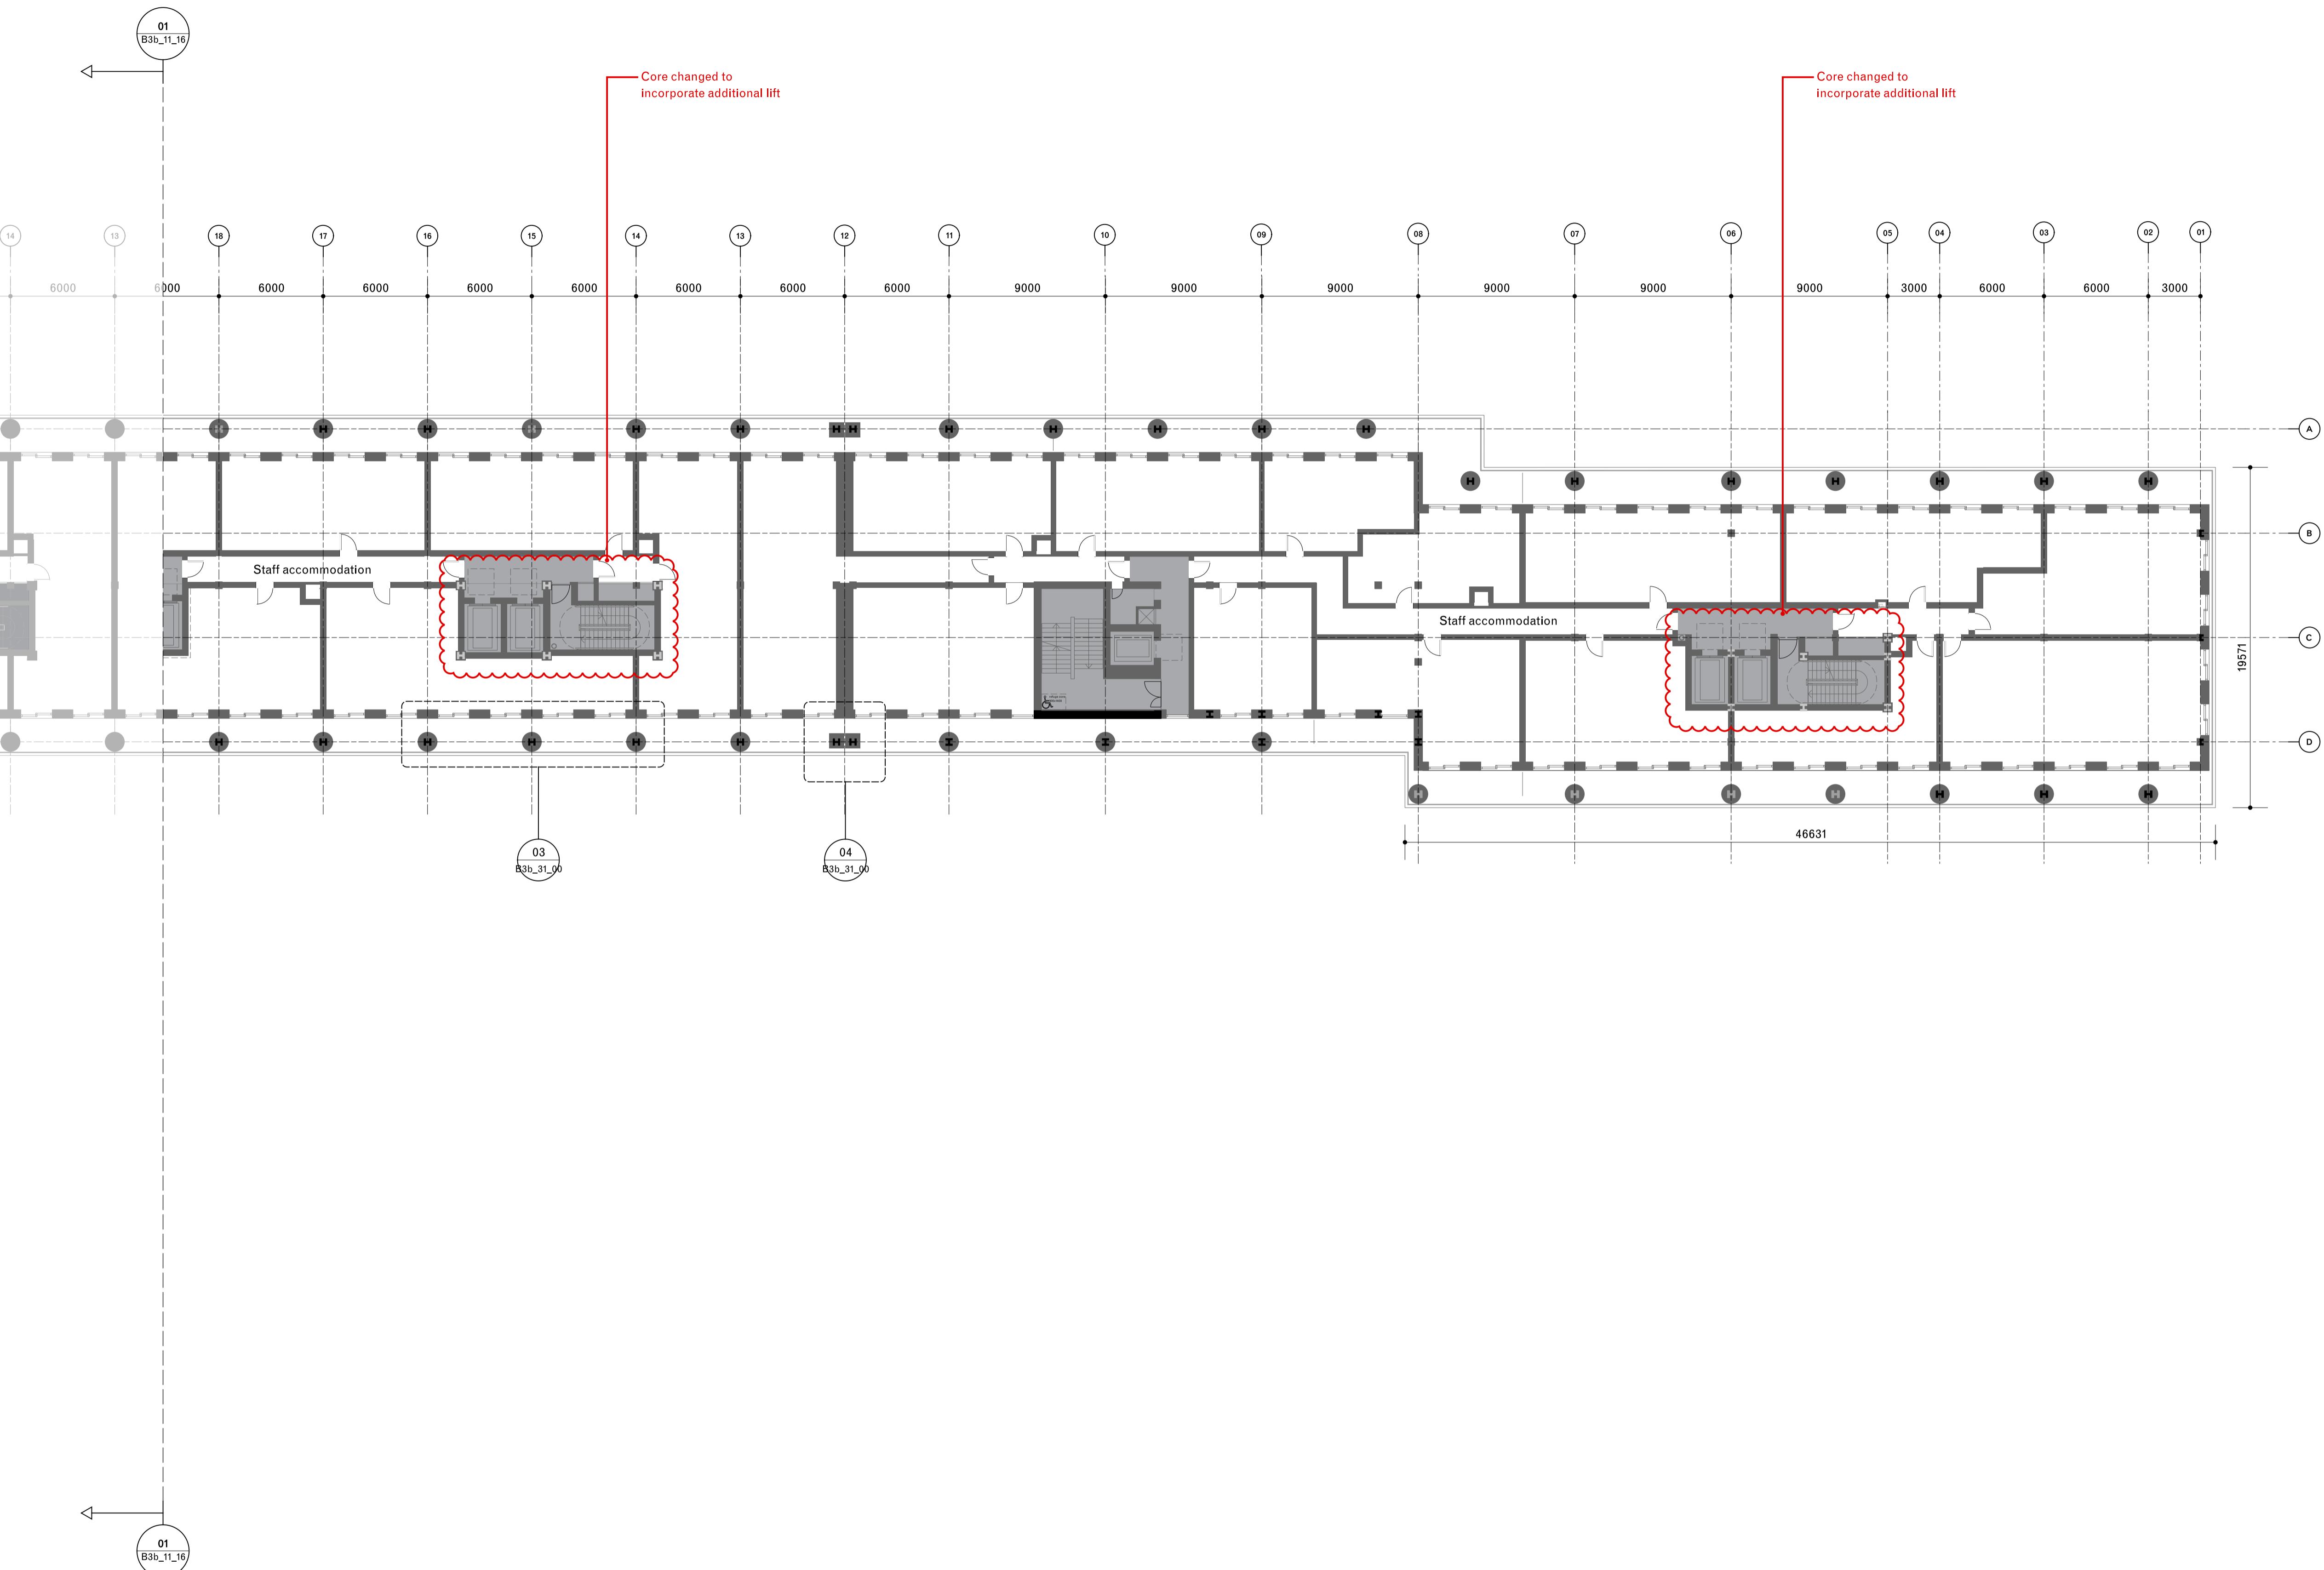


01  
Proposed Second Floor Plan, South  
Scale 1:200

Note:  
Red line shows amendments made to the original 2021 application to ensure compliance with updated legislation, including the Building Safety Act 2022 and BS9991:2024, as presented at the Planning Inquiry.

General notes:  
Do not scale from drawings.  
Errors to be reported immediately to the Architect.  
To be read in conjunction with all relevant Architects', Services and Structural Engineers' drawings.  
All existing site, tree and building information has been compiled from different sources.  
All dimensions to be checked on site.

Existing  
Proposed  
Retained column  
New column

02 20/08/2025 Planning (addendum 3) MY GLa  
01 15/11/2024 Planning (addendum) YZ GLa  
Rev. Date Description Drawn Check

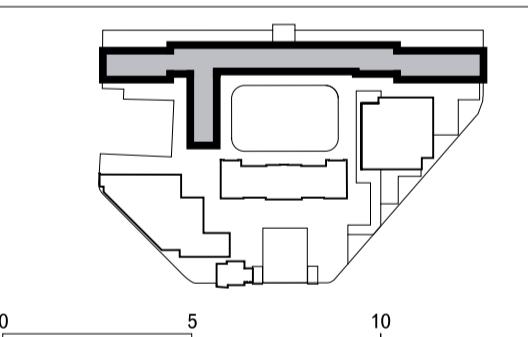

David Chipperfield Architects

C/O Fora, 9 Dillington Street  
London EC1V 8LW  
T +44 20 7829 4800  
www.davidchipperfield.com

Project Royal Mint Court  
Project number 1510

Client Chinese Embassy in the UK

© David Chipperfield Architects Ltd.

Planning (addendum)


Drawing name Drawing number

Proposed second floor plan  
Embassy House  
South, sheet 2 of 2

B3b\_11\_15

Date 16/05/2024  
Scale / Format 1:200 / A1  
Drawn / Checked THN / OU, GLa  
Approved BB  
CAD Reference 1510\_A\_B3b\_1\_15.dgn  
Revision 02  
Planning

01 Proposed Third Floor Plan, North  
Scale 1:200

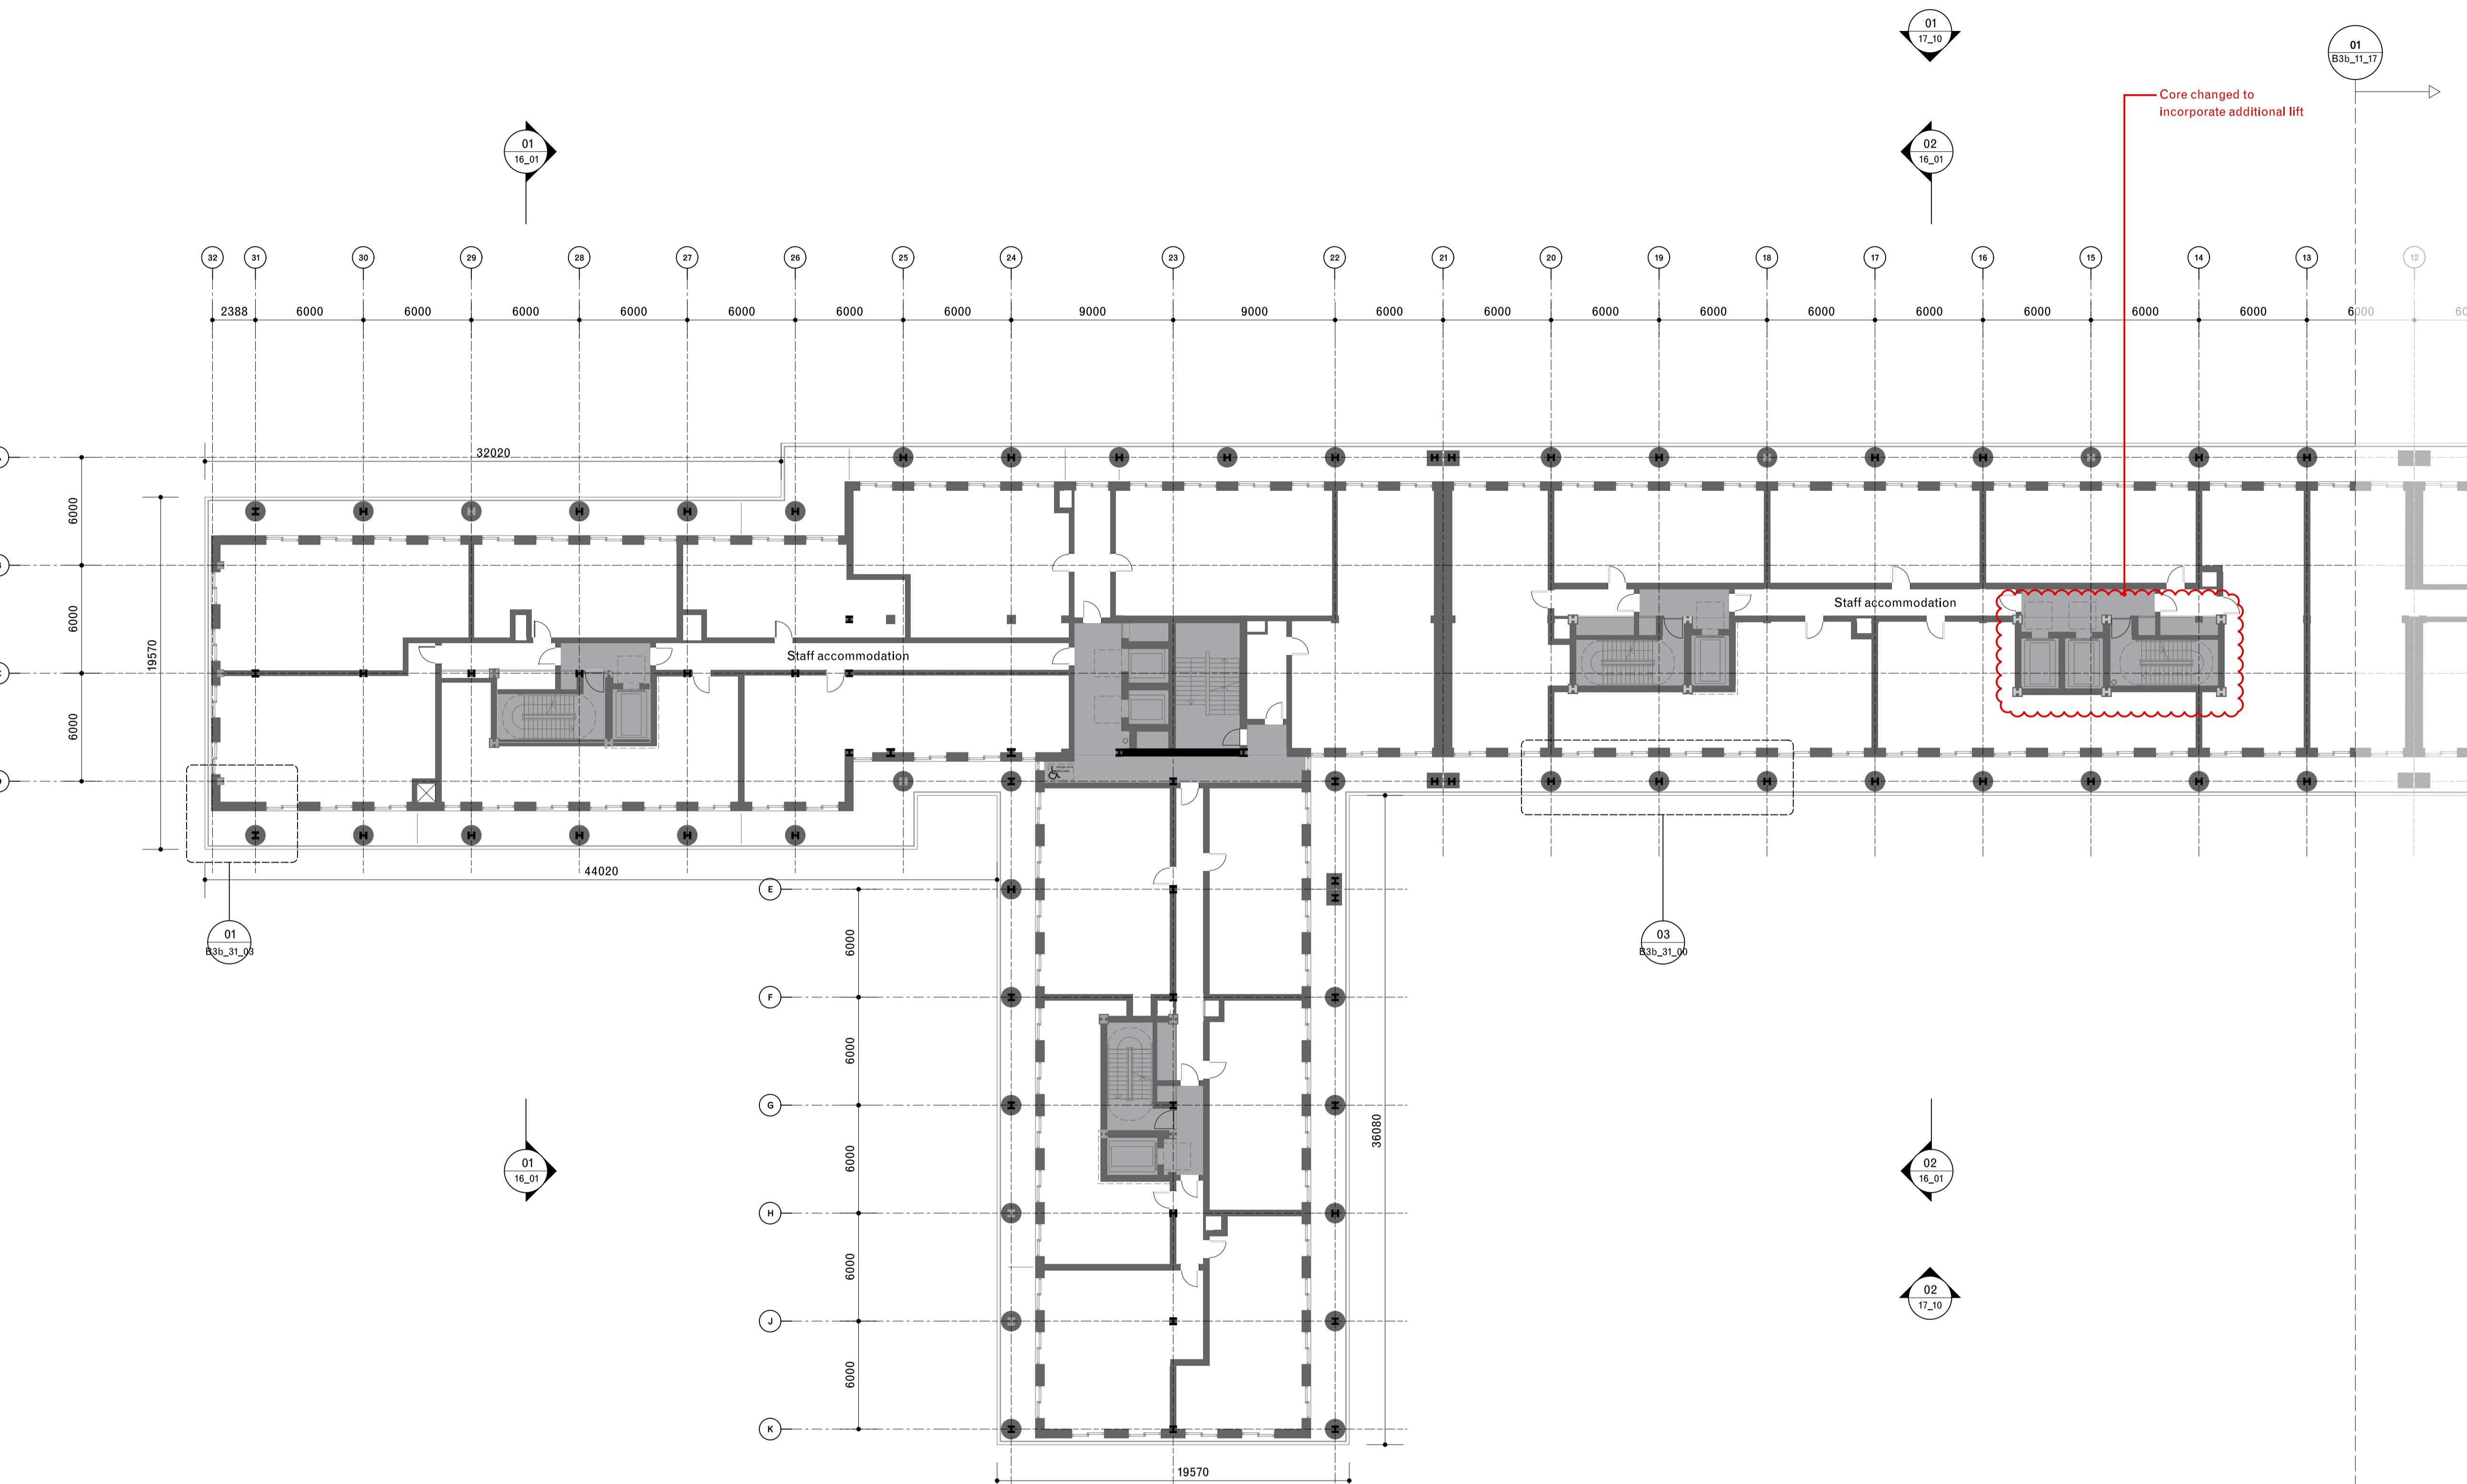


Note:  
Red line shows amendments made to the original 2021 application to ensure compliance with updated legislation, including the Building Safety Act 2022 and BS9991:2024, as presented at the Planning Inquiry.

General notes:  
Do not scale from drawings.  
Errors to be reported immediately to the Architect.  
To be read in conjunction with all relevant Architects', Services and Structural Engineers' drawings.  
All existing site, tree and building information has been compiled from different sources.  
All dimensions to be checked on site.

■ Existing  
■ Proposed  
■ Retained column  
■ New column

02 20/08/2025 Planning (addendum 3) MY GLA  
01 15/11/2024 Planning (addendum) YZ GLA  
Rev. Date Description Drawn Check

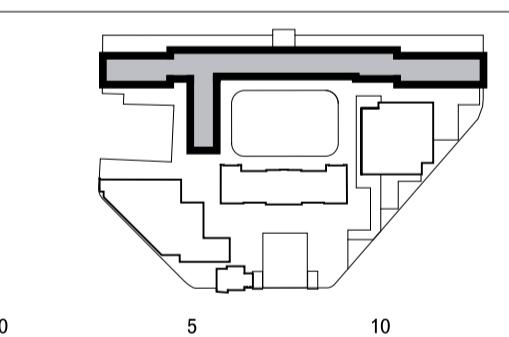

David Chipperfield Architects

C/O Fora, 9 Dillington Street  
London EC1V 8LW  
T +44 20 7829 4800  
www.davidchipperfield.com

Project Royal Mint Court  
Project number 1510

Client Chinese Embassy in the UK

© David Chipperfield Architects Ltd.

Planning (addendum)

Drawing number

Proposed third floor plan  
Embassy House  
North, sheet 1 of 2

Drawing name

Revision

Date

16/05/2024

Scale / Format

1:200 / A1

Drawn / Checked

THN / OU, GLA

Approved

BB

CAD Reference


1510\_A\_B3b\_1\_16.dgn

Planning

02

Planning



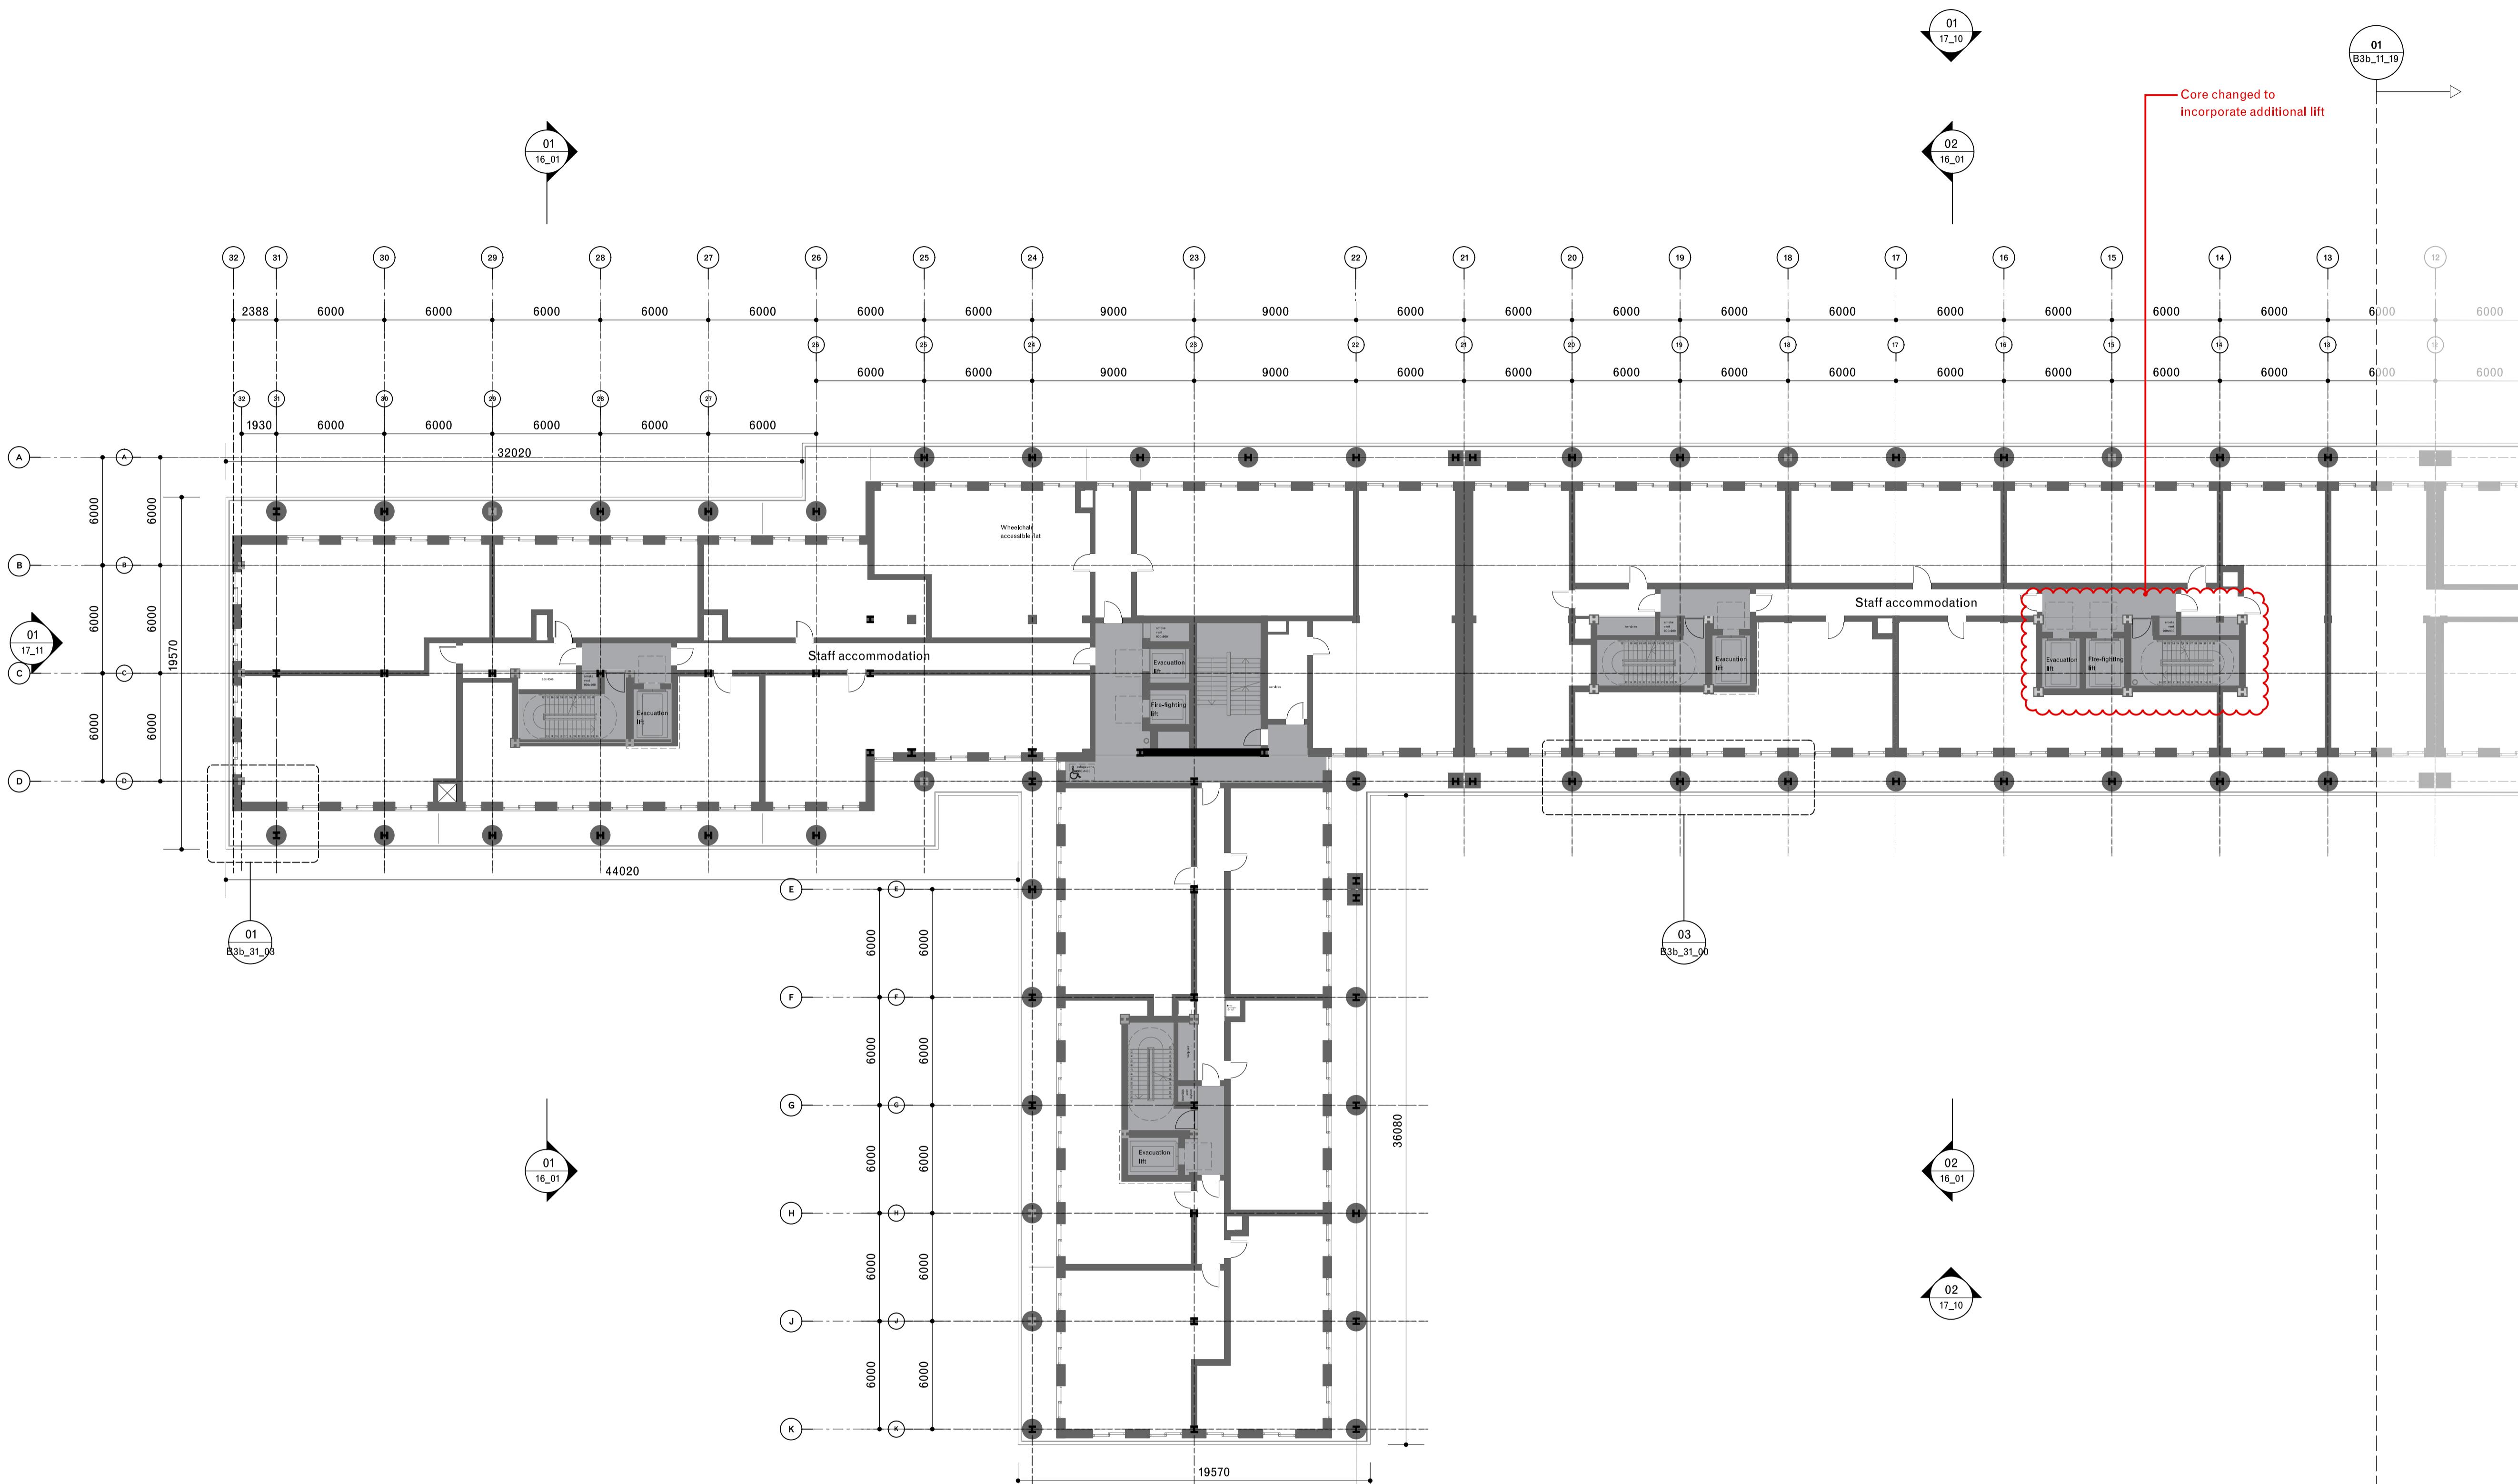


01  
Proposed Fourth Floor Plan, North  
Scale 1:200

Note:  
Red line shows amendments made to the original 2021 application to ensure compliance with updated legislation, including the Building Safety Act 2022 and BS9991:2024, as presented at the Planning Inquiry.

General notes:  
Do not scale from drawings.  
Errors to be reported immediately to the Architect.  
To be read in conjunction with all relevant Architects', Services and Structural Engineers' drawings.  
All existing site, tree and building information has been compiled from different sources.  
All dimensions to be checked on site.

02 20/08/2025 Planning (addendum 3) MY GLa  
01 15/11/2024 Planning (addendum) YZ GLa  
Rev. Date Description Drawn Check

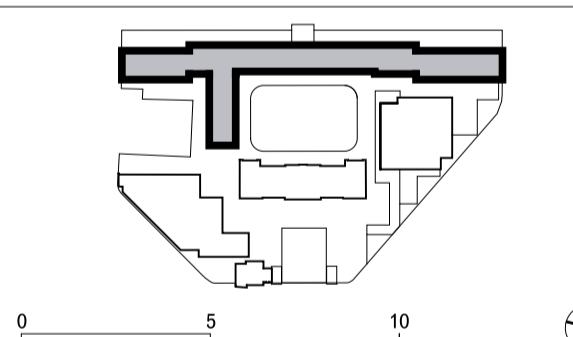

David Chipperfield Architects

C/O Fora, 9 Dillington Street  
London EC1V 8LW  
T +44 20 7829 4800  
www.davidchipperfield.com

Project Royal Mint Court  
Project number 1510

Client Chinese Embassy in the UK

© David Chipperfield Architects Ltd.

Planning (addendum)

Drawing name Drawing number


Proposed fourth floor plan  
Embassy House  
North, sheet 1 of 2

Revision 02

Date 16/05/2024  
Scale / Format 1:200 / A1  
Drawn / Checked THN / OU, GLa  
Approved BB  
CAD Reference 1510\_A\_B3b\_1\_18.dgn

Planning

02

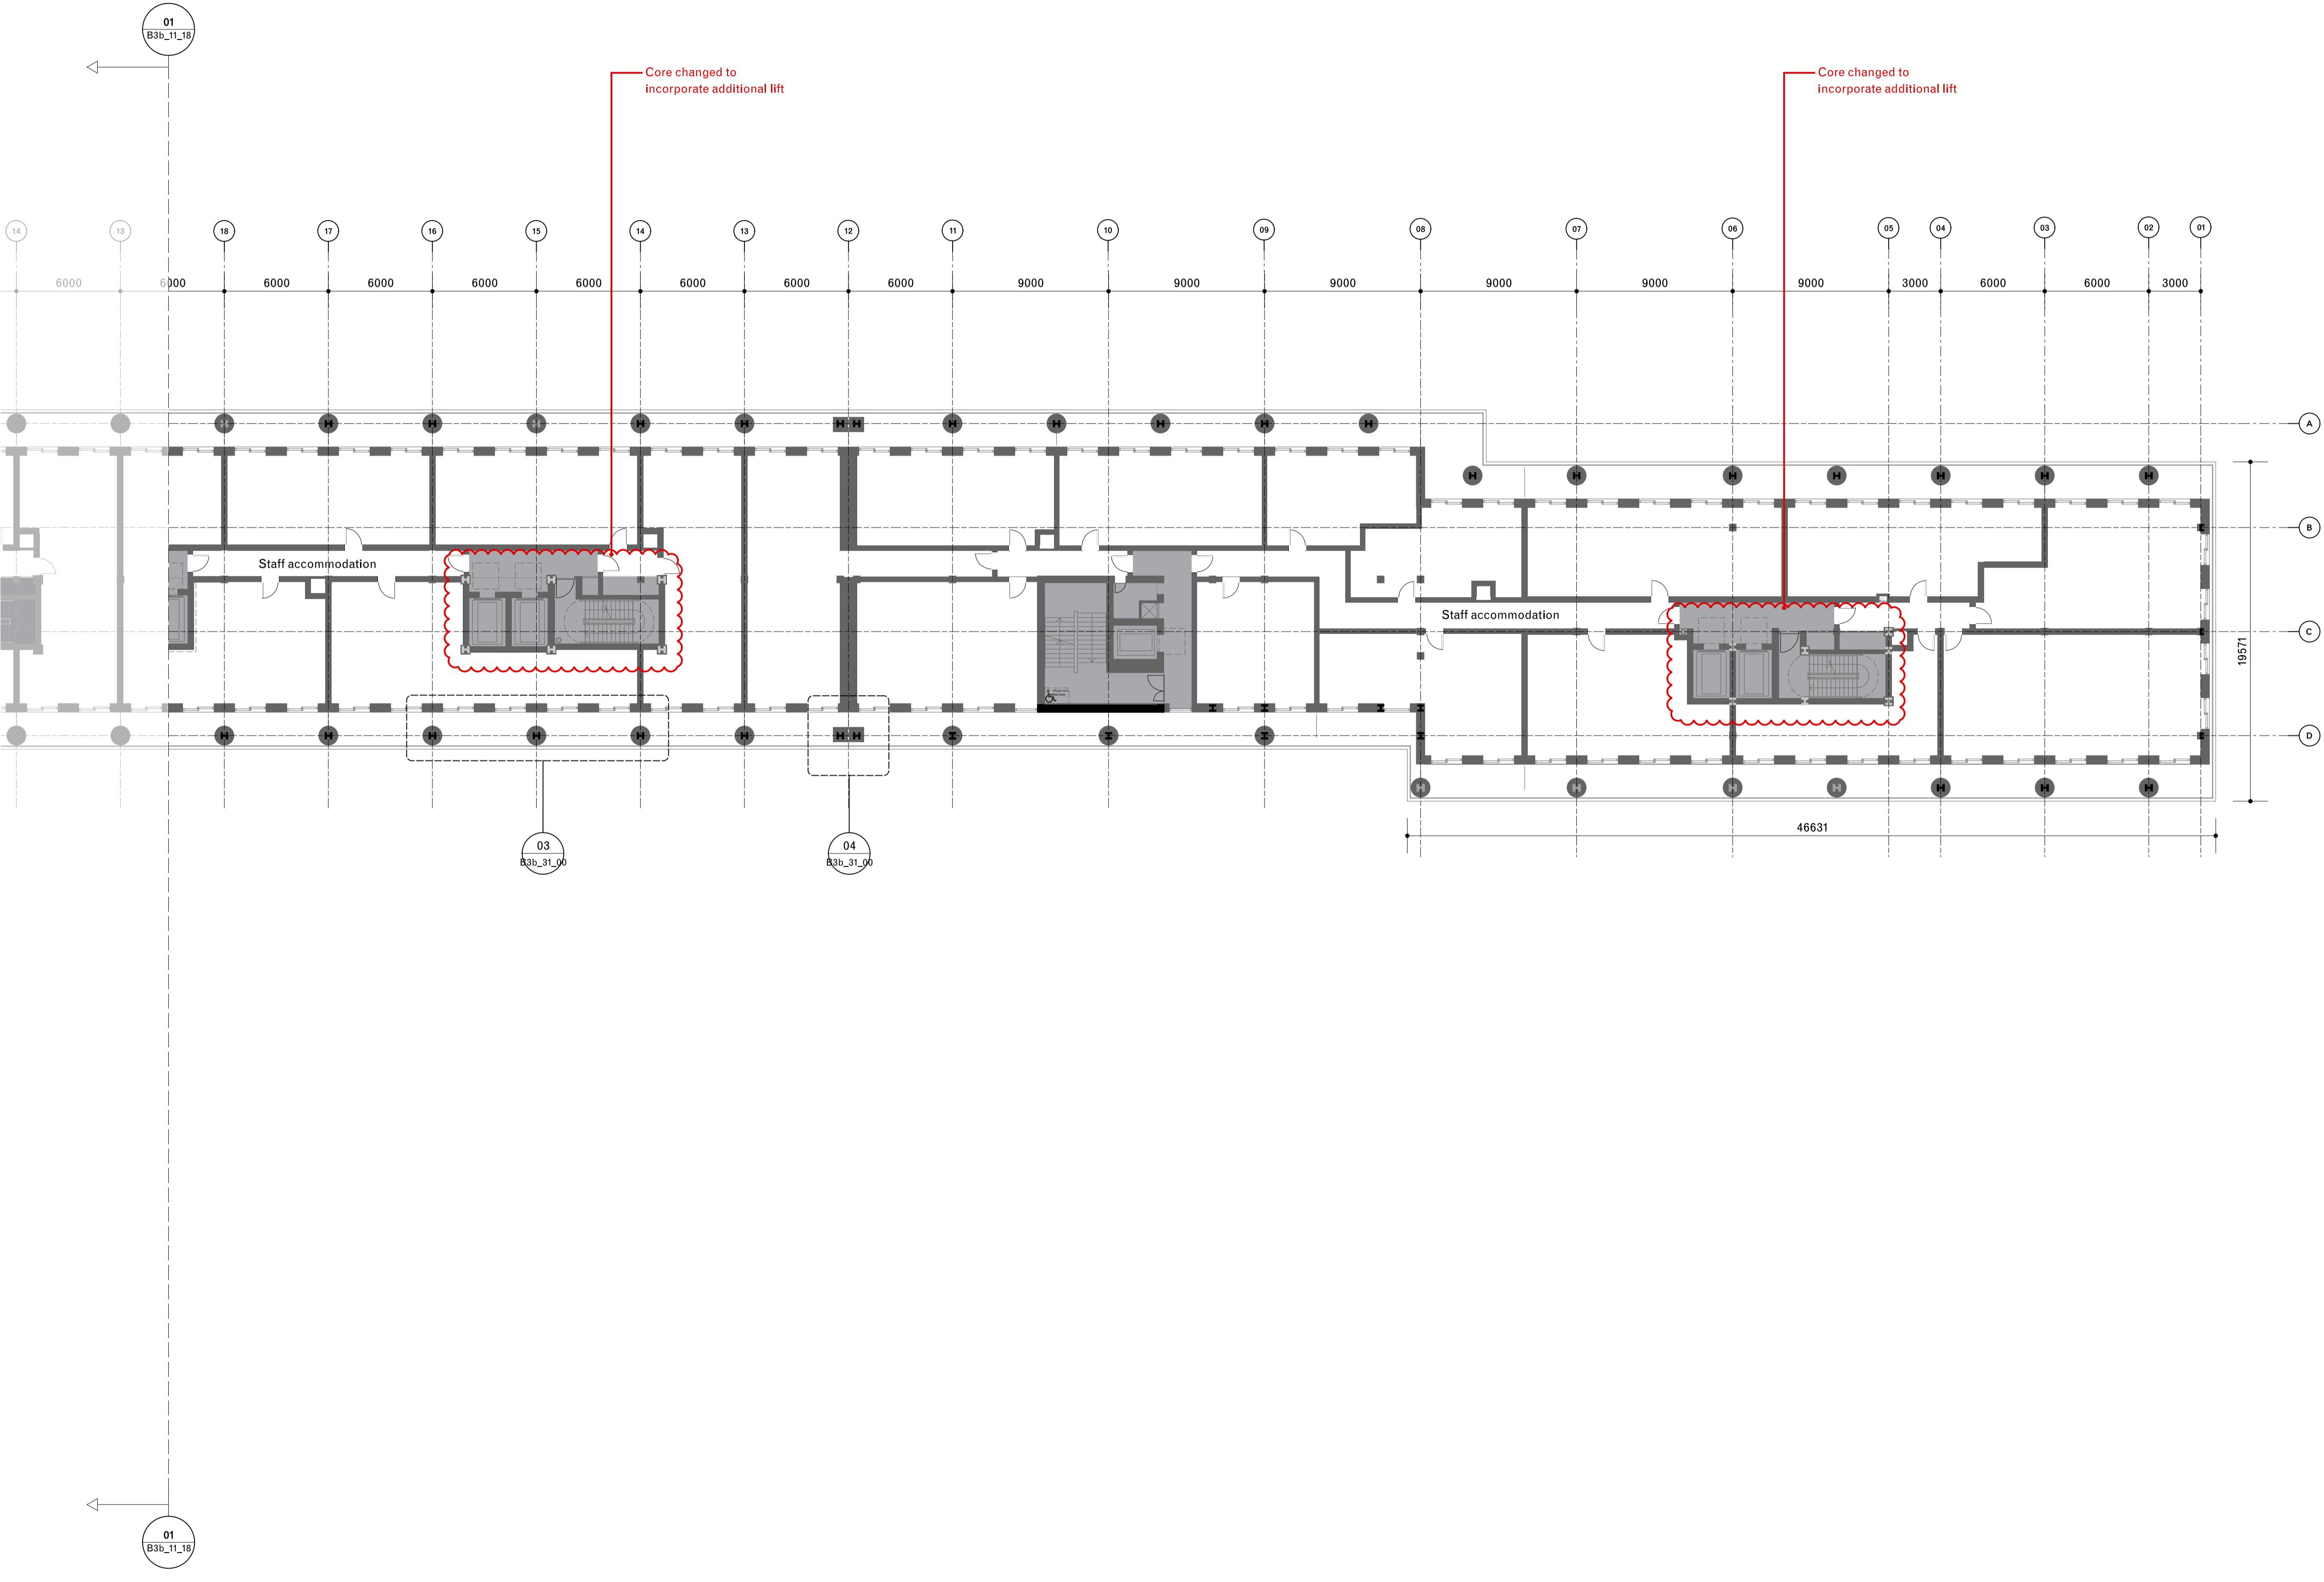


01  
Proposed Fourth Floor Plan, South  
Scale 1:200

Note:  
Red line shows amendments made to the original 2021  
application to ensure compliance with updated legislation,  
including the Building Safety Act 2022 and BS9991:2024, as  
presented at the Planning Inquiry.

General notes:  
Do not scale from drawings.  
Errors to be reported immediately to the Architect.  
To be read in conjunction with all relevant Architects',  
Services and Structural Engineers' drawings.  
All existing site, tree and building information has been compiled  
from different sources.  
All dimensions to be checked on site.

02 20/08/2025 Planning (addendum 3) MY GLa  
01 15/11/2024 Planning (addendum) YZ GLa  
Rev. Date Description Drawn Check

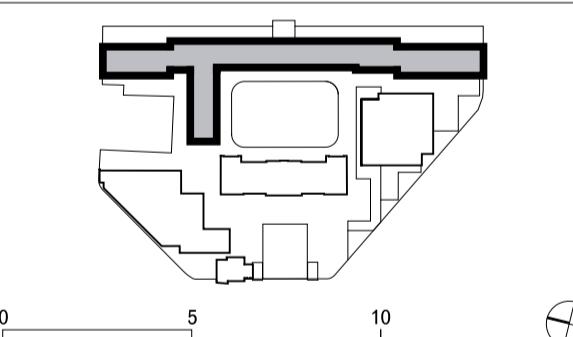

David Chipperfield Architects

C/O Fora, 9 Dillington Street  
London EC1V 8LW  
T +44 20 7829 4800  
www.davidchipperfield.com

Project Royal Mint Court  
Project number 1510

Client Chinese Embassy in the UK

© David Chipperfield Architects Ltd.

Planning (addendum)

Drawing name Drawing number


Proposed fourth floor plan  
Embassy House  
South, sheet 2 of 2

B3b\_11\_19

Date 16/05/2024  
Scale / Format 1:200 / A1  
Drawn / Checked THN / OU, GLa  
Approved BB  
CAD Reference 1510\_A\_B3b\_1\_19.dgn

Revision 02  
Planning



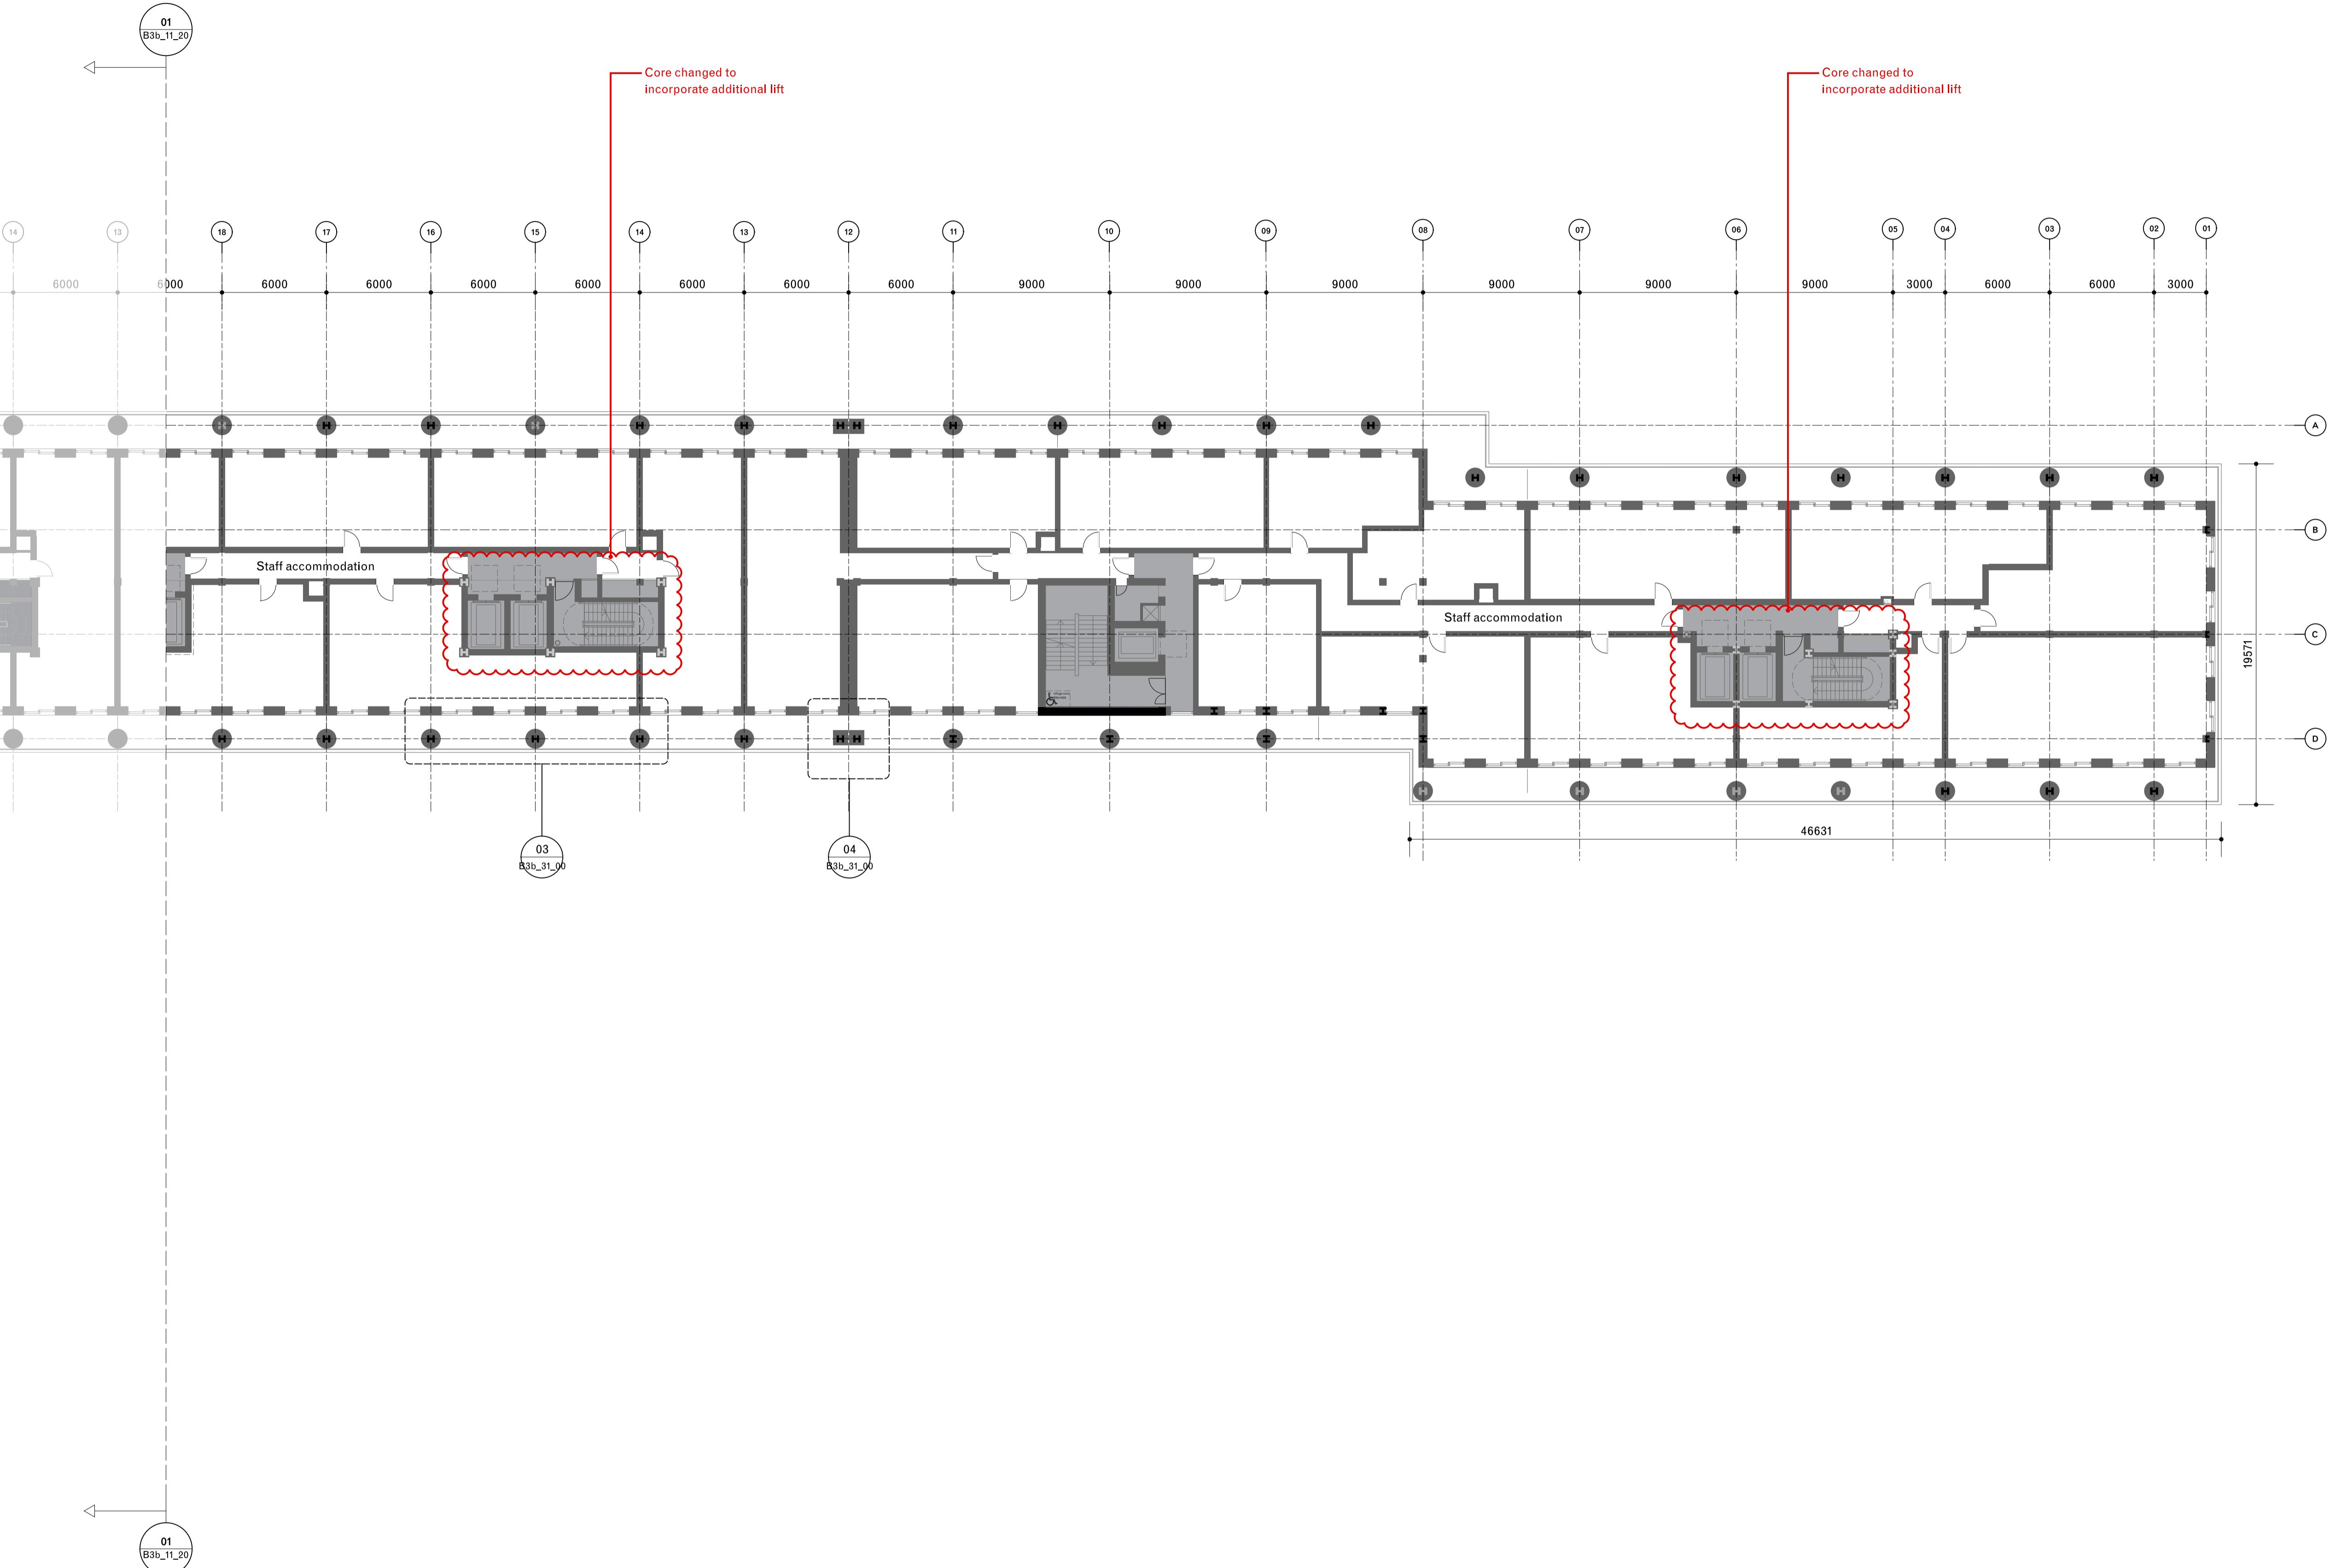


01 Proposed Fifth Floor Plan, South  
Scale 1:200

Note:  
Red line shows amendments made to the original 2021 application to ensure compliance with updated legislation, including the Building Safety Act 2022 and BS9991:2024, as presented at the Planning Inquiry.

General notes:  
Do not scale from drawings.  
Errors to be reported immediately to the Architect.  
To be read in conjunction with all relevant Architects', Services and Structural Engineers' drawings.  
All existing site, tree and building information has been compiled from different sources.  
All dimensions to be checked on site.

02 20/08/2025 Planning (addendum 3) MY GLa  
01 15/11/2024 Planning (addendum) YZ GLa  
Rev. Date Description Drawn Check

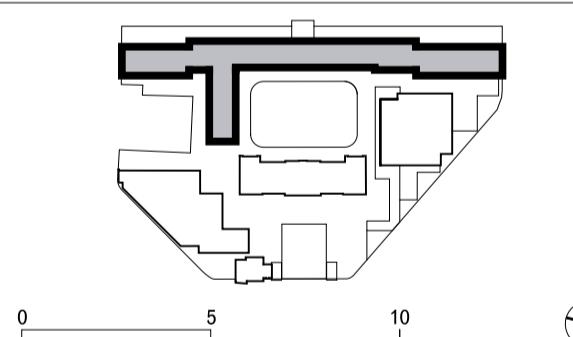

David Chipperfield Architects

C/O Fora, 9 Dillington Street  
London EC1V 8LW  
T +44 20 7829 4800  
www.davidchipperfield.com

Project Royal Mint Court  
Project number 1510

Client Chinese Embassy in the UK


© David Chipperfield Architects Ltd.

Planning (addendum)

Drawing name Proposed fifth floor plan  
Drawing number B3b\_11\_21

Date 16/05/2024  
Scale / Format 1:200 / A1  
Drawn / Checked THN / OU, GLa  
Approved BB  
CAD Reference 1510\_A\_B3b\_1\_21.dgn

Revision 02  
Planning

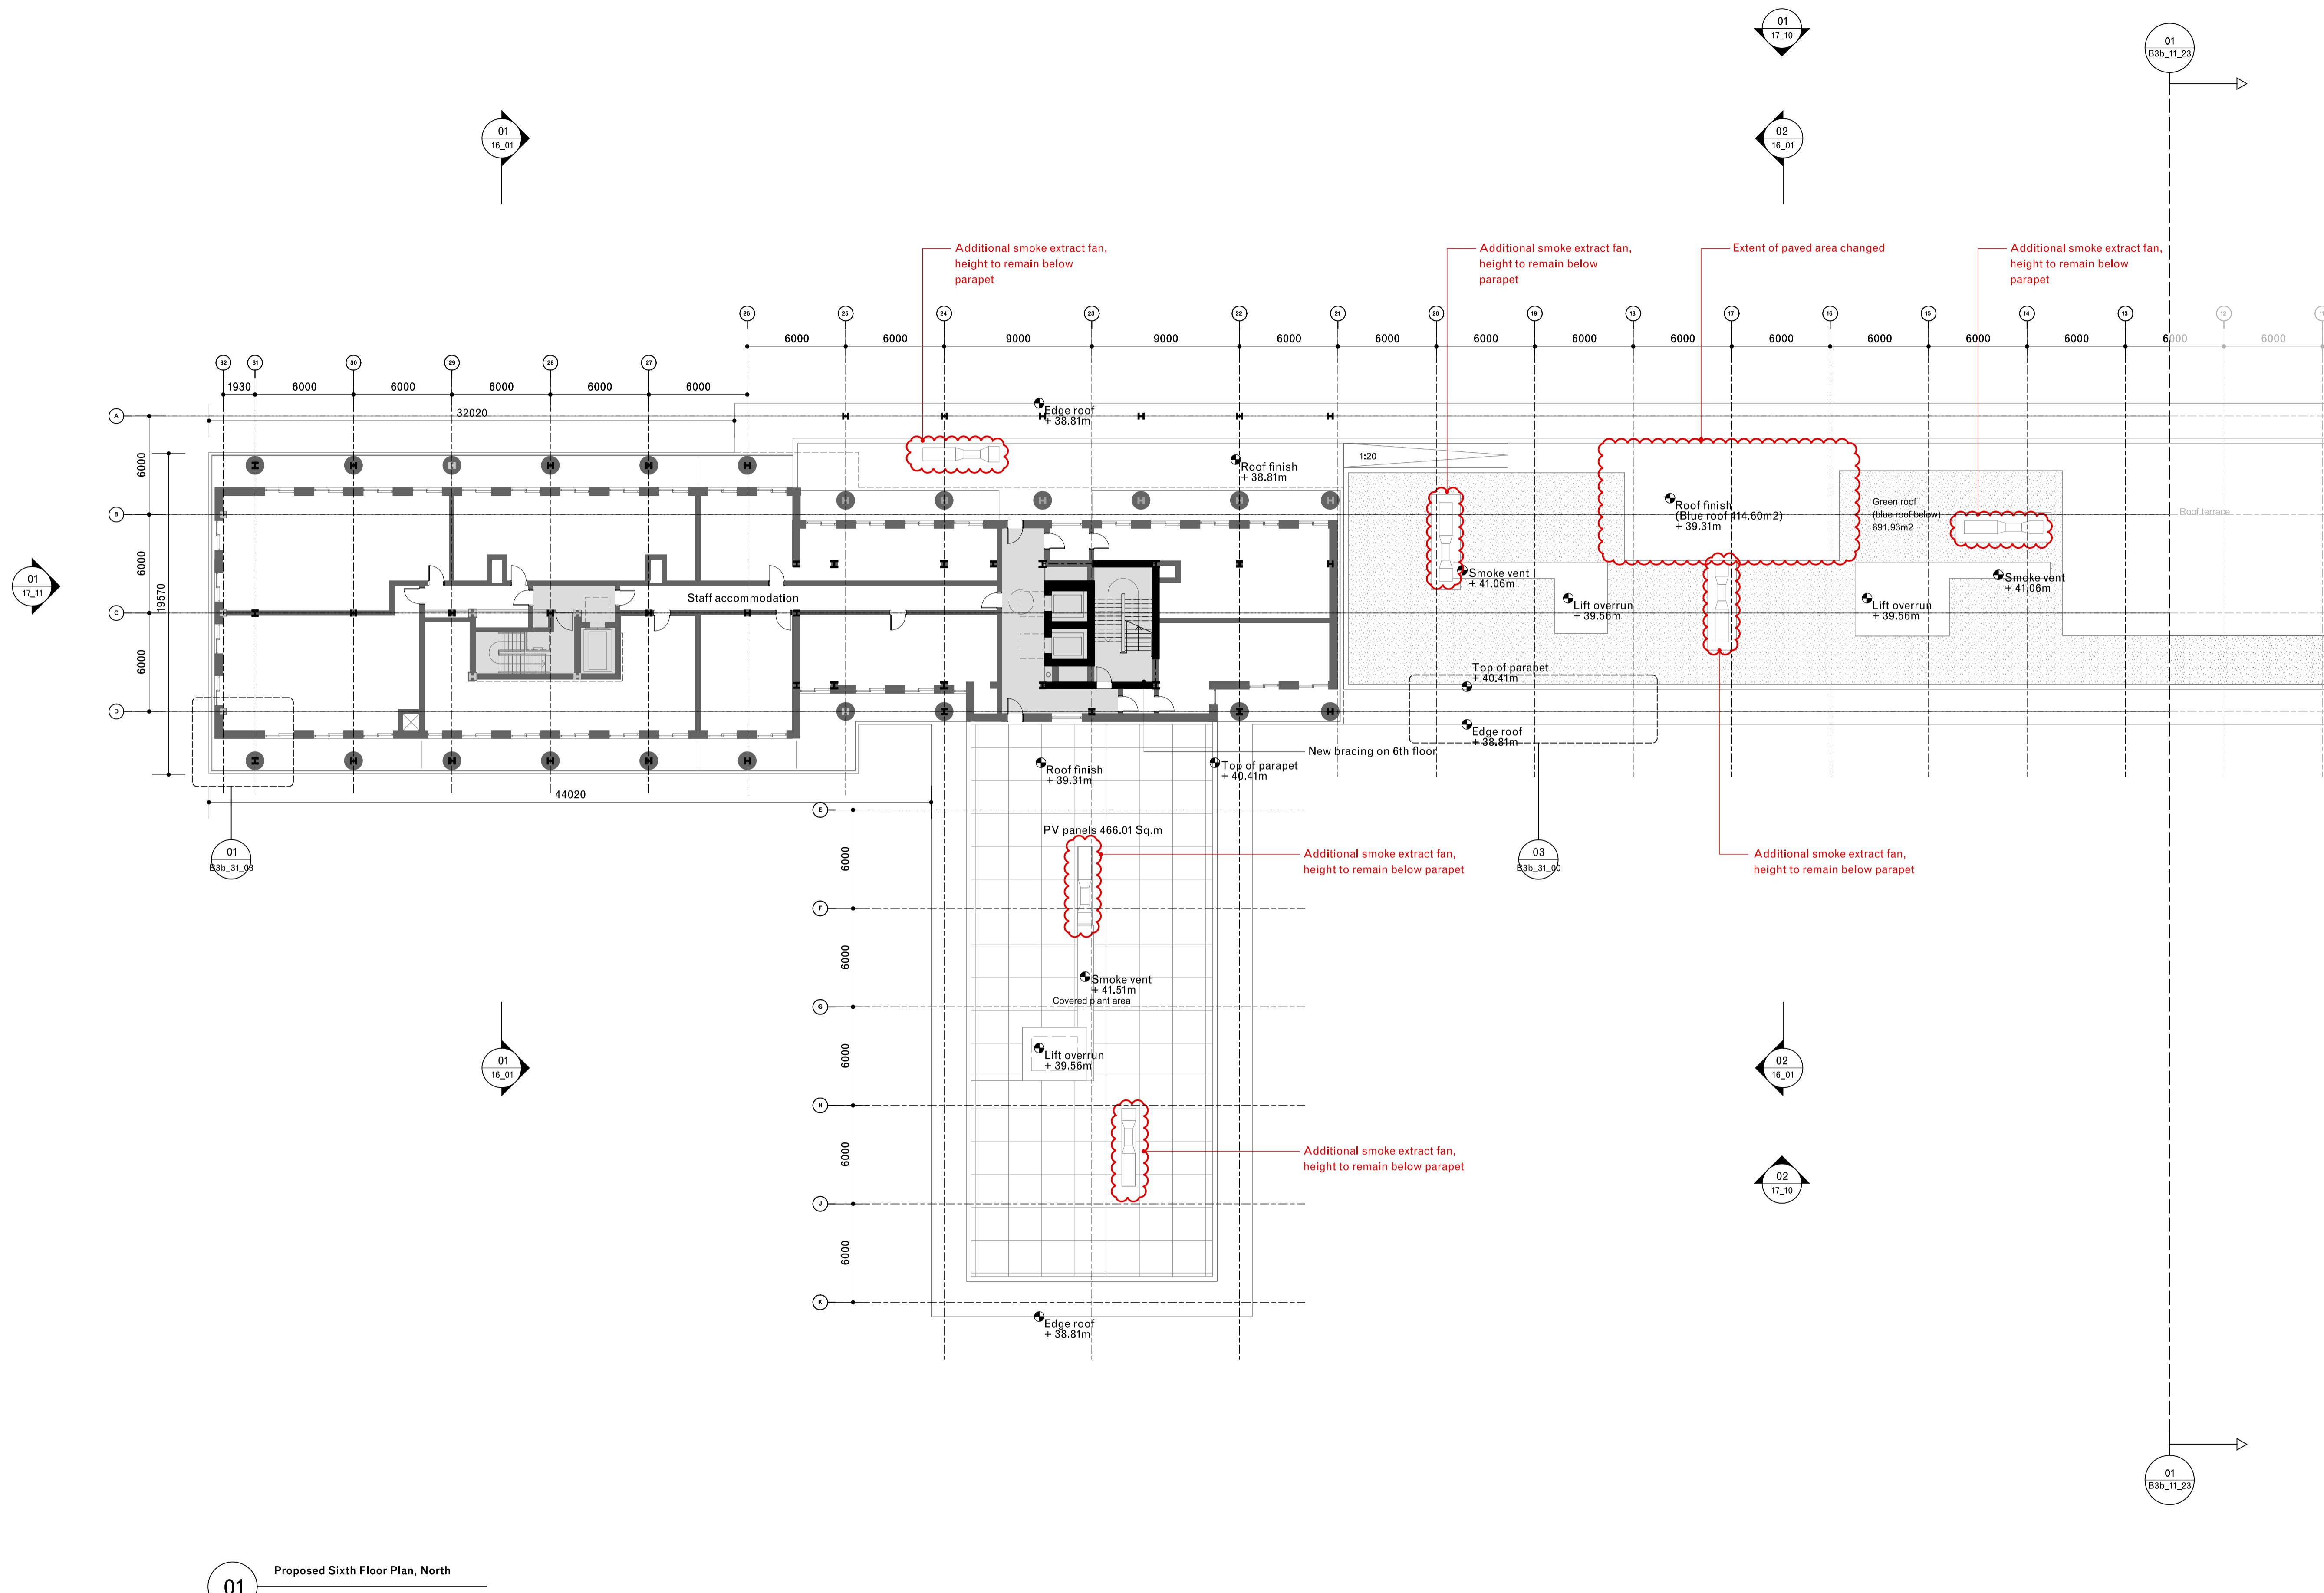

01 Proposed Sixth Floor Plan, North

**Note:**  
Red line shows amendments made to the original 2021 application to ensure compliance with updated legislation, including the Building Safety Act 2022 and BS9991:2024, as presented at the Planning Inquiry.

General notes:

- Do not scale from drawings.
- Errors to be reported immediately to the Architect.
- To be read in conjunction with all relevant Architects', Services and Structural Engineers' drawings.
- All existing site, tree and building information has been compiled from different sources.
- All dimensions to be checked on site.

03	20/08/2025	Planning (addendum 3)	MY	GLa
02	31/01/2025	Planning (addendum 2)	MY	GLa
01	15/11/2024	Planning (addendum)	YZ	GLa

David Chipperfield Architects

C/O Fora, 9 Dallington Street  
London EC1V 0LN  
T +44 20 7620 4800  
[www.davidchipperfield.com](http://www.davidchipperfield.com)

Project Royal Mint Court Project number 1510

# Client **Chinese Embassy in the UK**

## Planning (addendum)

**Proposed sixth floor plan** **Rev. 11-6**

**Proposed sixth floor plan  
Embassy House**

North, sheet 1 of 2

---

Date 16/05/2024 Revision  
Scale / Format 1:200 / A1 03


Drawn / Checked **THN / OU, GLa** Planning  
Approved **BB**

CAD Reference 1510\_A\_B3b\_11\_22.dgn

Revision  
**03**

## Planning

lgn

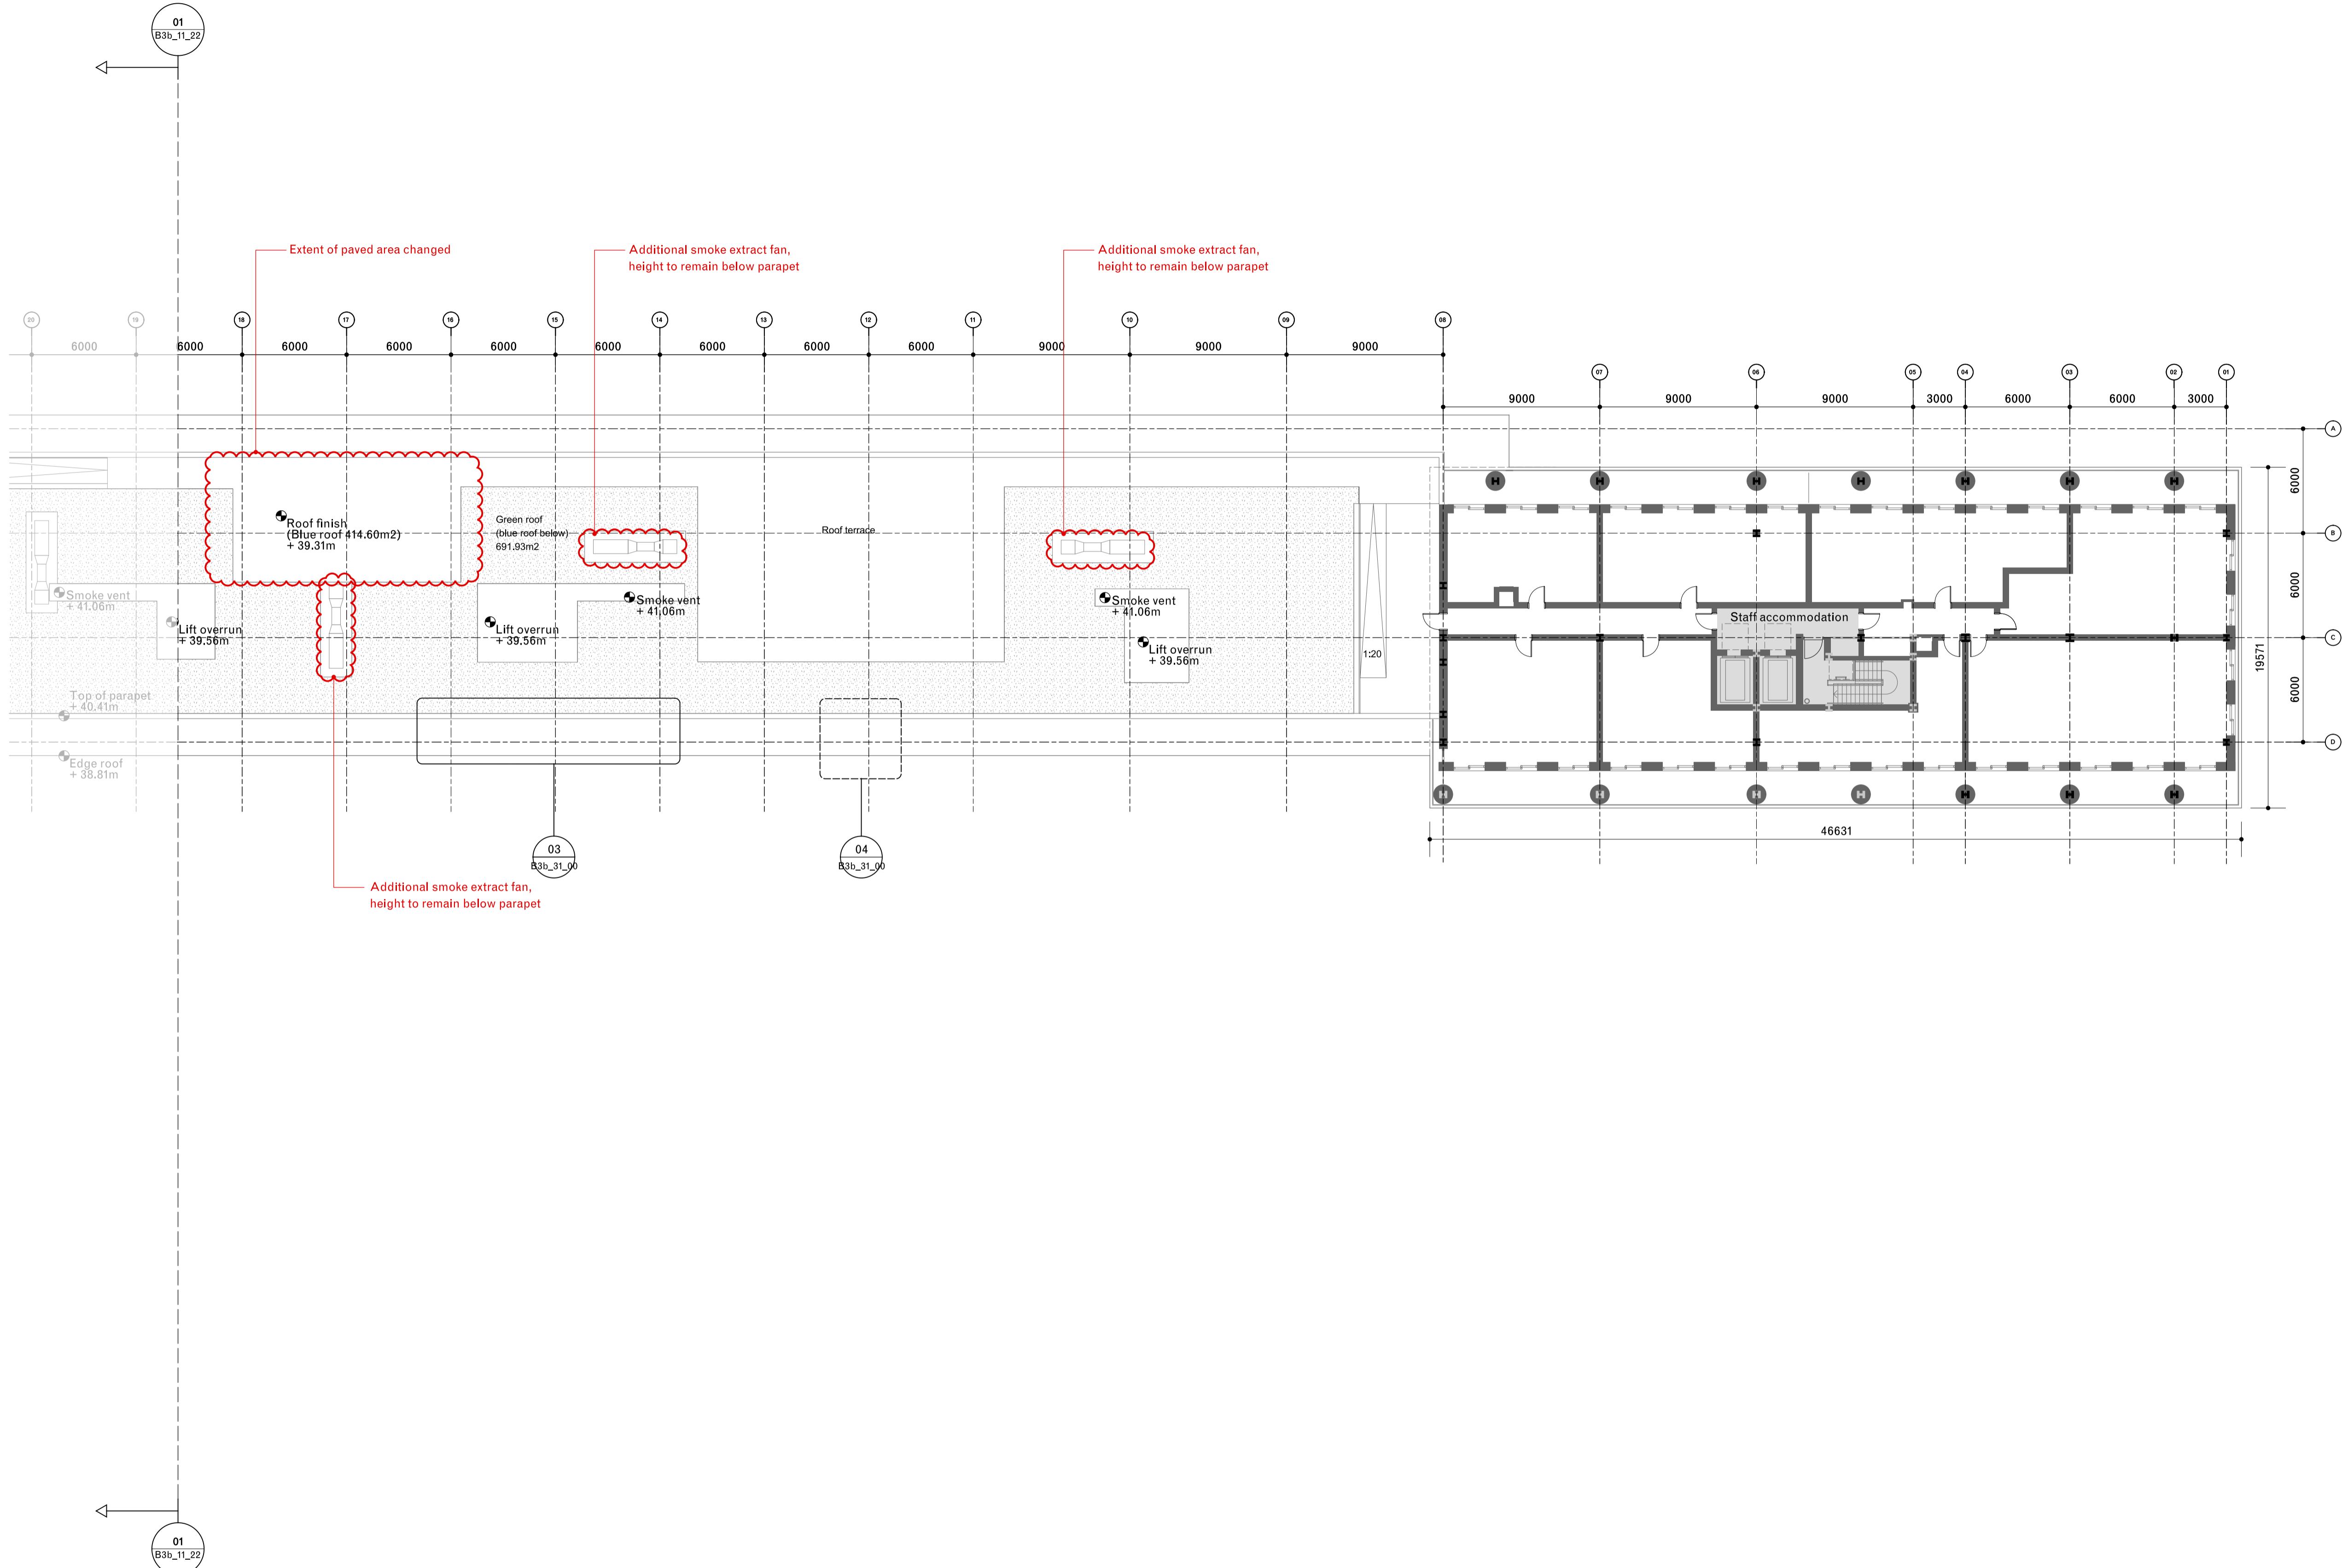


**Note:**  
Red line shows amendments made to the original 2021 application to ensure compliance with updated legislation, including the Building Safety Act 2022 and BS9991:2024, as presented at the Planning Inquiry.

General notes:

- Do not scale from drawings.
- Errors to be reported immediately to the Architect.
- To be read in conjunction with all relevant Architects', Services and Structural Engineers' drawings.
- All existing site, tree and building information has been compiled from different sources.
- All dimensions to be checked on site.

 Existing  
 Proposed  
 Retained column  
 New column

03	20/08/2025	Planning (addendum 3)	MY	GLa
02	31/01/2025	Planning (addendum 2)	MY	GLa
01	15/11/2024	Planning (addendum)	YZ	GLa

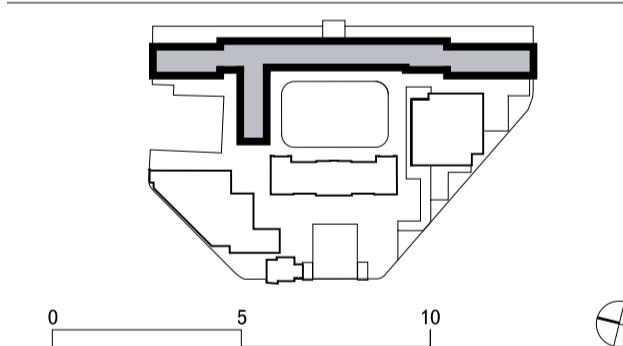

---

David Chipperfield Architects

C/O Fora, 9 Dallington Street  
London EC1V 0LN  
T +44 20 7620 4800  
[www.davidchipperfield.com](http://www.davidchipperfield.com)

# Project Royal Mint Court 1


---

## Client

## Planning (addendum)

Drawing Name	Drawing Number	
<b>Proposed sixth floor plan</b>	<b>B3b_11_2</b>	
<b>Embassy House</b>		
<b>South, sheet 2 of 2</b>		
<hr/>		
Date	16/05/2024	Revision
Scale / Format	1:200 / A1	03
Drawn / Checked	THN / OU, GLa	Planning
Approved	BB	
CAD Reference	1510_A_B3b_11_23.dgn	



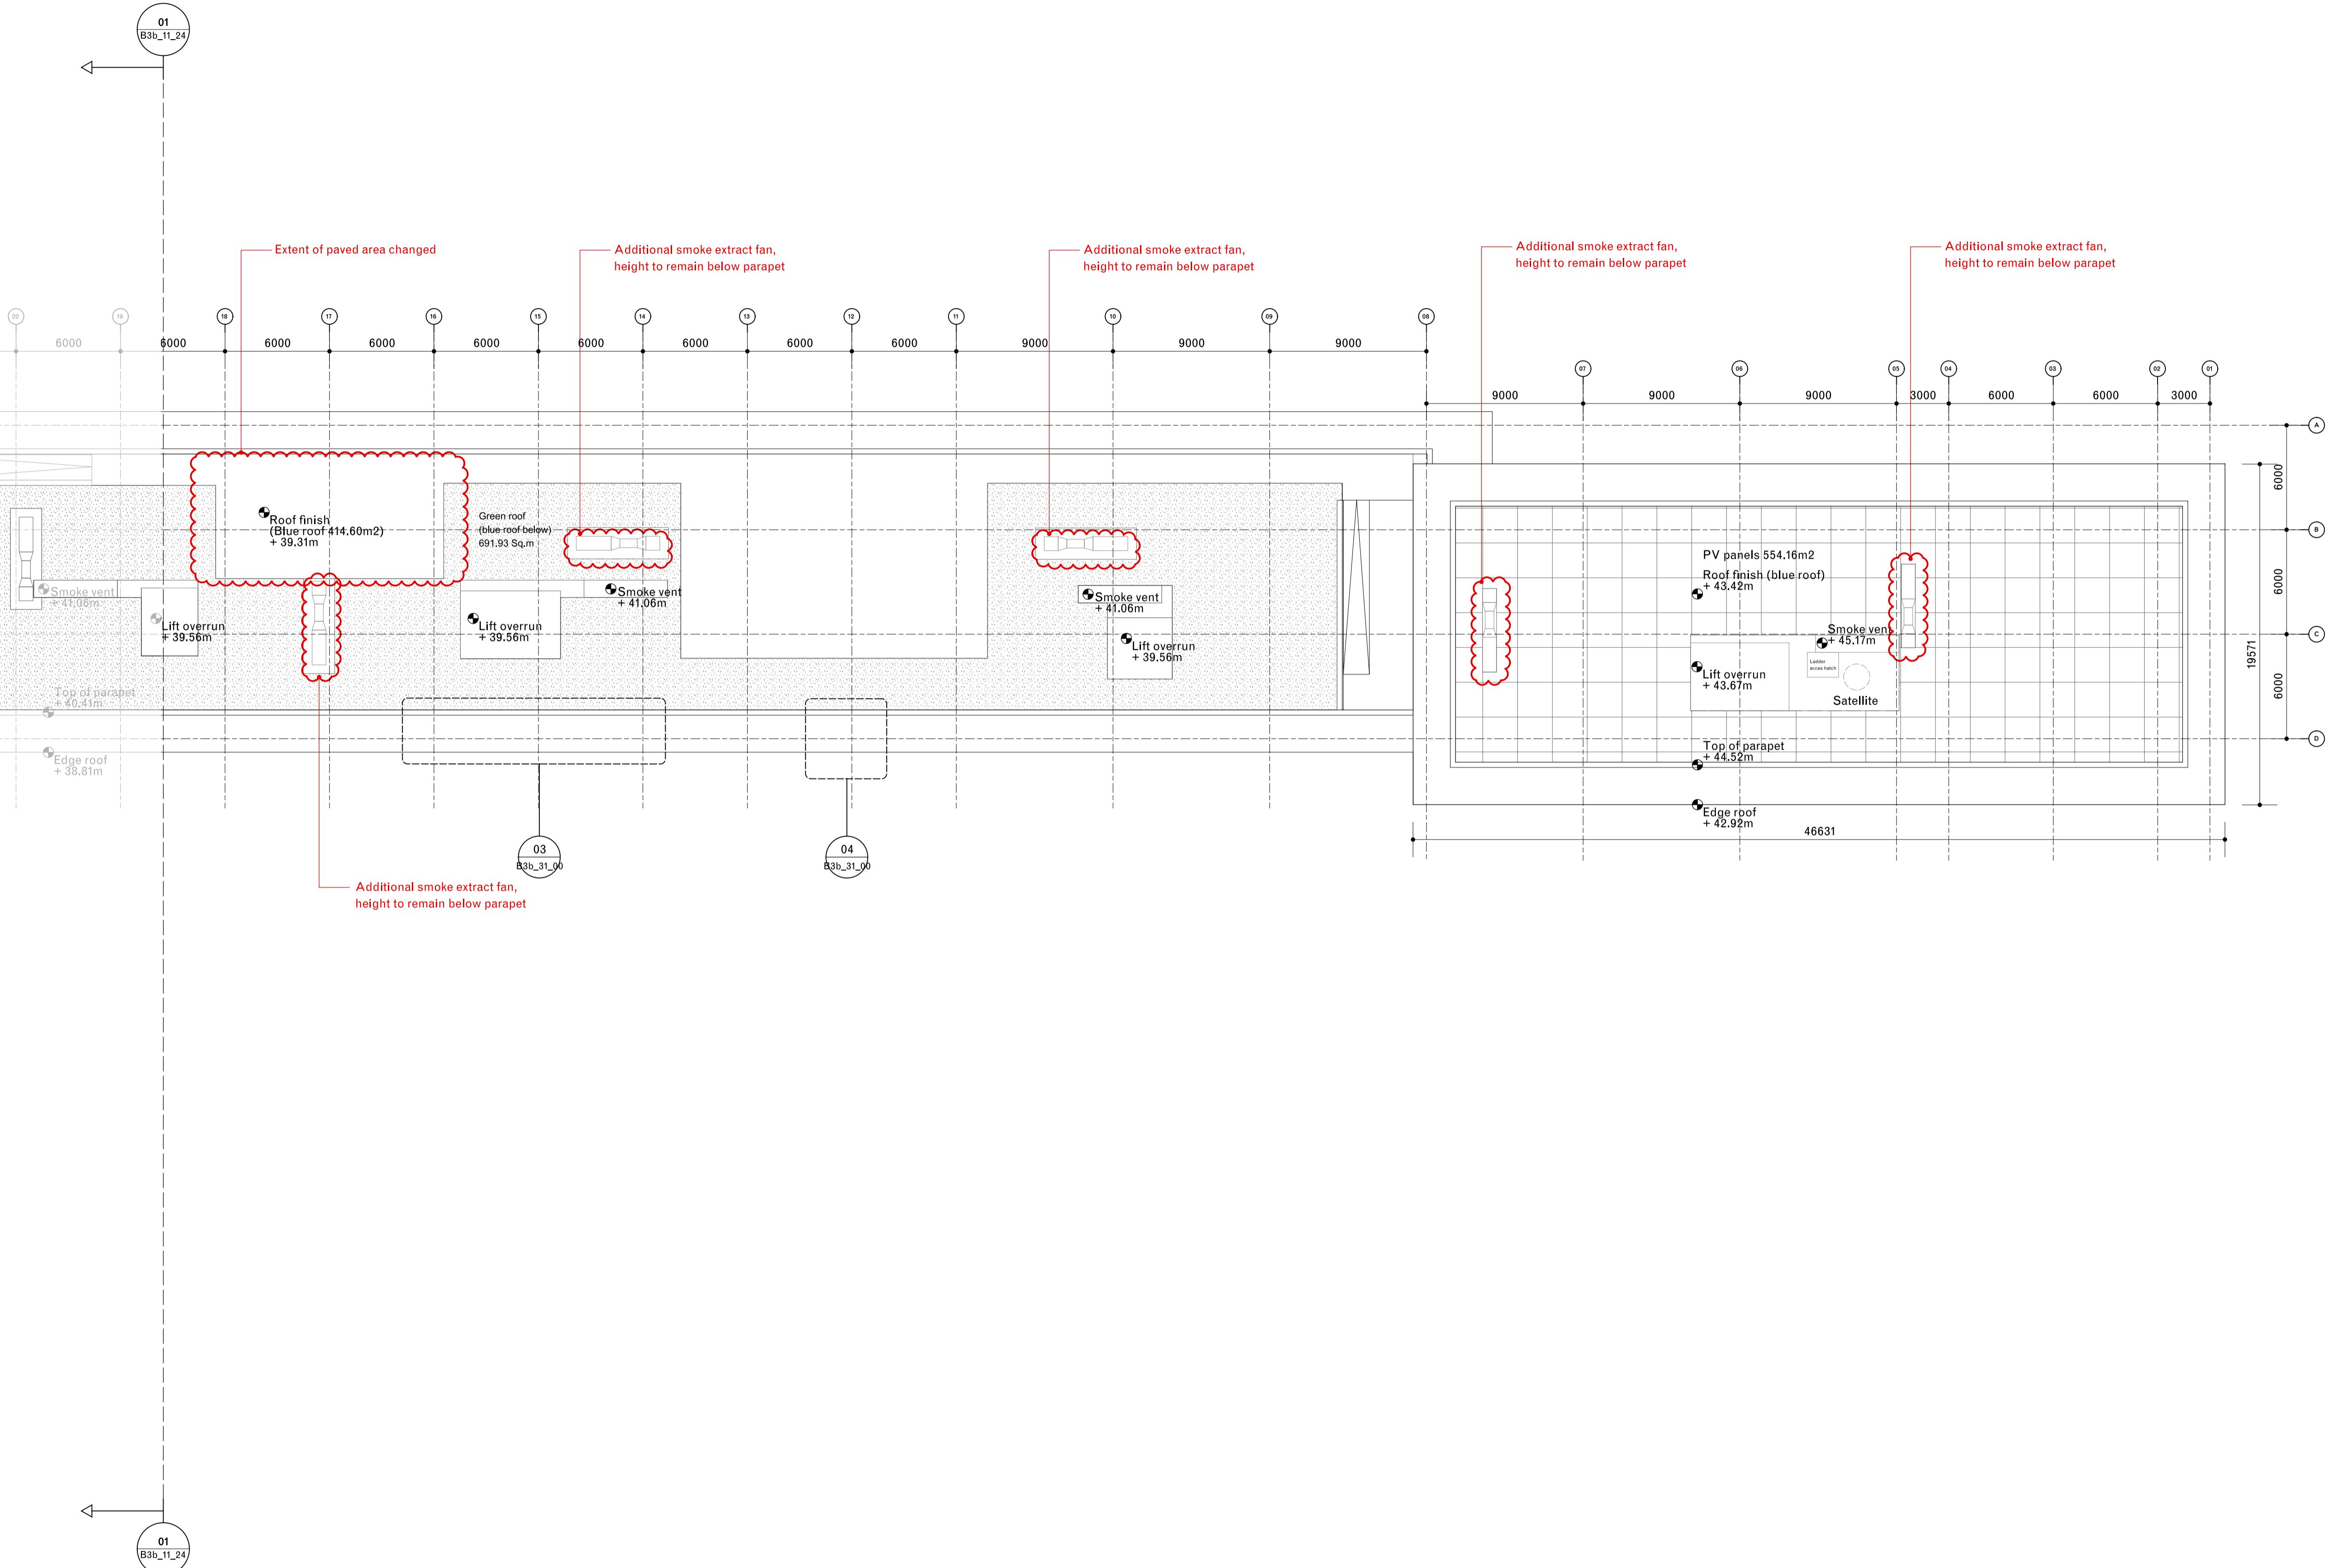


Note:  
Red line shows amendments made to the original 2021 application to ensure compliance with updated legislation, including the Building Safety Act 2022 and BS9991:2024, as presented at the Planning Inquiry.

General notes:  
Do not scale from drawings.  
Errors to be reported immediately to the Architect.  
To be read in conjunction with all relevant Architects', Services and Structural Engineers' drawings.  
All existing site, tree and building information has been compiled from different sources.  
All dimensions to be checked on site.

Existing  
Proposed  
Retained column  
New column

03 20/08/2025 Planning (addendum 3) MY GLa  
02 31/01/2025 Planning (addendum 2) MY GLa  
01 15/11/2024 Planning (addendum) YZ GLa  
Rev. Date Description Drawn Check

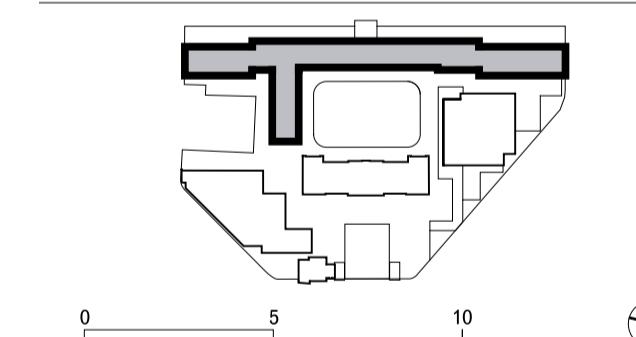

David Chipperfield Architects

C/O Fora, 9 Dillington Street  
London EC1V 8LW  
T +44 20 7829 4800  
www.davidchipperfield.com

Project Royal Mint Court  
Project number 1510

Client Chinese Embassy in the UK


Planning (addendum)  
Drawing name Proposed seventh floor plan  
Drawing number B3b\_11\_25  
Date 16/05/2024  
Scale / Format 1:200 / A1  
Drawn / Checked YZ / OU, GLa  
Approved BB  
CAD Reference 1510\_A\_B3b\_11\_25.dgn

01 Proposed Seventh Floor Plan  
Scale 1:200

01 B3b\_11\_24

16/05/2024  
1:200 / A1  
YZ / OU, GLa  
BB  
Planning  
03



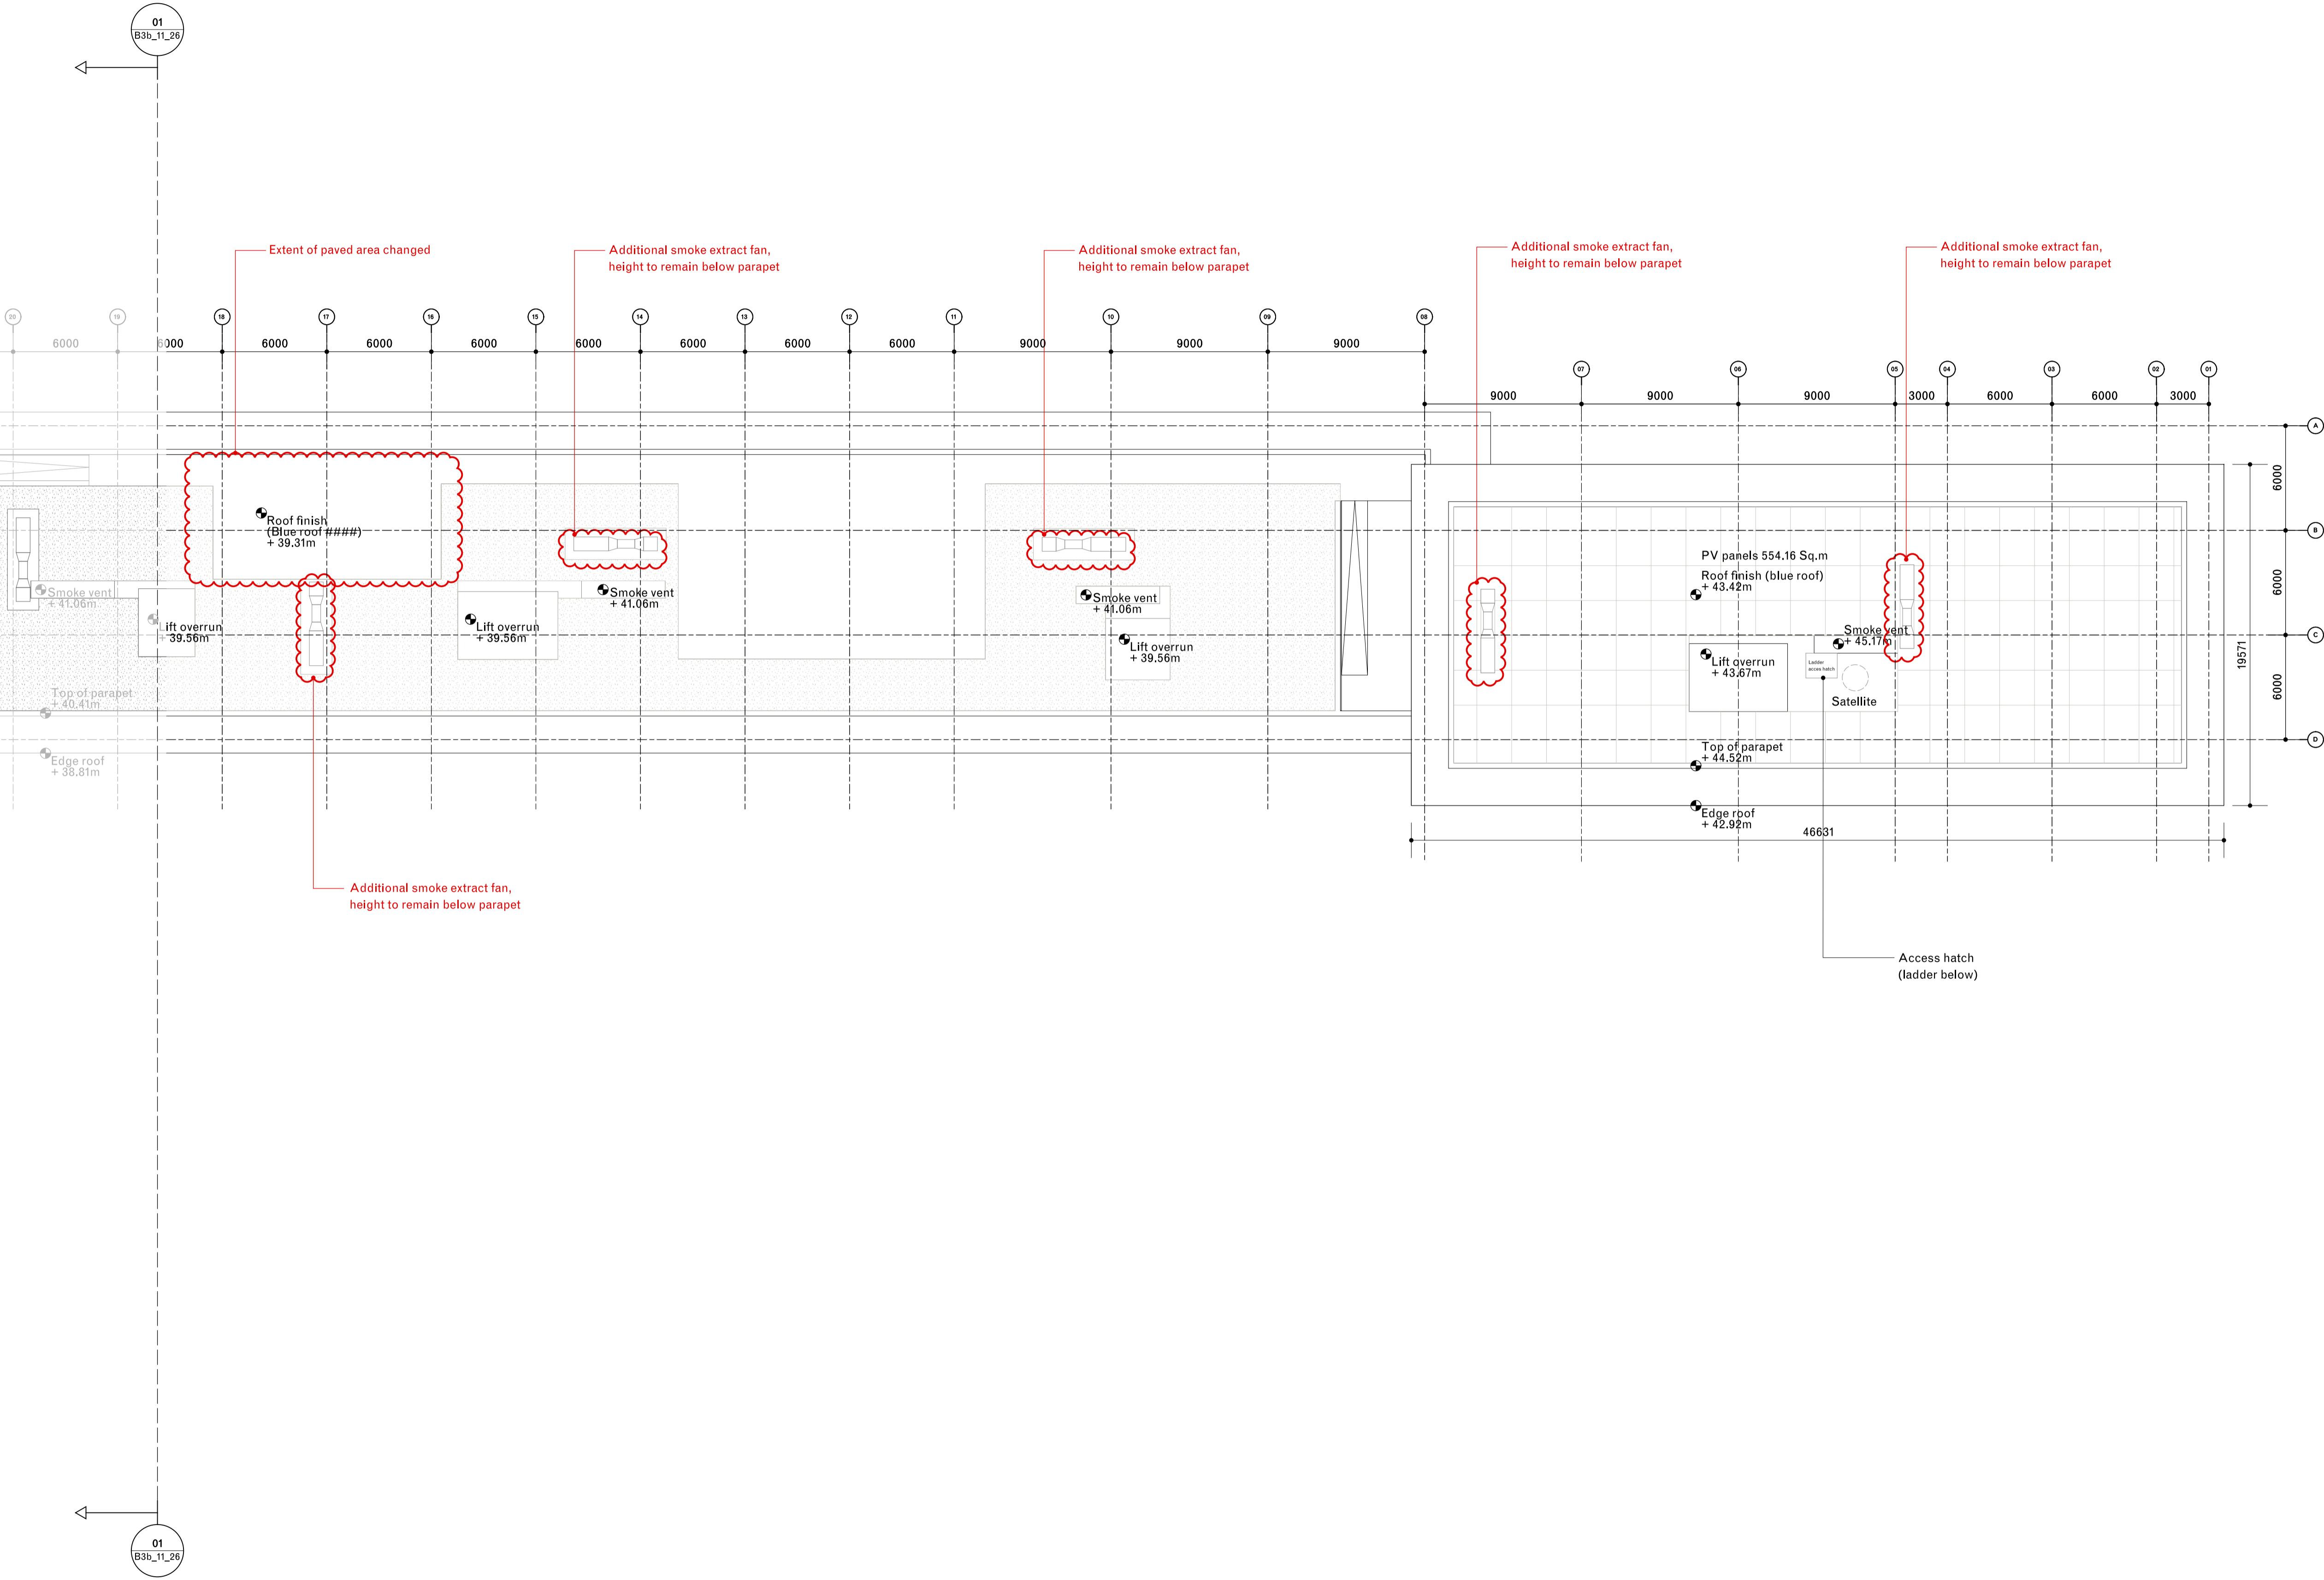


Note:  
Red line shows amendments made to the original 2021 application to ensure compliance with updated legislation, including the Building Safety Act 2022 and BS9991:2024, as presented at the Planning Inquiry.

General notes:  
Do not scale from drawings.  
Errors to be reported immediately to the Architect.  
To be read in conjunction with all relevant Architects', Services and Structural Engineers' drawings.  
All existing site, tree and building information has been compiled from different sources.  
All dimensions to be checked on site.

Existing  
Proposed

03 20/08/2025 Planning (addendum 3) MY GLa  
02 31/01/2025 Planning (addendum 2) MY GLa  
01 15/11/2024 Planning (addendum) YZ GLa  
Rev. Date Description Drawn Check

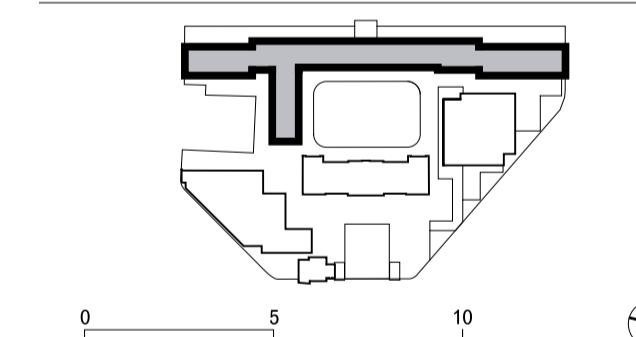

David Chipperfield Architects

C/O Fora, 9 Dillington Street  
London EC1V 8LW  
T +44 20 7829 4800  
www.davidchipperfield.com

Project Royal Mint Court  
Project number 1510

Client Chinese Embassy in the UK

Planning (addendum)  
Drawing name Proposed roof plan  
Drawing number Embassy House  
South, sheet 2 of 2  
Date 16/05/2024  
Scale / Format 1:200 / A1  
Drawn / Checked RPI / OU, GLa  
Approved BB  
CAD Reference 1510\_A\_B3b\_11\_27.dgn  
Revision 03  
Planning


© David Chipperfield Architects Ltd.

Planning


03

Planning

03

 

01 16/11/2024 Planning (addendum) YZ GLA  
Rev. Date Description Drawn Checked  
16/05/2024 1:200 A0  
16/05/2024 1:200 A0  
Approved B4  
CAD Reference 1510\_a\_b4\_11\_09.dgn

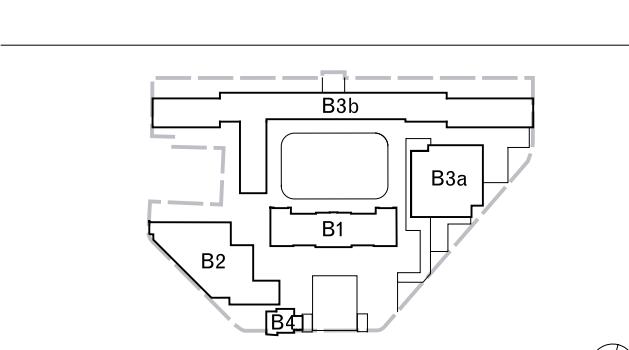

David Chipperfield Architects

© David Chipperfield Architects Ltd.  
CIO Fora, 9 Dallington Street  
London EC1V 9DZ  
T +44 20 7629 8800  
www.davidchipperfield.com

Project Royal Mint Court Project number 1510

Client Chinese Embassy in the UK

Planning (addendum)

Drawing name Proposed basement plan Drawing number Masterplan B4-11\_09

Date 16/05/2024  
Scale / Format 1:200 A0  
Drawn / Checked YZ GLA  
Approved B4  
CAD Reference 1510\_a\_b4\_11\_09.dgn

